SAVANNA AT CASTLE ROCK RANCH 5TH ADDITION

TO SEDGWICK COUNTY, KANSAS

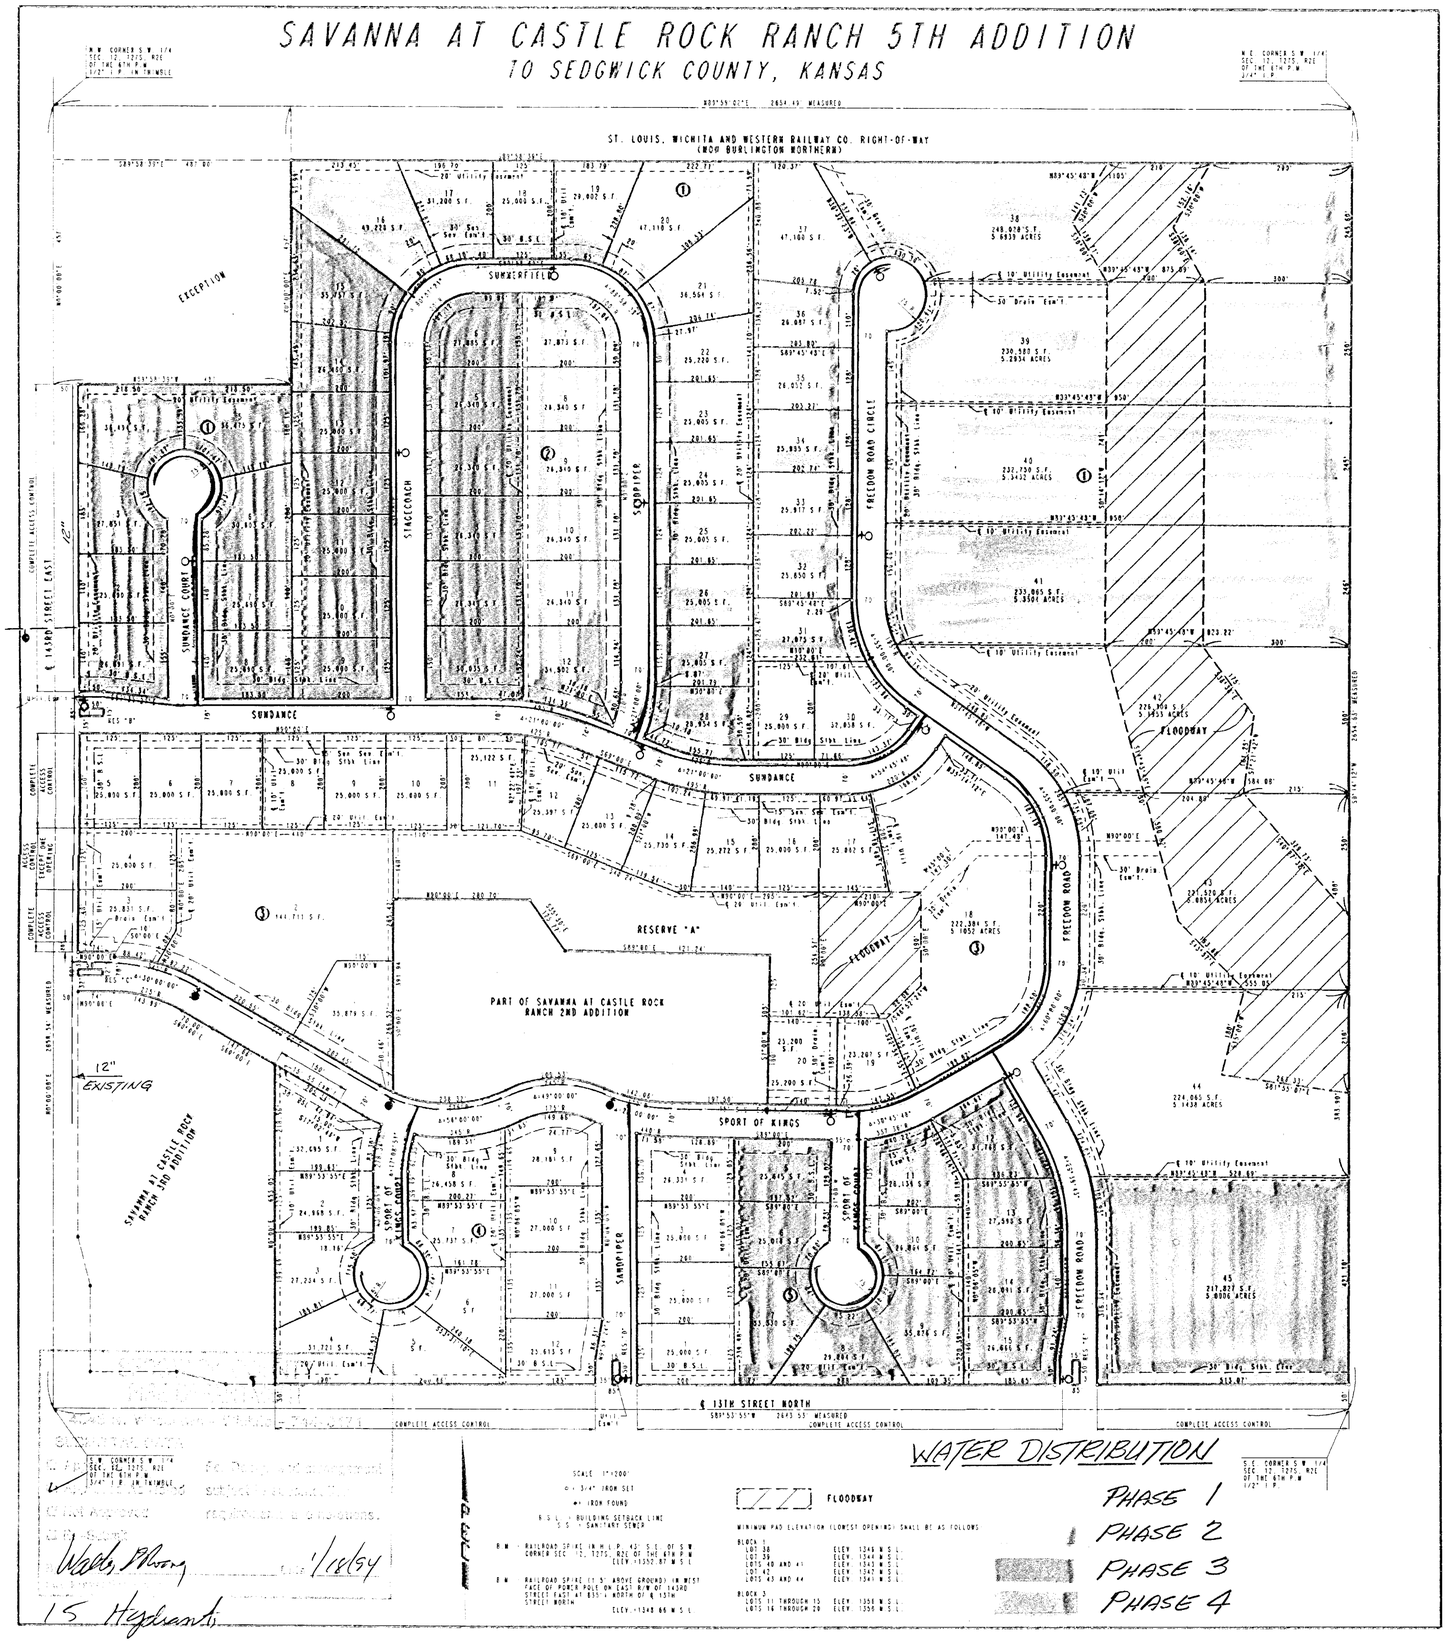

Walter Phillips 1/18/64

