


SANDALWOOD VILLAGE  
 To WICHITA, SEDG. Co., KANS.

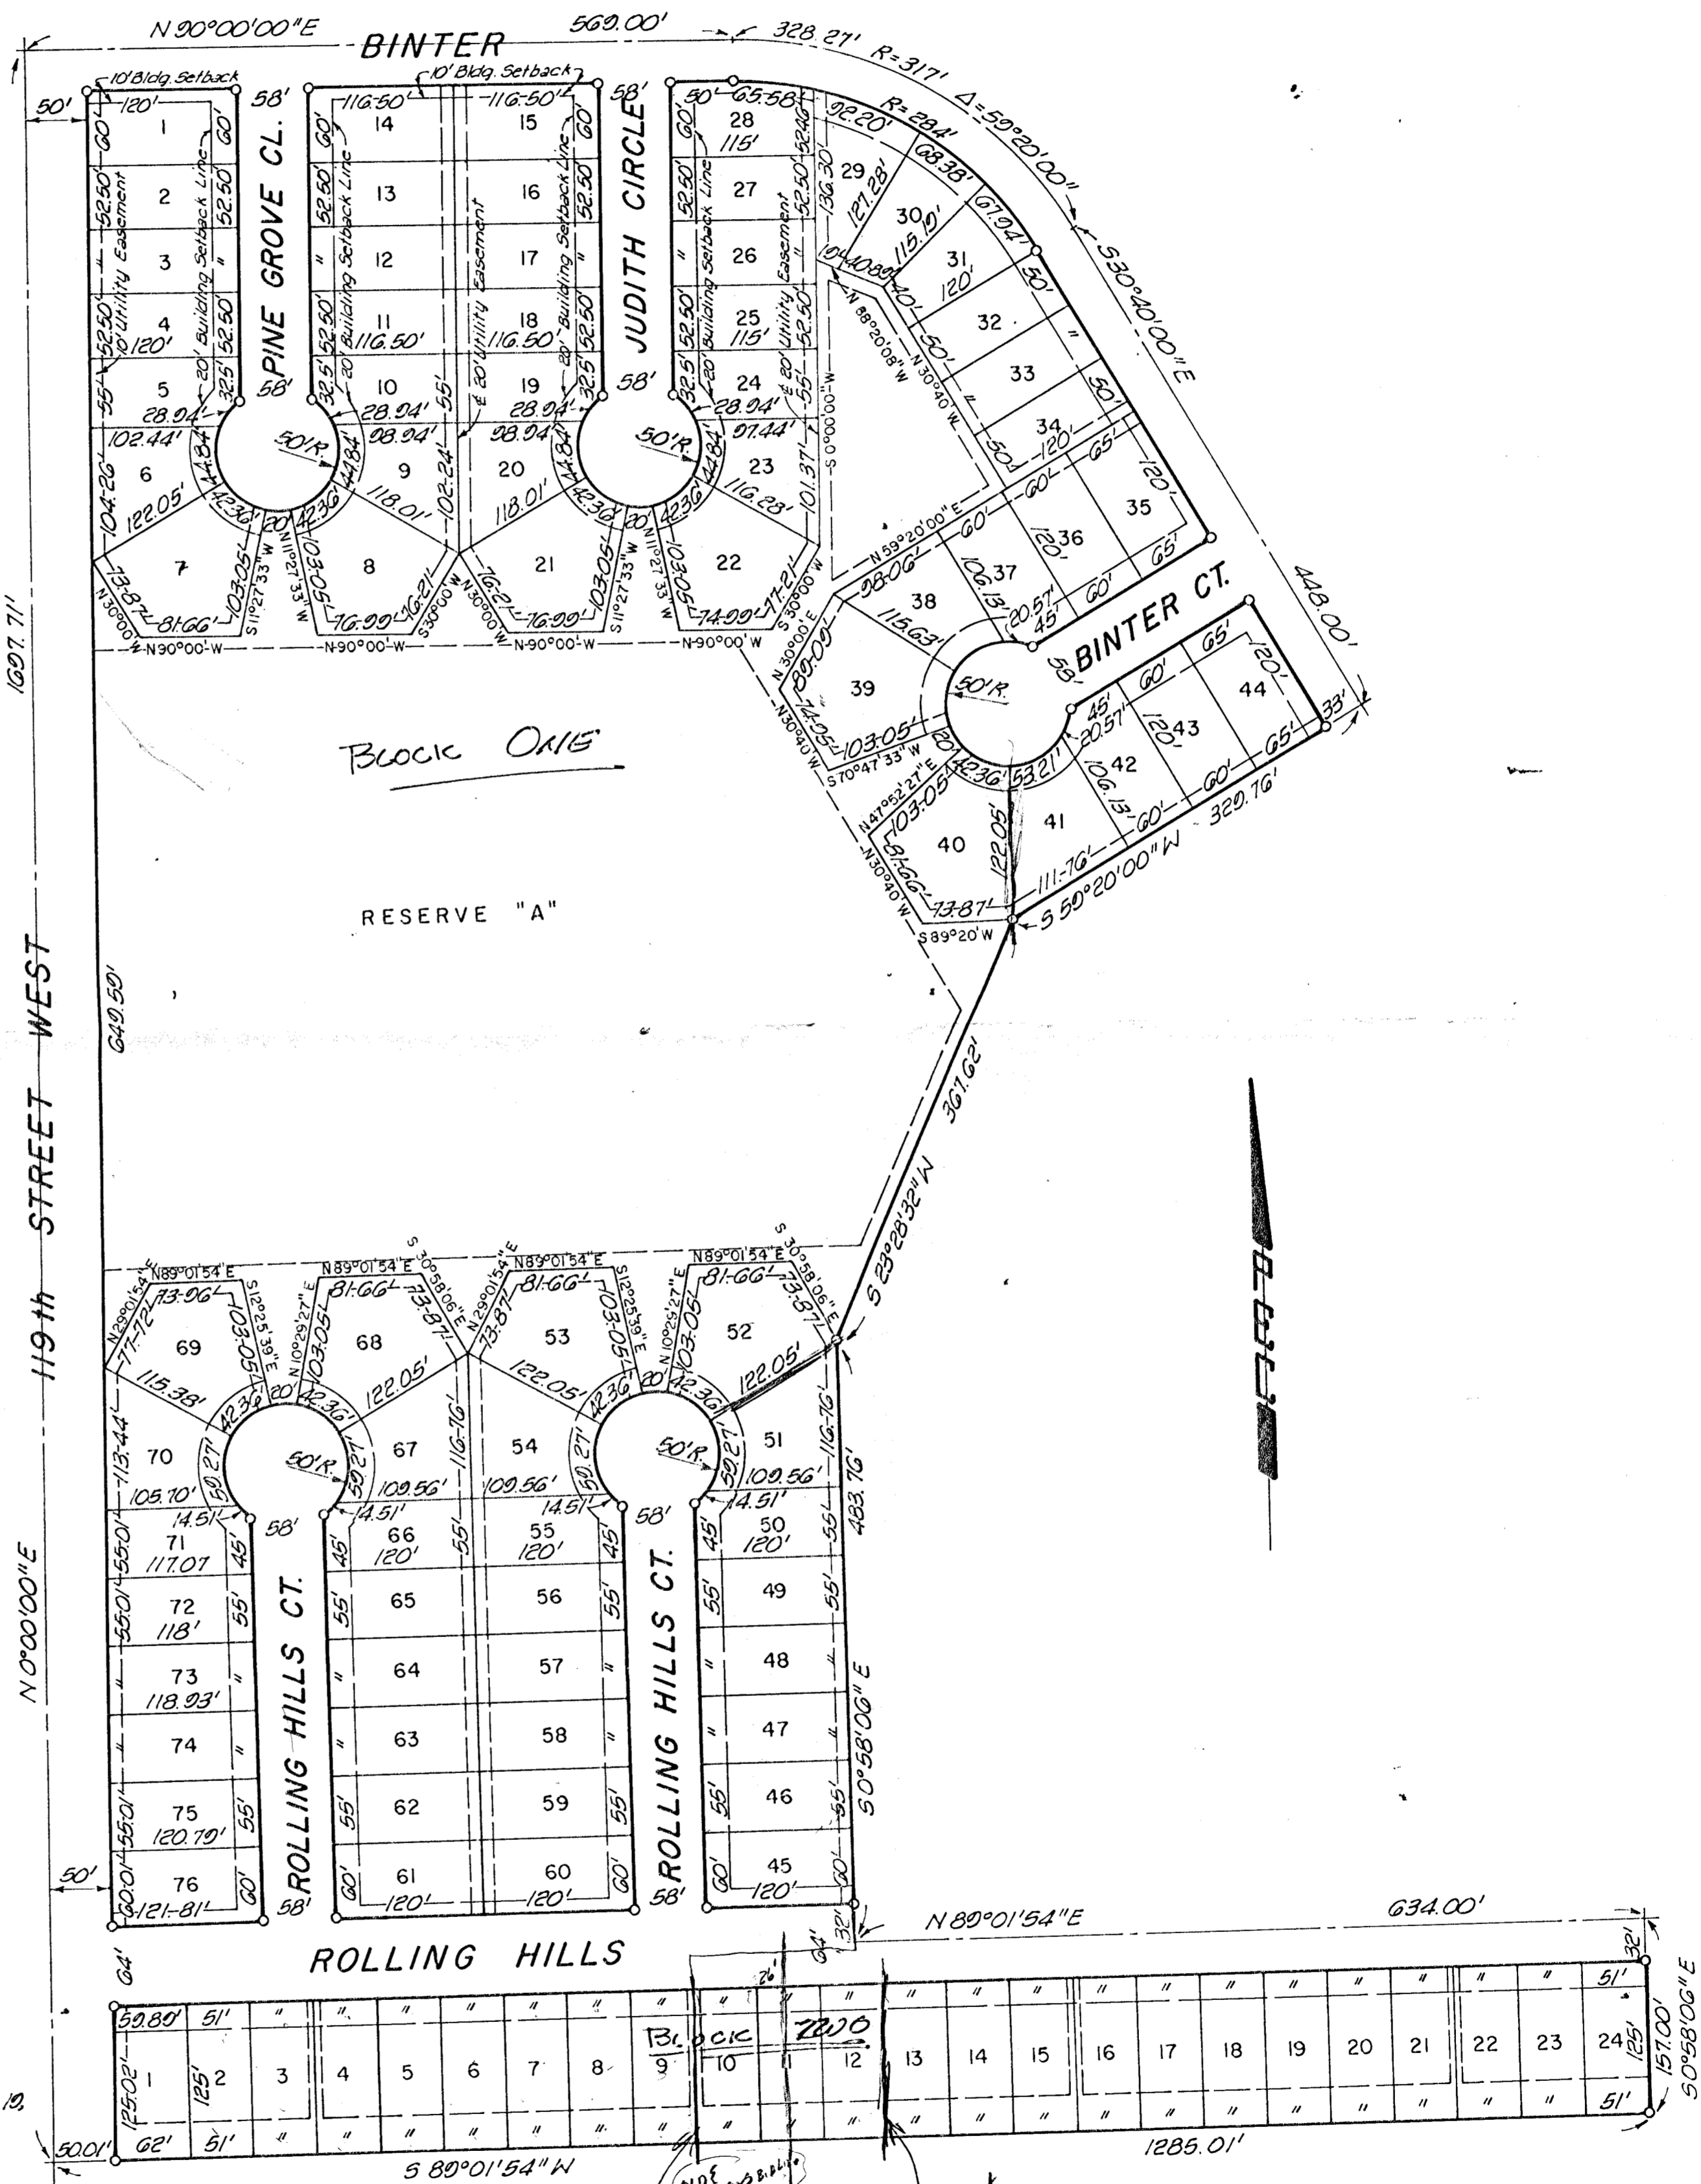

SW. Cor., NW 1/4, Sec. 12,  
 T21S, R1W, 4th P.M.

SW's  
 Berwick Distric  
 line

OLD NEWS Bldg.

Daymont  
 2d. Line

466