



TIMBROOK 2ND ADDITION TO WICHITA, SEDGWICK COUNTY, KANSAS

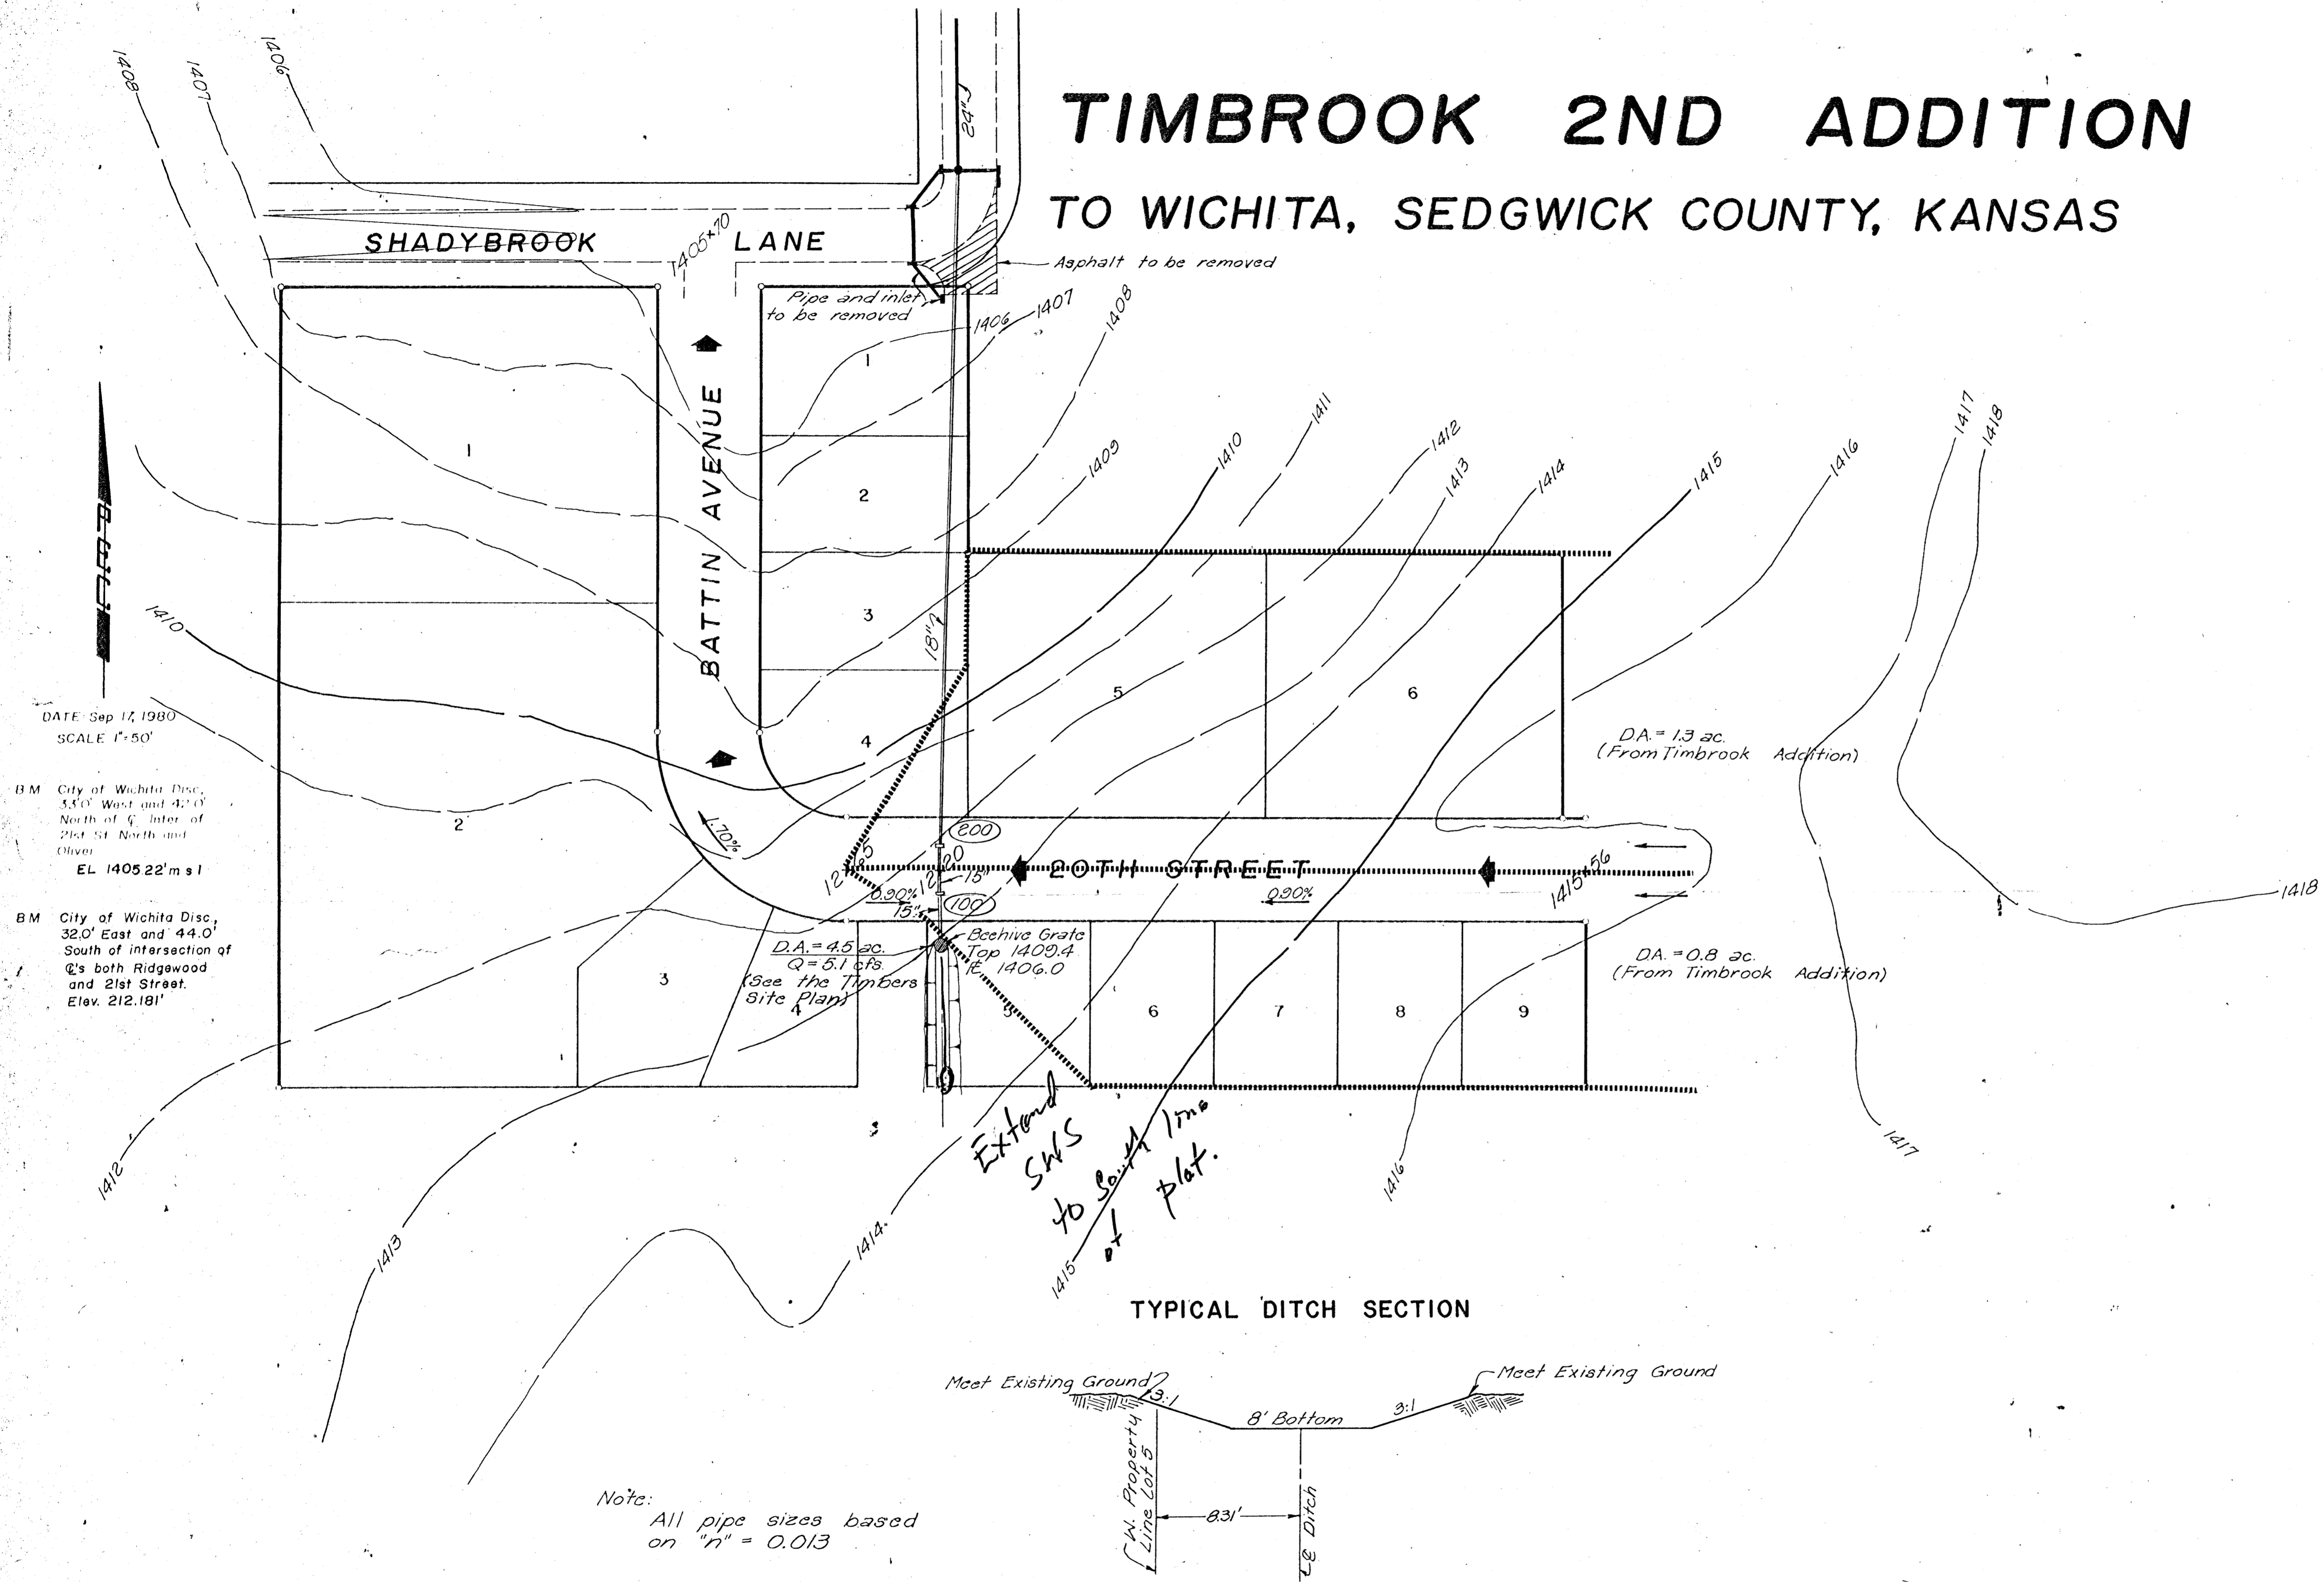

Note: All pipe sizes based on "n" = 0.013

TIMBROOK 2ND ADDITION

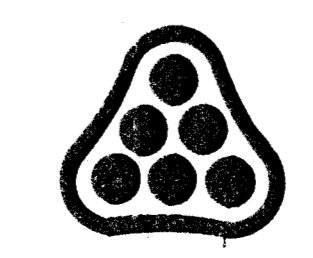

DRAINAGE CONCEPT
AND PLAN

October 3, 1980 Designed by KJH