Preliminary Plat

SHERWOOD ACRES MOBILE HOME PARK

Wichita, Sedgwick County, Kansas

RIVERSIDE MOBILE HOME PARK
OWNER:
Eugene G. Hensley and Dorothy
W. Hensley, husband and wife,
2212 E. 47th St. South
Wichita, Kansas 67216

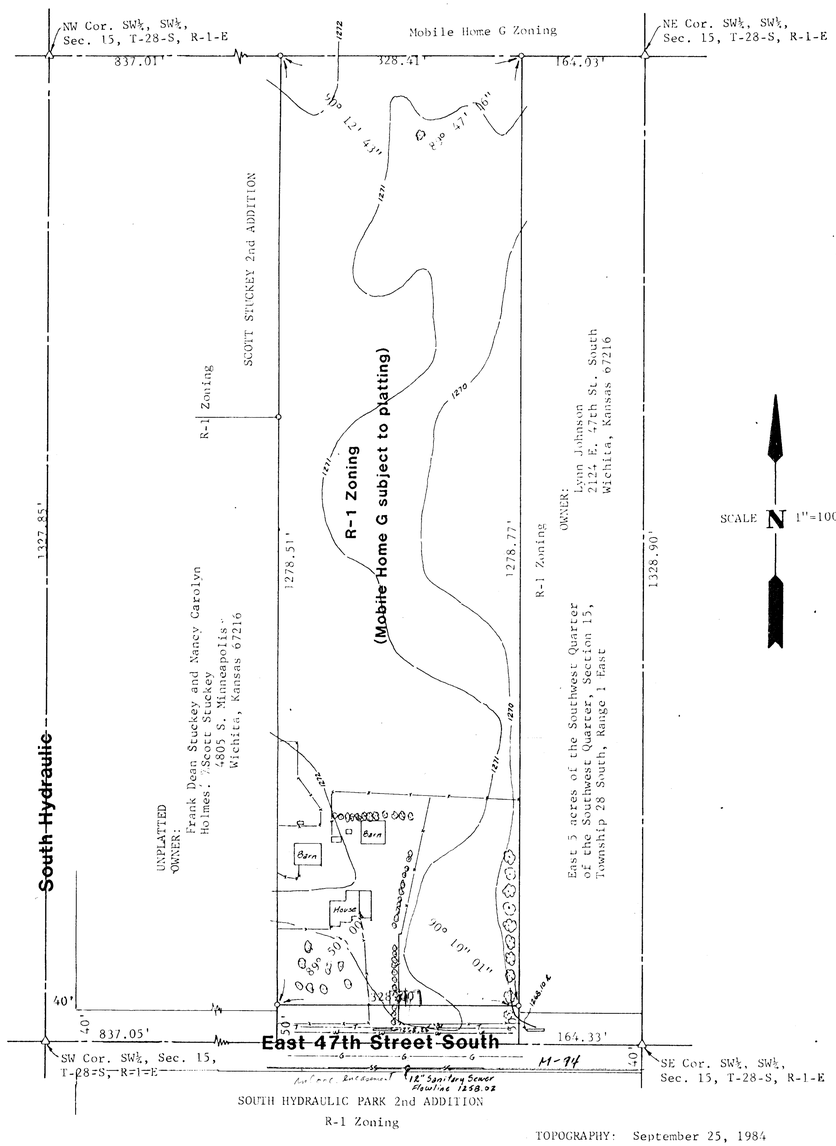

SCALE 1"=100'

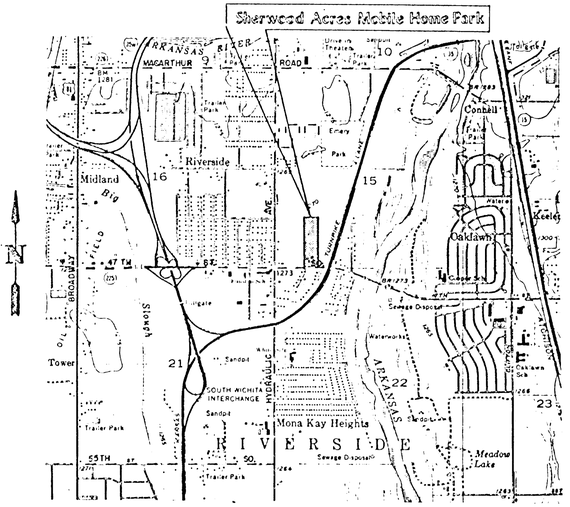

Vicinity Map

Owner:
Bill J. Morris
1404 South Bebe
Wichita, Kansas
67209

LEGAL DESCRIPTION
The West ten (10) acres of the East fifteen (15) acres of the Southwest Quarter of the Southwest Quarter of Section 15, Township 28 South. Range 1 East of the 6th P. M., City of Wichita, Sedgwick County, Kansas.

BENCH MARK:
"O" in open, top of fire hydrant SE corner of 47th St. South and Minneapolis
Elevation 1272.90

TOPOGRAPHY: September 25, 1984

Booker/Freund
Engineers Architects Planners
111 West Douglas, Suite 412
Wichita, Kansas 67202
Telephone 263-6121

March 15, 1985

K-9139-02