
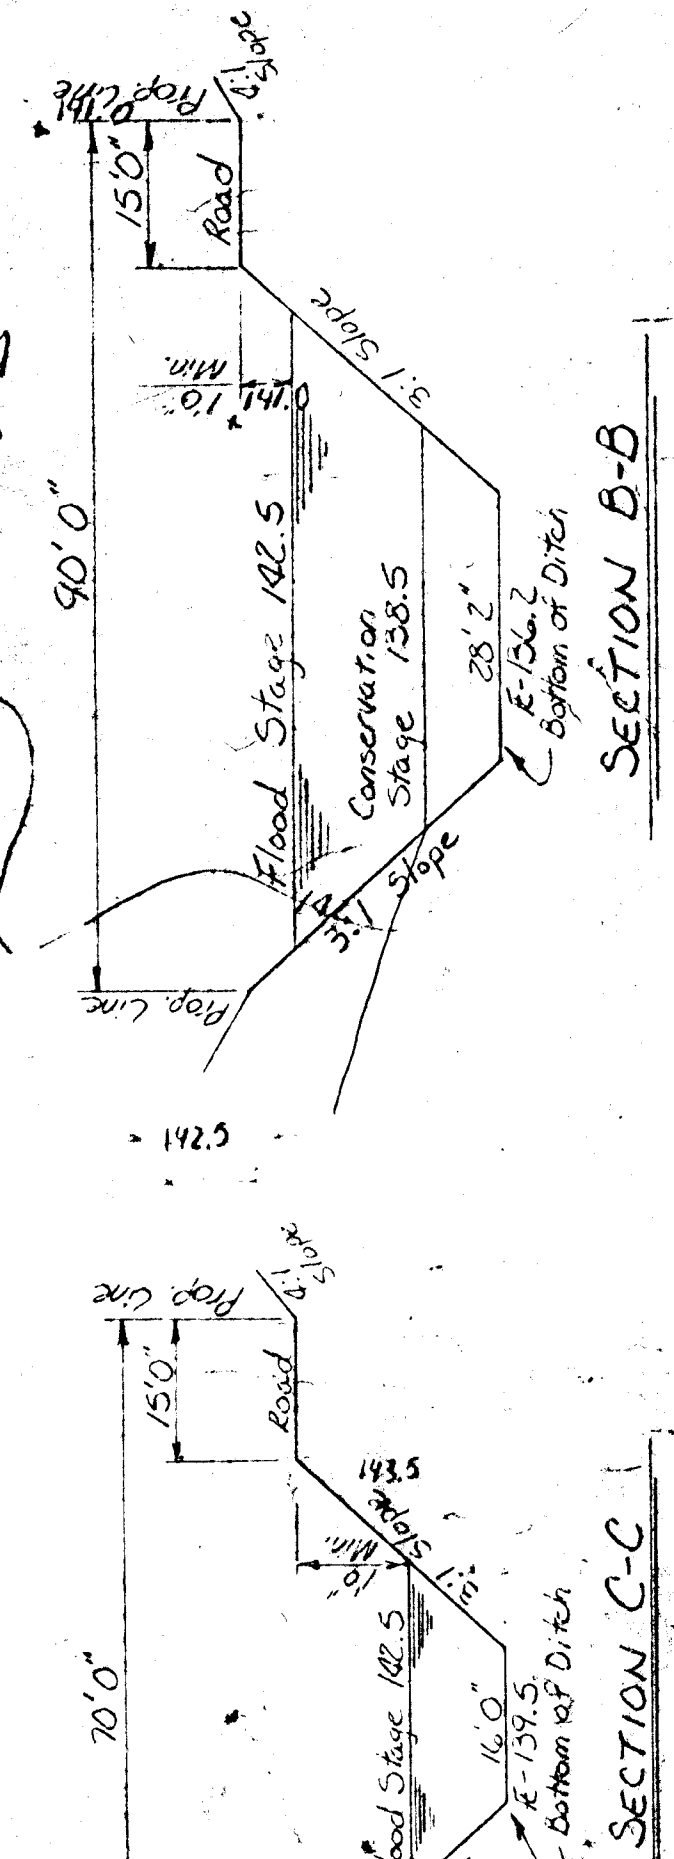


SANTA FE LAND IMPROVEMENT CO INC.
RURAL R-1

BUILDERS INC.
RURAL R-1

REBECCA T. VEIRN
RURAL R-1



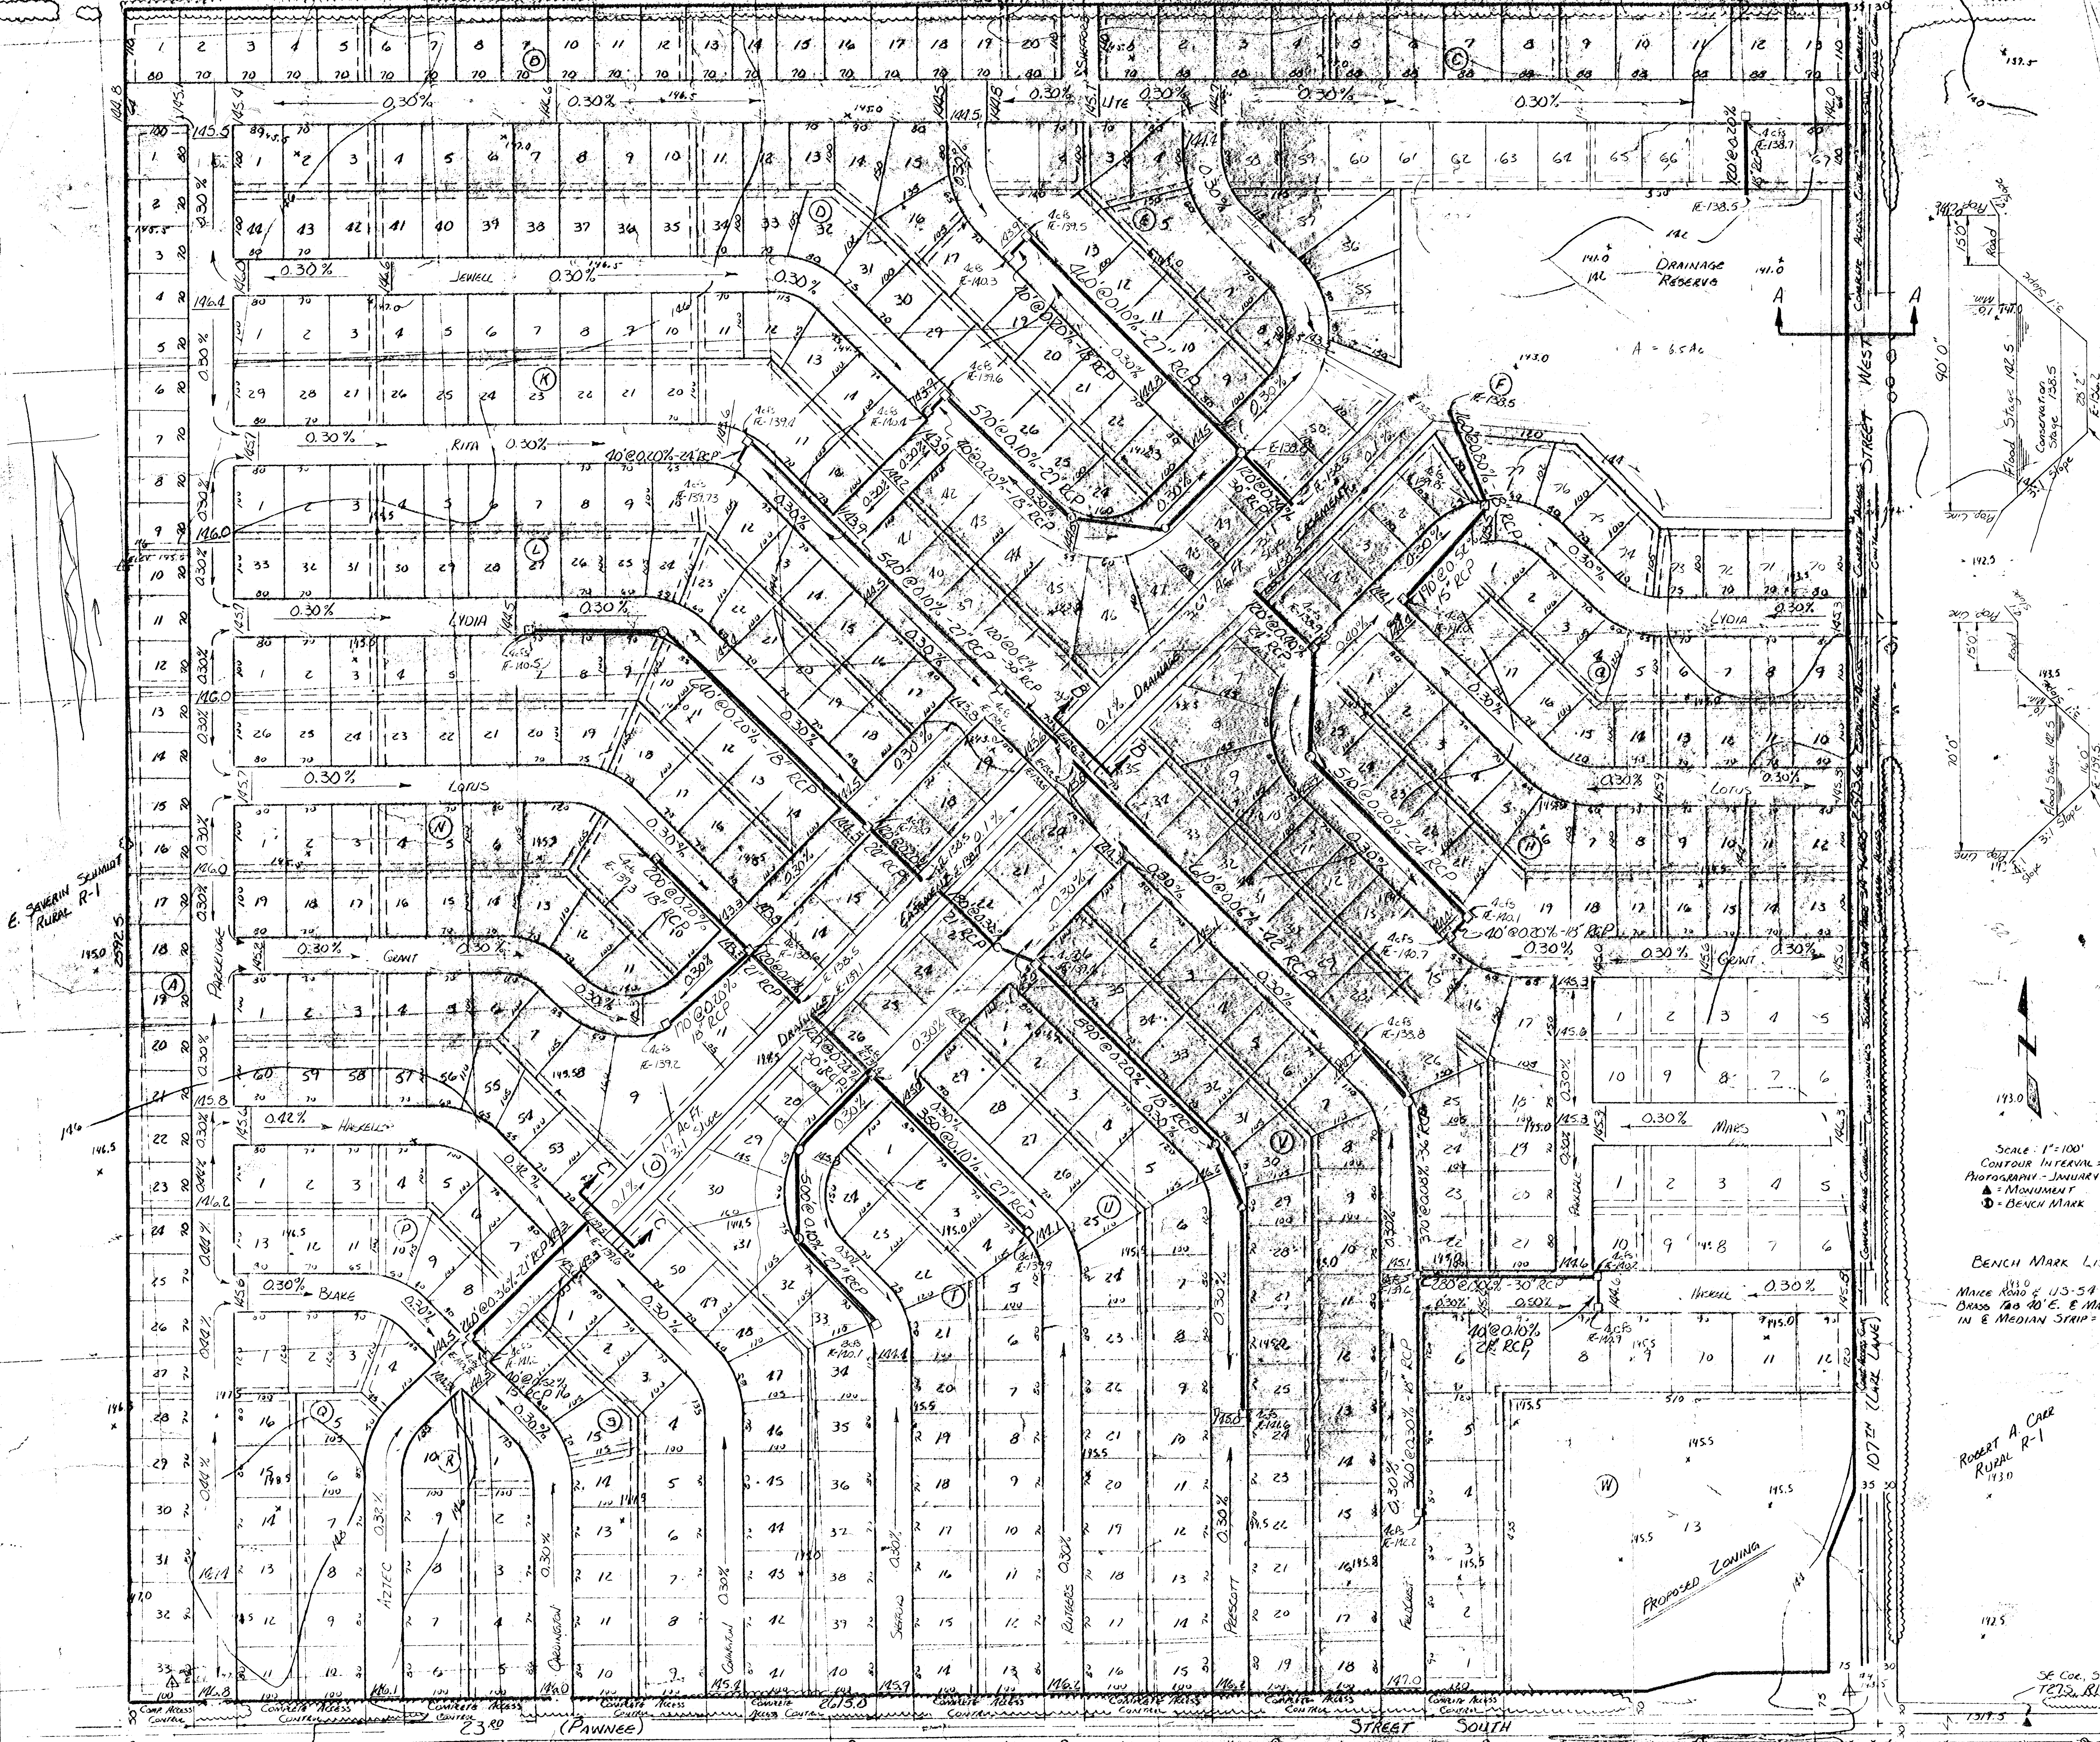


Scale: 1" = 100'
 Contour Interval = 2'
 Photograph - January 1977
 ▲ = Monument
 ⊙ = Bench Mark

BENCH MARK LIST:
 1110 Mince Road E. U.S. 54 Hwy
 Brass 140' E. E. Mince Rd.
 in E Median Strip - EL 1387.14

ROBERT A. CARR
 RURAL R-1
 1130

SE Cor. Sec. 31
 T23N. R1W

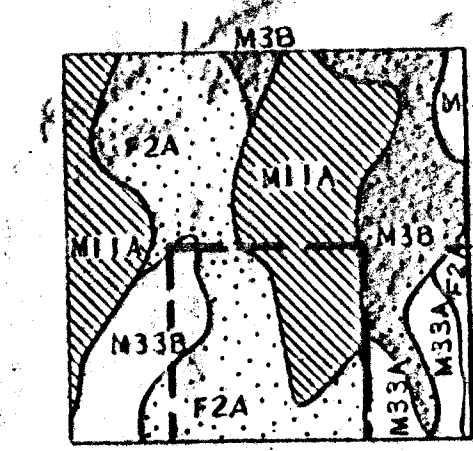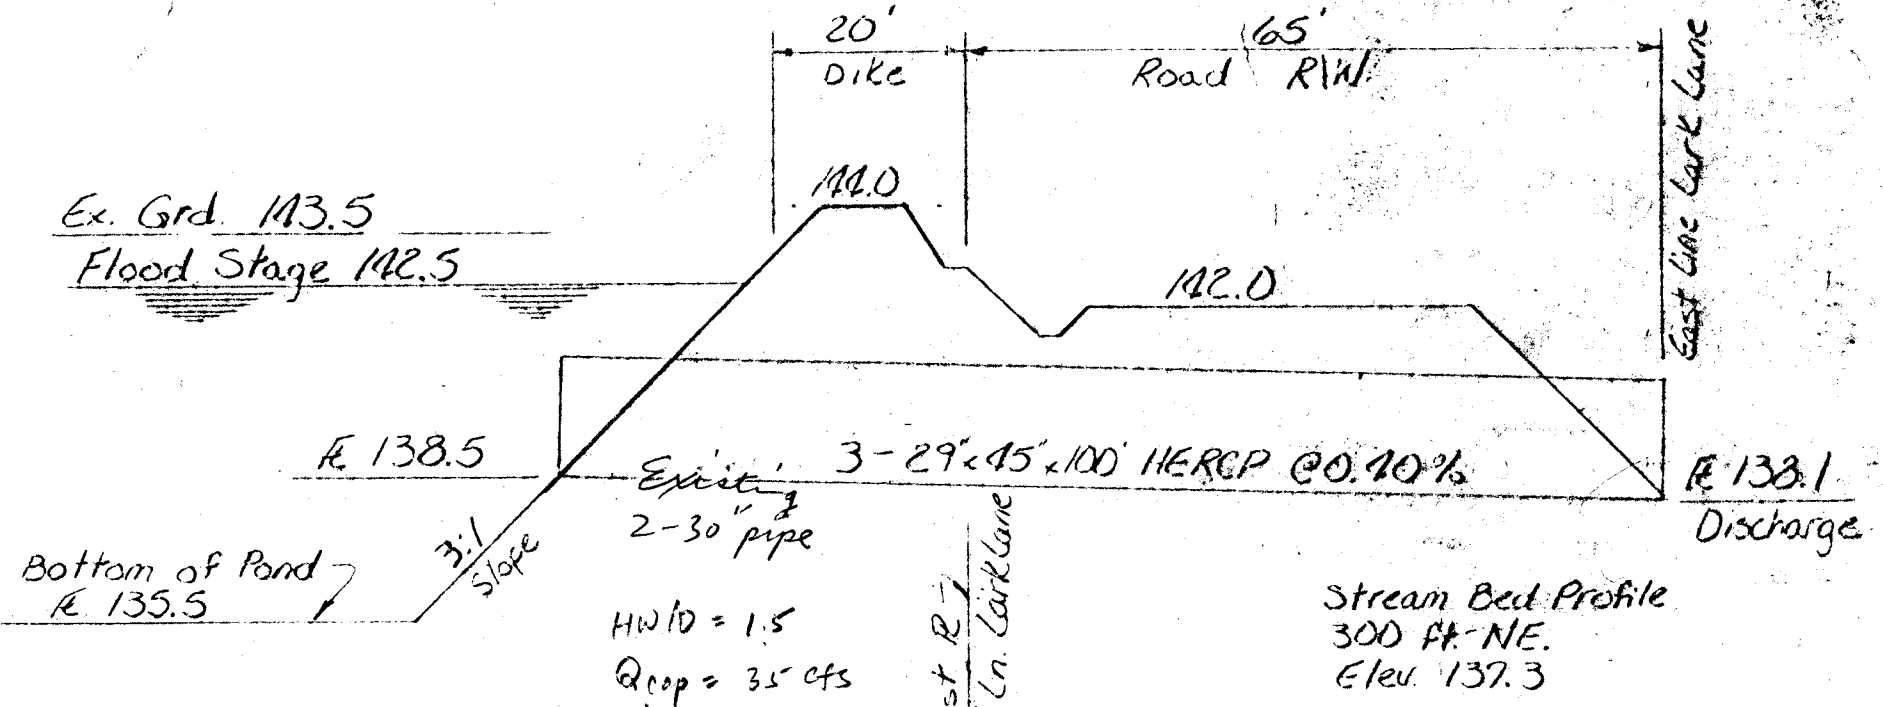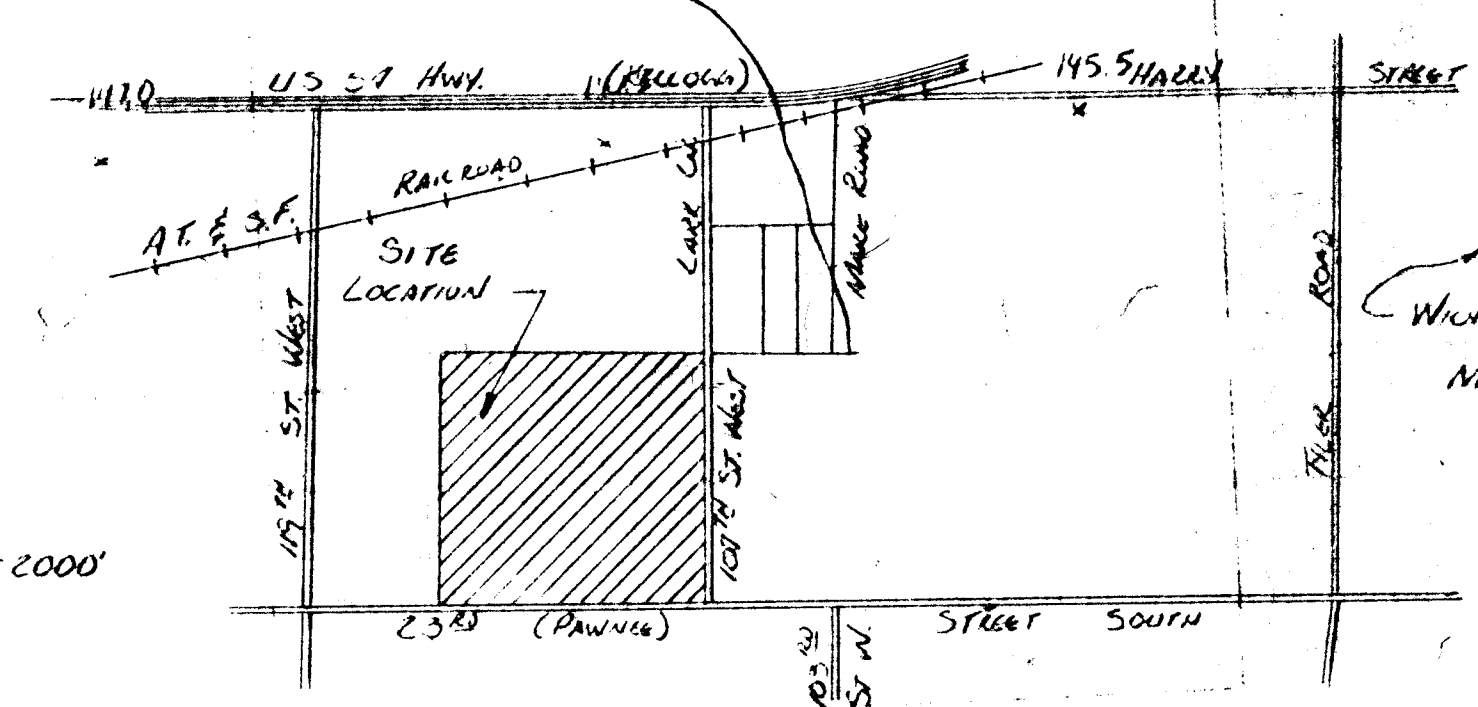

Scale: 1" = 1 MILE
 Hydro Group of Sons (D) AS
 Prepared by USDA - Soil Con-
 servation Service May 4, 1977.

Rev. A T23-71 DFG Revised Drainage Plan.	
AMORTIBANC INVESTMENT COMPANY, INC. WICHITA, KANSAS	
PROPOSED DRAINAGE PLAN PAWNEE MESA ADDITION SE COR. SECTION 31, T23N, R1W	
CAMPBELL & CASTLE ENGINEERS WICHITA, KANSAS	DSG DR. CD CH APP
DATE July 1977	DWG FILE NO 7847-F-101A SHEET NO 1 OF 1