



164.98' E. of N.W. Cor.  
NE 1/4 27-27-164

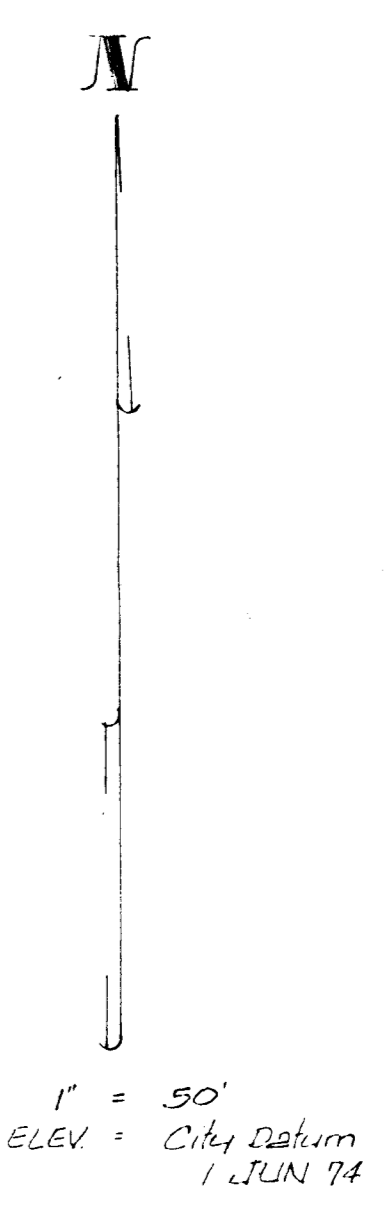

BENCH MARK:  
City Disc. 337 W. E. 343.3 of  
NW 1/4 Cor. NE 1/4 27-27-164  
Elev. = 121.843 City Datum

REVISED  
PRELIMINARY PLAT  
**MAPLE LANE 2ND ADDITION**  
The E. 5 Acres of the W. 10 Acres of the NW 1/4 of the NE 1/4 of Sec 27, Twp 27-S  
R-1-W  
LaVurne Ulrich

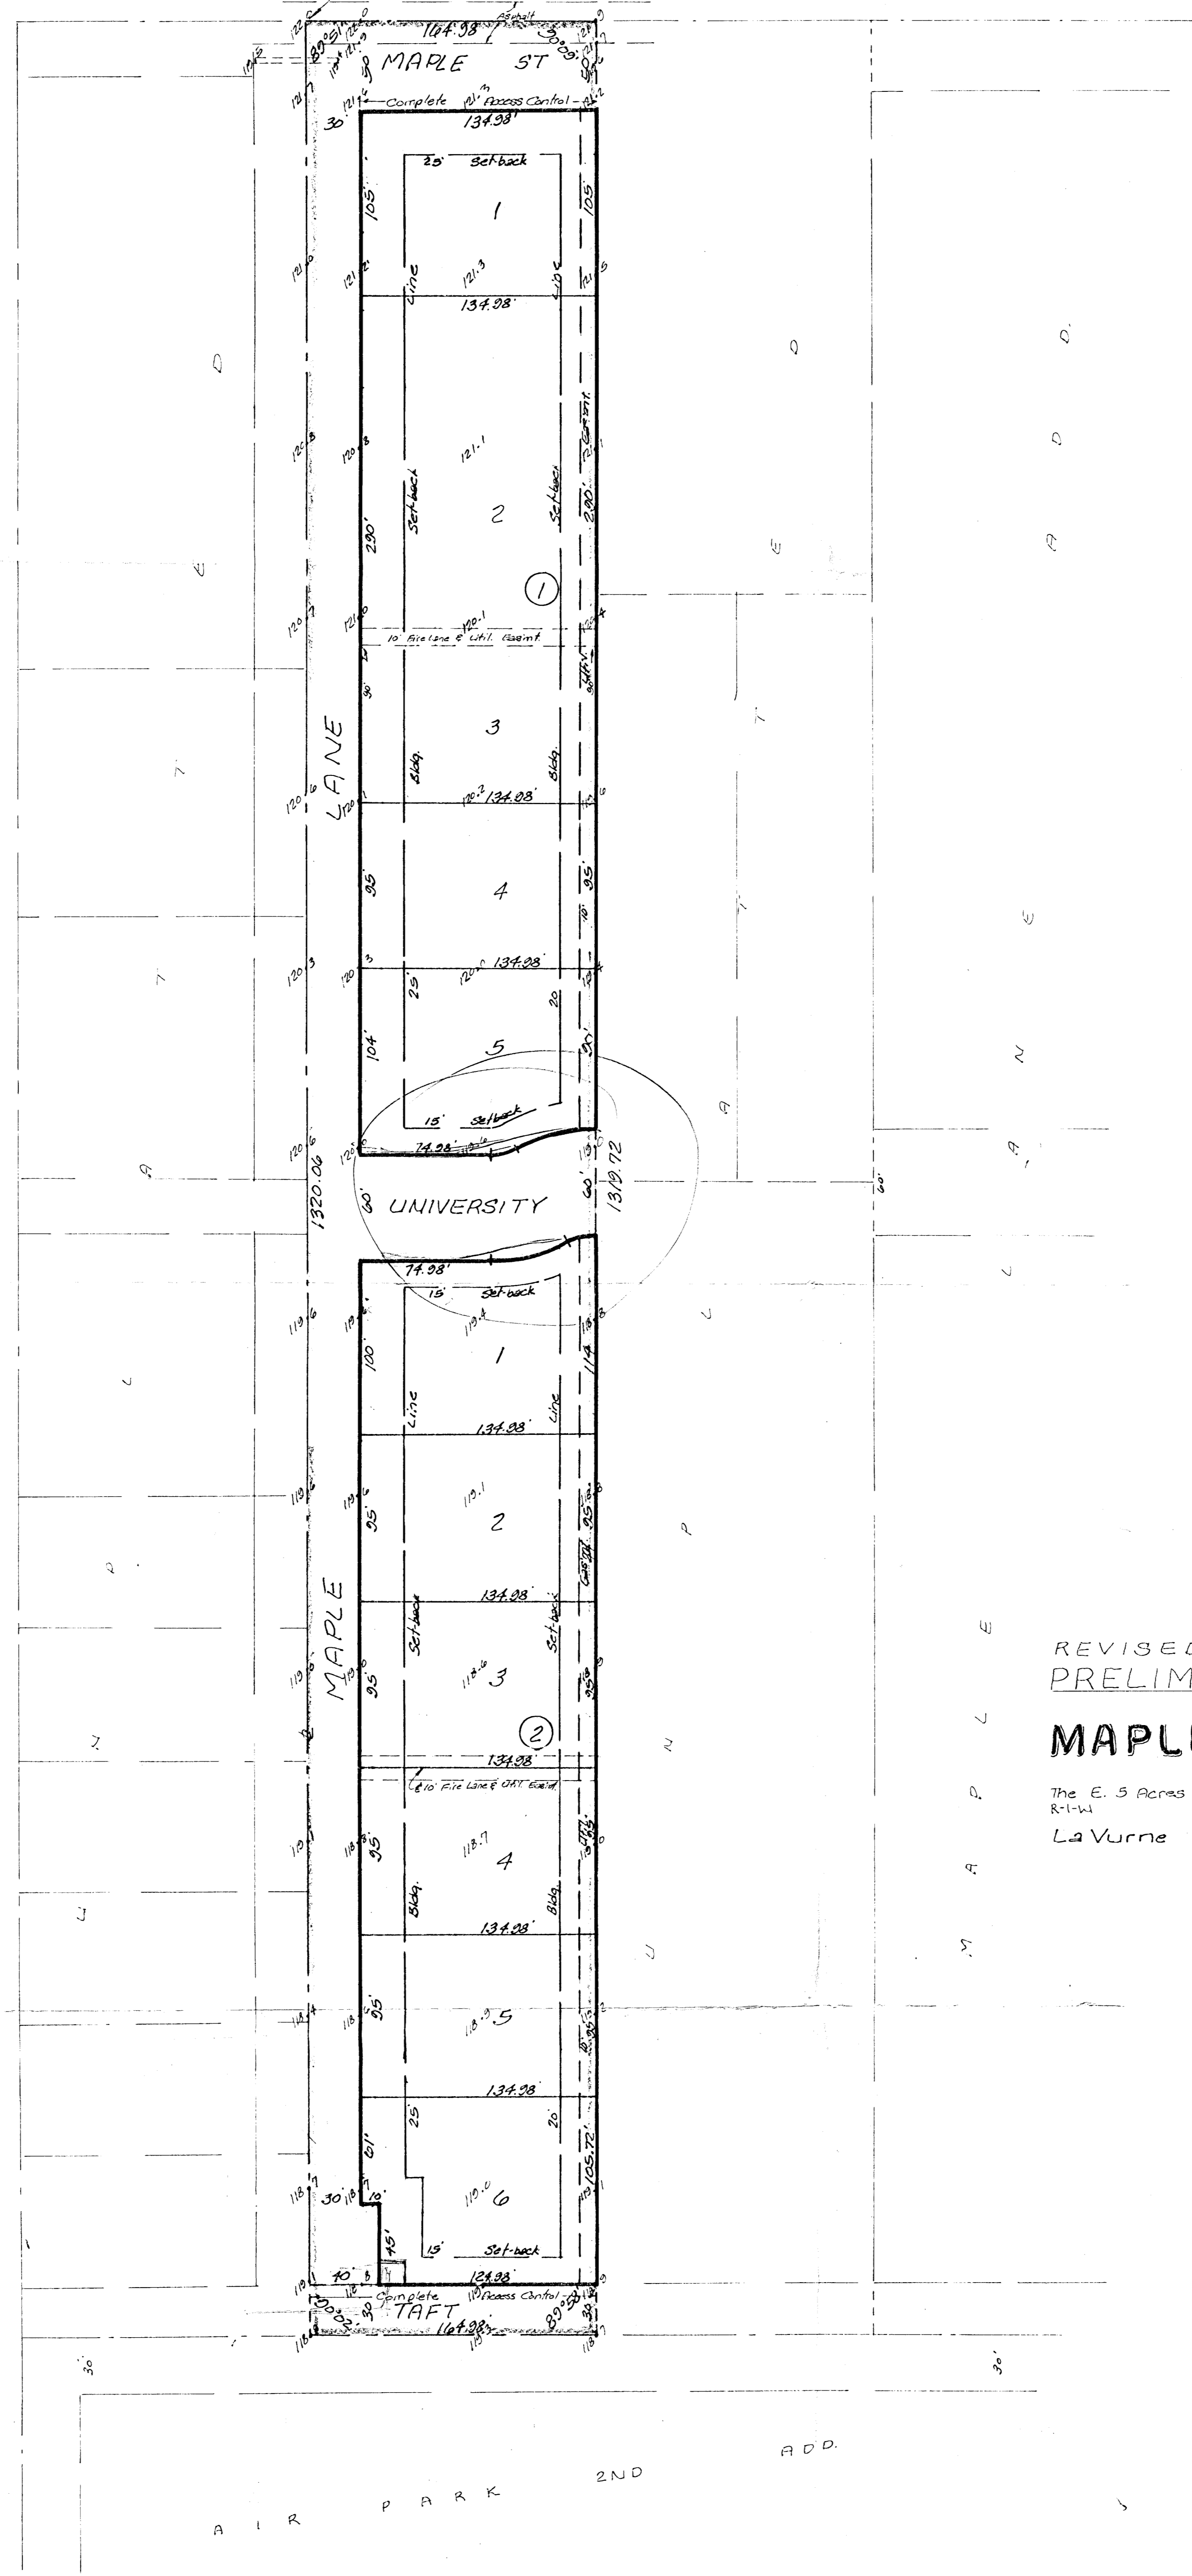