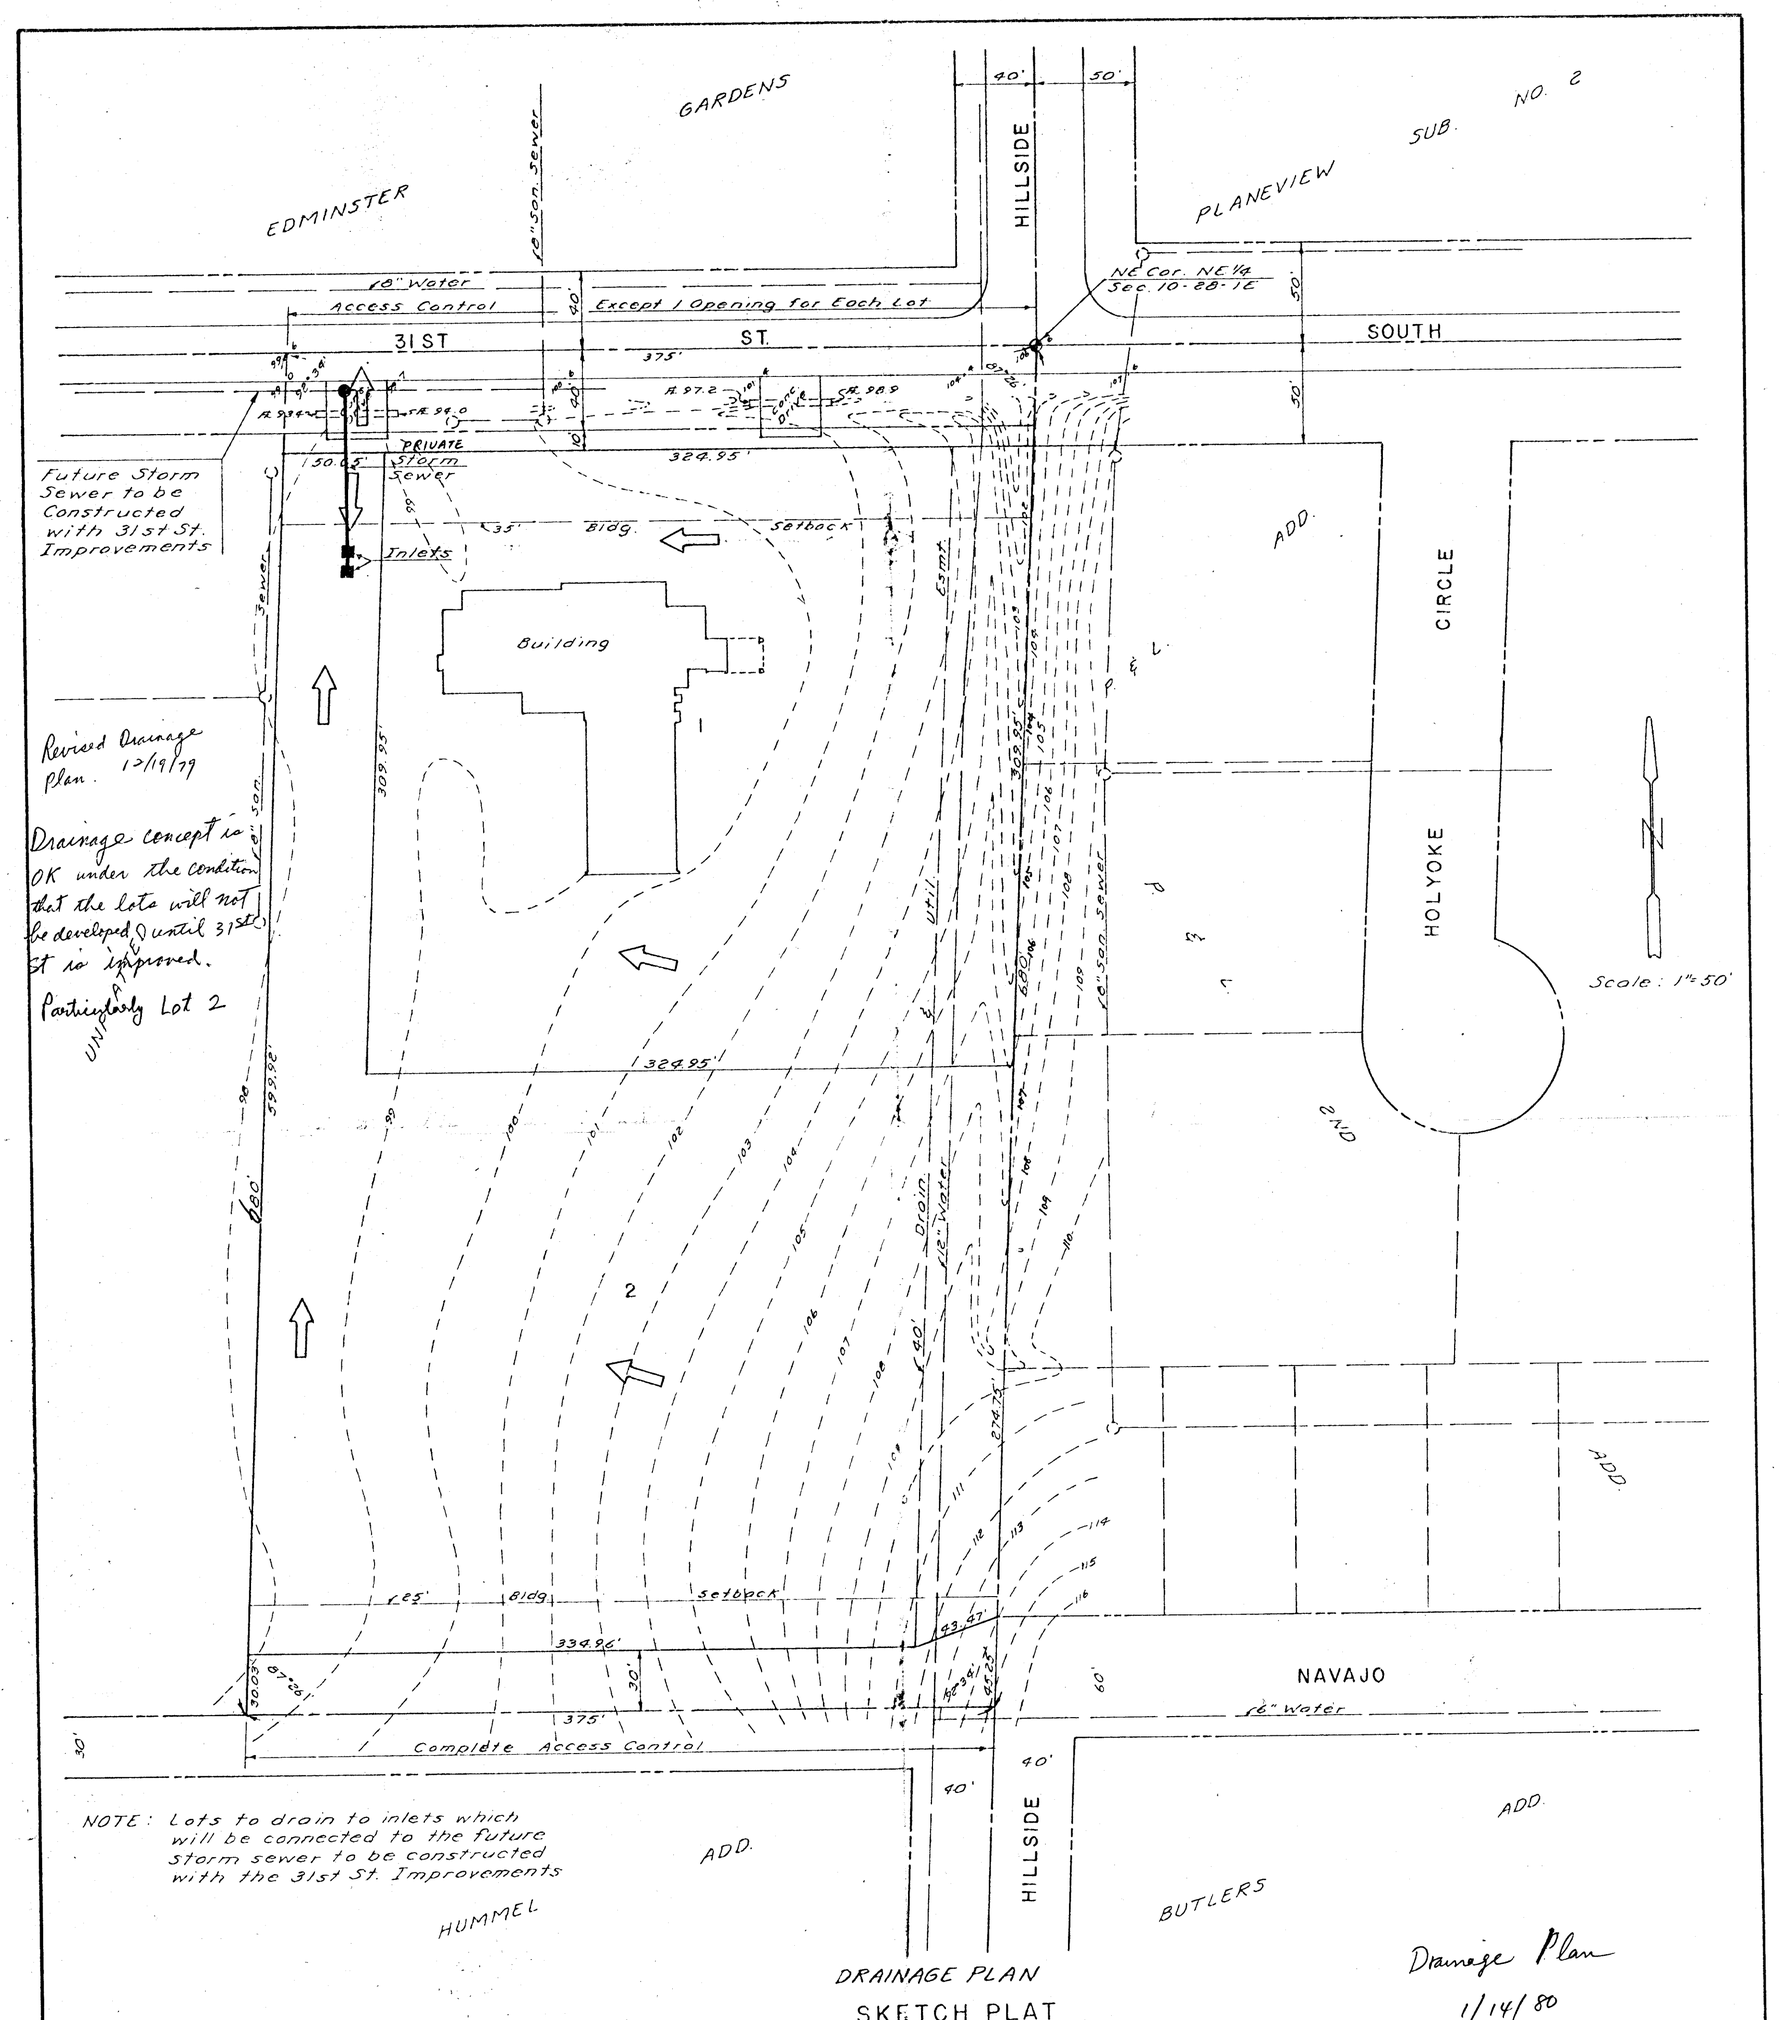

DRAINAGE PLAN

SKETCH PLAT

MAGNUS 2ND ADDITION

THE EAST 375' OF THE NORTH 680' OF NE 1/4 SEC. 10-28-1E

Drainage Plan 1/14/80

B.M. City disc. 52' N. & 44' E. & 31st & Hillside El. 104.29

Boughman Co., P.A. 11-16-79