


Scale: 1" = 40'  
Bench Mark: Top of pipe  
in thimble Elev. ~1294.30

RIDGE RD.

UNPLATTED

SW Corner of  
Sec. 10-28-1W


MAC ARTHUR  
375'

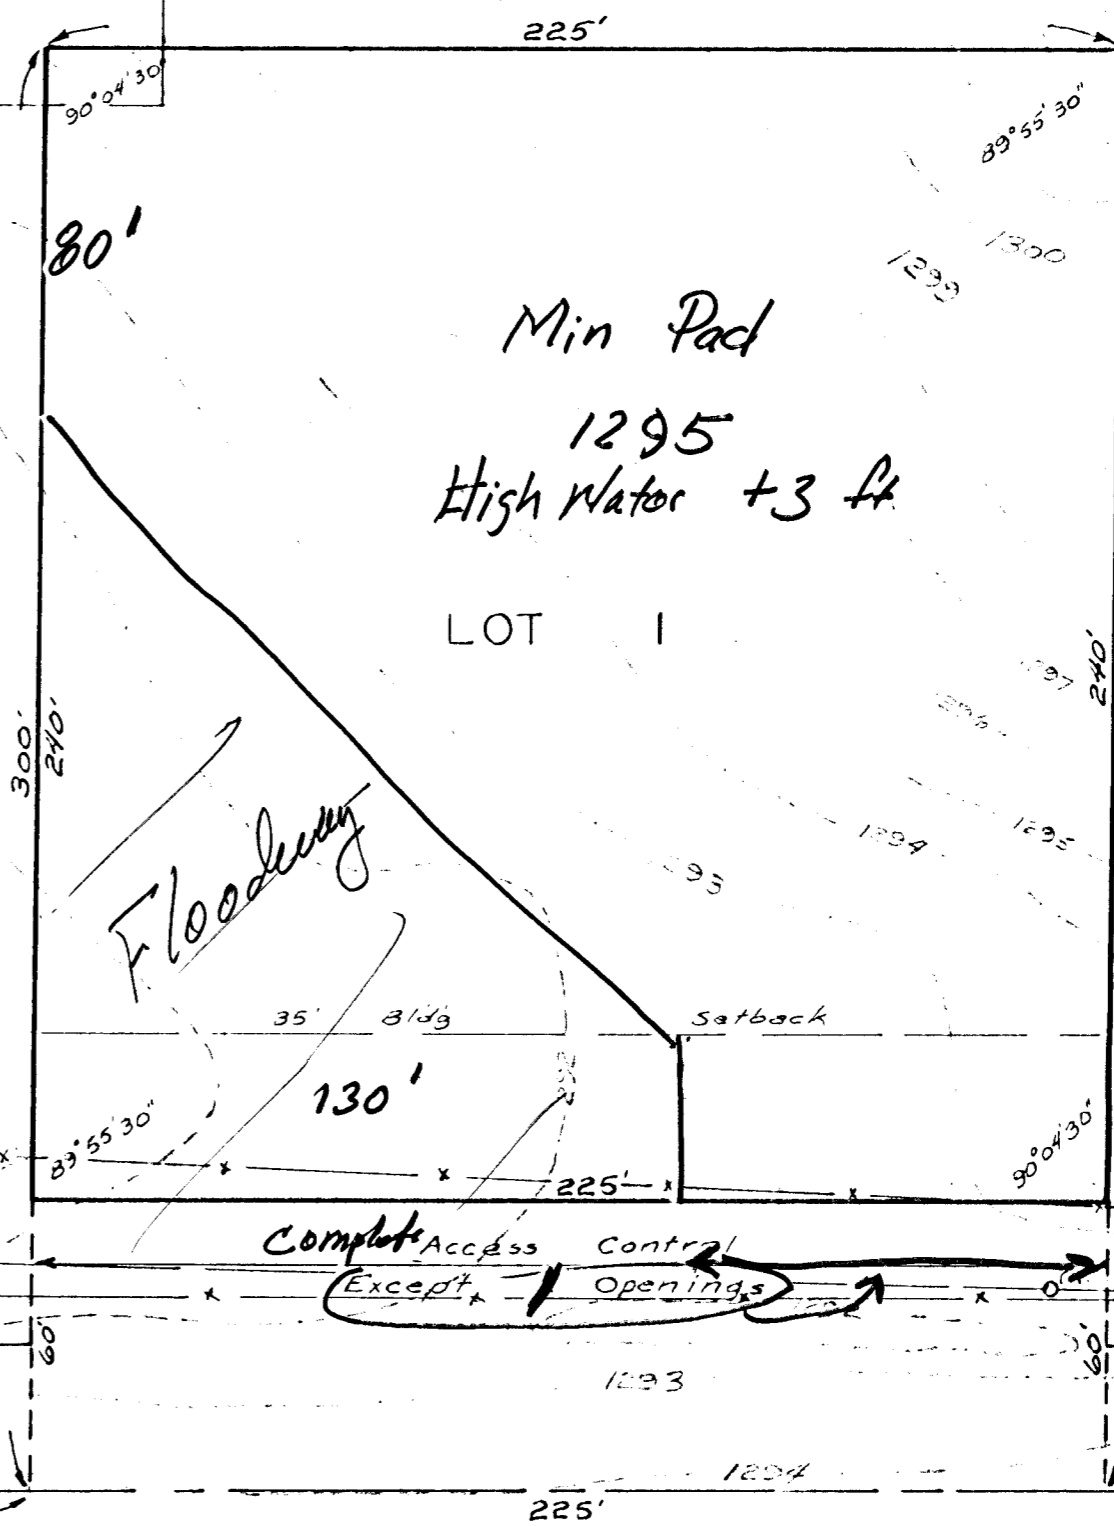

PRELIMINARY PLAT

# MAC ARTHUR INVESTMENTS ADDITION

PART OF THE SW 1/4 SEC. 10-28-1W

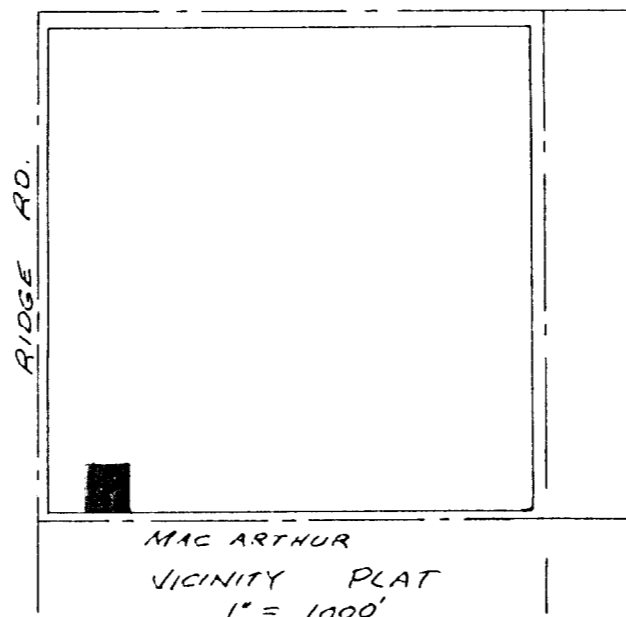

MAC ARTHUR  
VICINITY PLAT  
1" = 1000'

Date: Jan. 8, 1980

**BAUGHMAN COMPANY, P.A.**  
SURVEYING & ENGINEERING  
316/262-7271 • 330 LAURA • WICHITA, KANSAS 67211