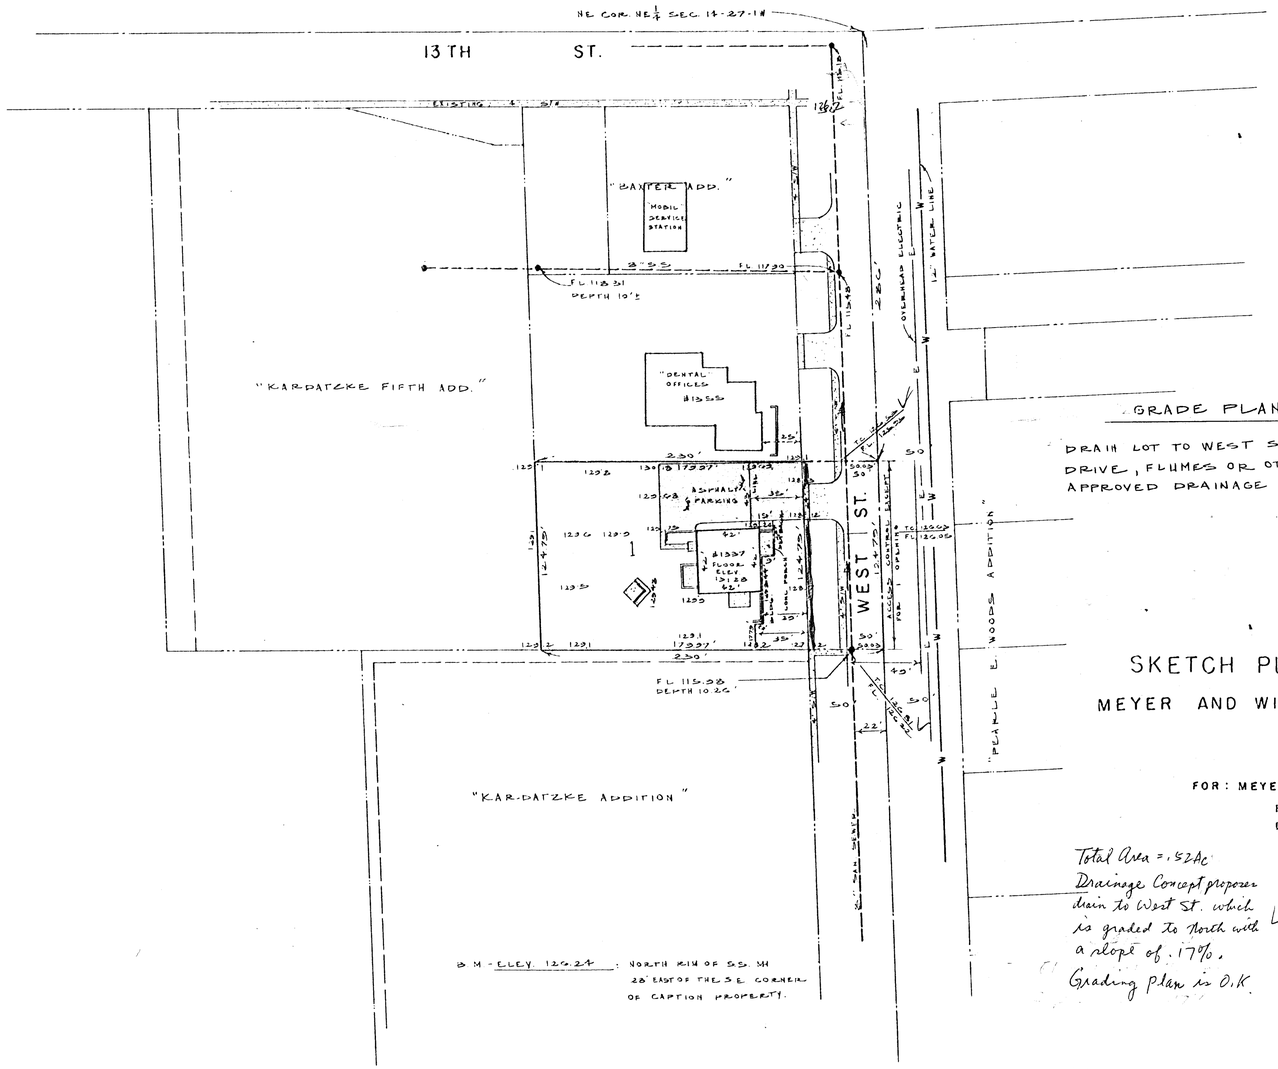

GRADE PLAN

DRAIN LOT TO WEST ST. VIA DRIVE, FLUMES OR OTHER APPROVED DRAINAGE METHODS.

1" = 50'

SKETCH PLAT

MEYER AND WILLIAMS ADDITION

FOR: MEYER, EBEL & WILLIAMS, INC.
ROY E. MEYER, PRESIDENT
DALE R. WILLIAMS, SEC.

Total Area = .52 Ac.
Drainage Concept proposes drain to West St. which is graded to North with a slope of .17%.
Grading Plan is O.K.

Lot Grading Plan
3/10/80

KENNETH O. TAYLOR, P.E.
MARCH 3, 1980