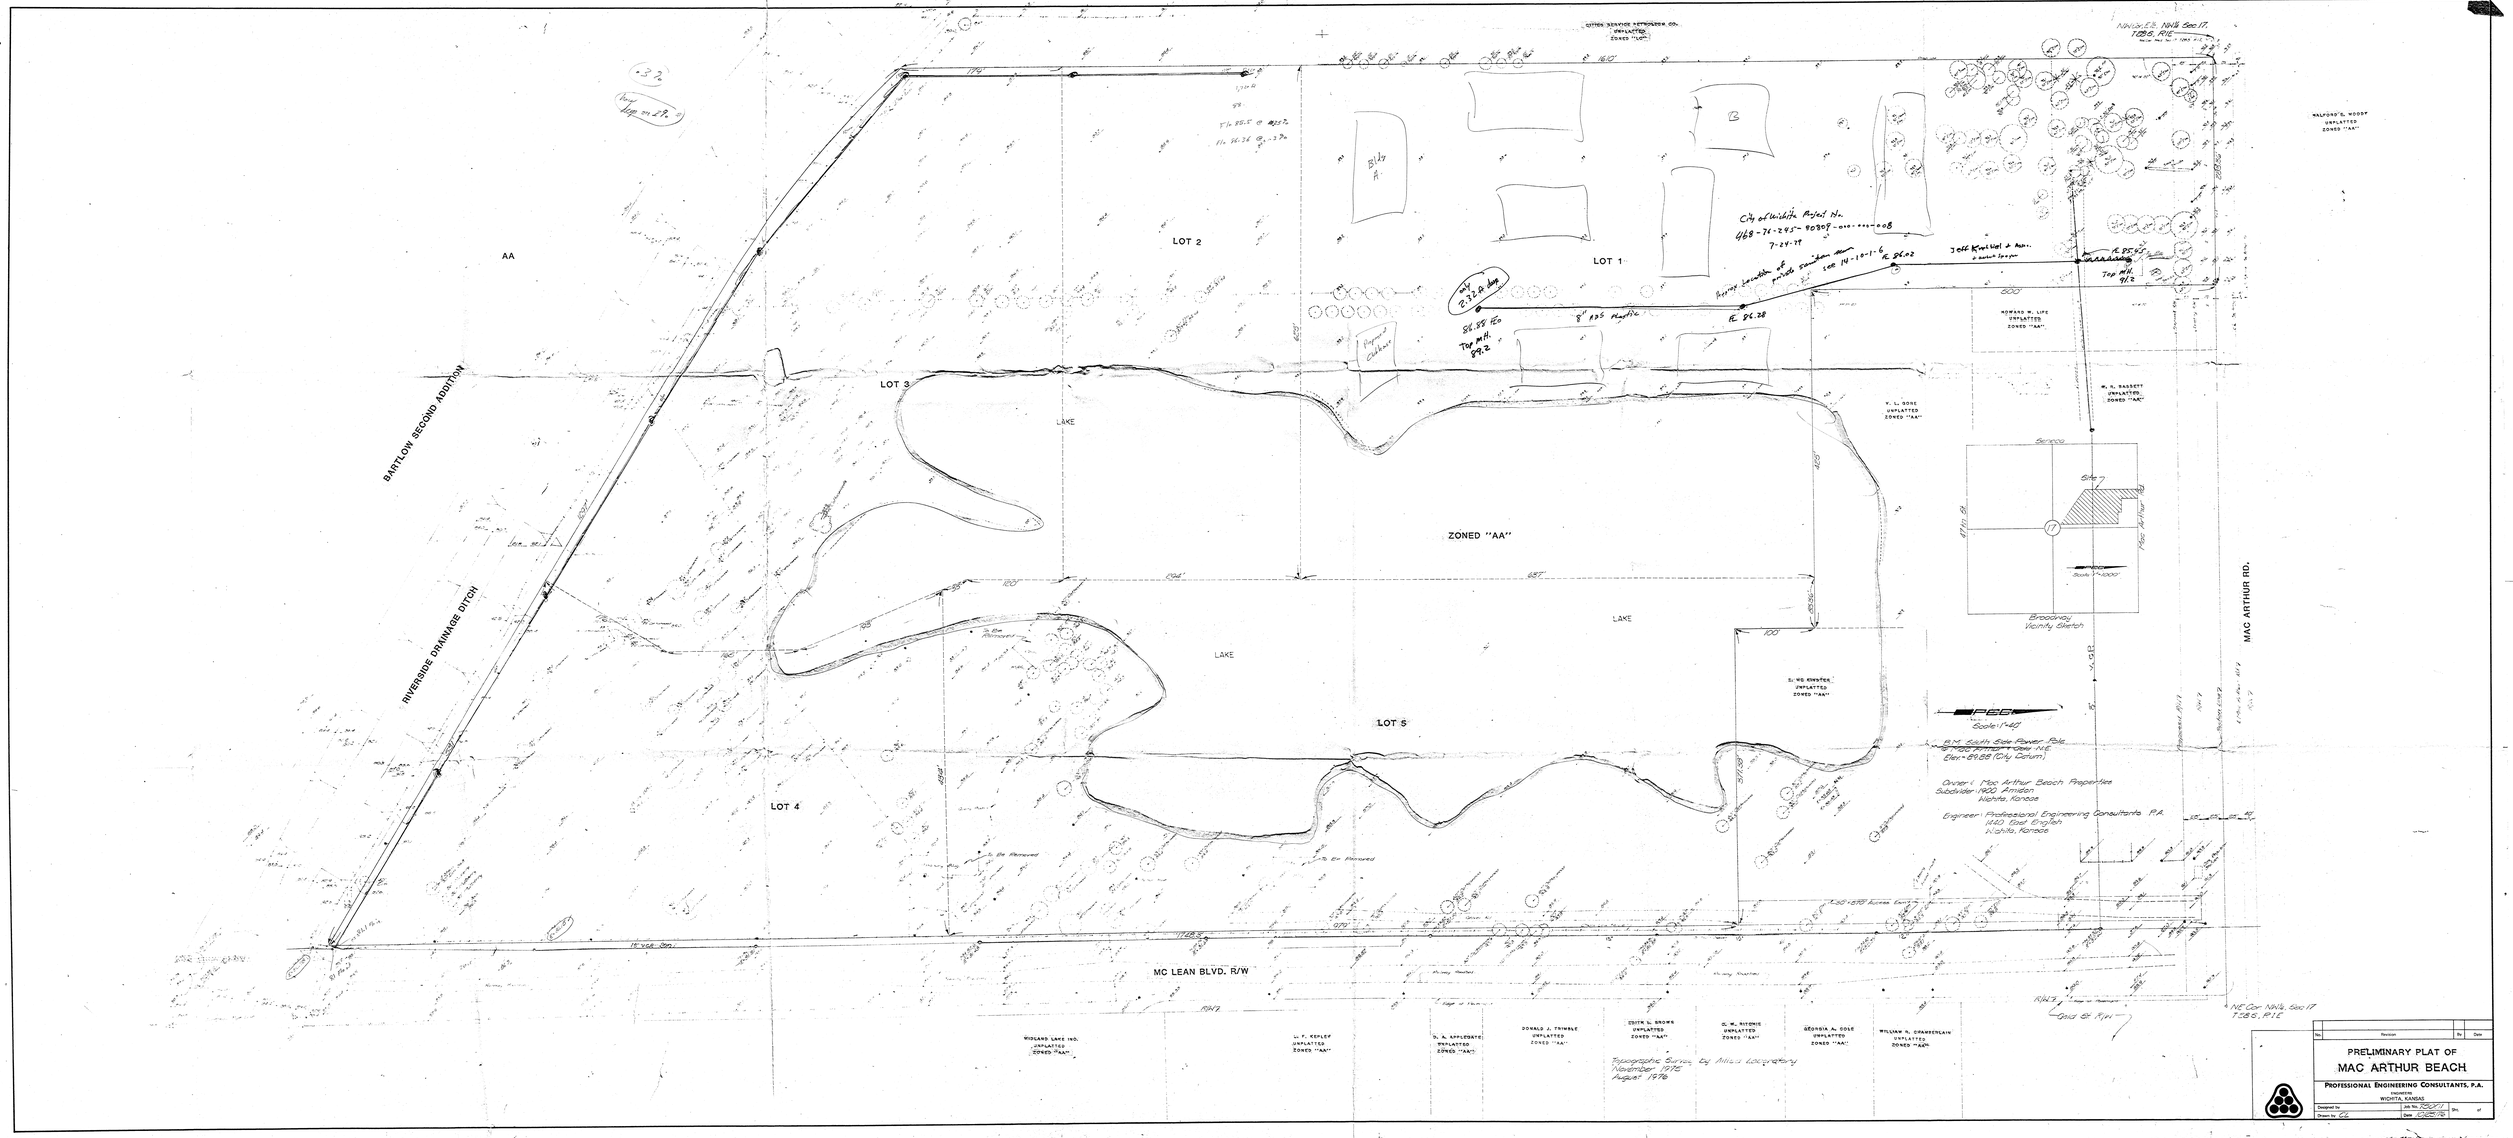
CITIES SERVICE PETROLEUM CO.
UNPLATTED
ZONED "LI"
NW Cor NW¼ Sec 17
T28S, R1E
WALFORD E. WOODY
UNPLATTED
ZONED "AA"
AA
LOT 2
LOT 1
LOT 3
LOT 4
LOT 5
LAKE
ZONED "AA"
BARTLOW SECOND ADDITION
RIVERSIDE DRAINAGE DITCH
MC LEAN BLVD. R/W
MAC ARTHUR RD.
HOWARD W. LIFE
UNPLATTED
ZONED "AA"
W. H. BASSETT
UNPLATTED
ZONED "AA"
V. L. BONE
UNPLATTED
ZONED "AA"
S. WG. KNAYER
UNPLATTED
ZONED "AA"
Bldg A
Bldg B
City of Wichita Project No.
468-74-295-90808-000-000-008
7-29-77
Joe Knobel & Assn.
8" ABS Pipe
Top M.H. 89.2
Top M.H. 91.2
Broadway
Vicinity Sketch
Scale: 1"=1000'
Scale: 1"=40'
P.O.B.
P.M. South Side Power Pole
Elev.=89.88 (City Datum)
Owner: Mac Arthur Beach Properties
Subdivider: 1820 Amelon
Wichita, Kansas
Engineer: Professional Engineering Consultants P.A.
1420 East English
Wichita, Kansas
Topographic Survey by Allied Laboratory
November 1975
August 1976
NE Cor NW¼ Sec 17
T28S, R1E
Gold St R/W
WIDLAND LAKE IND.
UNPLATTED
ZONED "AA"
L. F. KEFLER
UNPLATTED
ZONED "AA"
D. A. APPLEGATE
UNPLATTED
ZONED "AA"
DONALD J. TRIMBLE
UNPLATTED
ZONED "AA"
EDITH L. BROWN
UNPLATTED
ZONED "AA"
C. W. BITONIS
UNPLATTED
ZONED "AA"
GEORGIA A. GOLE
UNPLATTED
ZONED "AA"
WILLIAM H. CRAMPENLAIN
UNPLATTED
ZONED "AA"
PRELIMINARY PLAT OF
MAC ARTHUR BEACH
PROFESSIONAL ENGINEERING CONSULTANTS, P.A.
ENGINEERS
WICHITA, KANSAS
Revision
Date
Designed by
Drawn by
Job No.
Date
Dr.
of