


Drainage plan

0-21-83

A 191
C 176

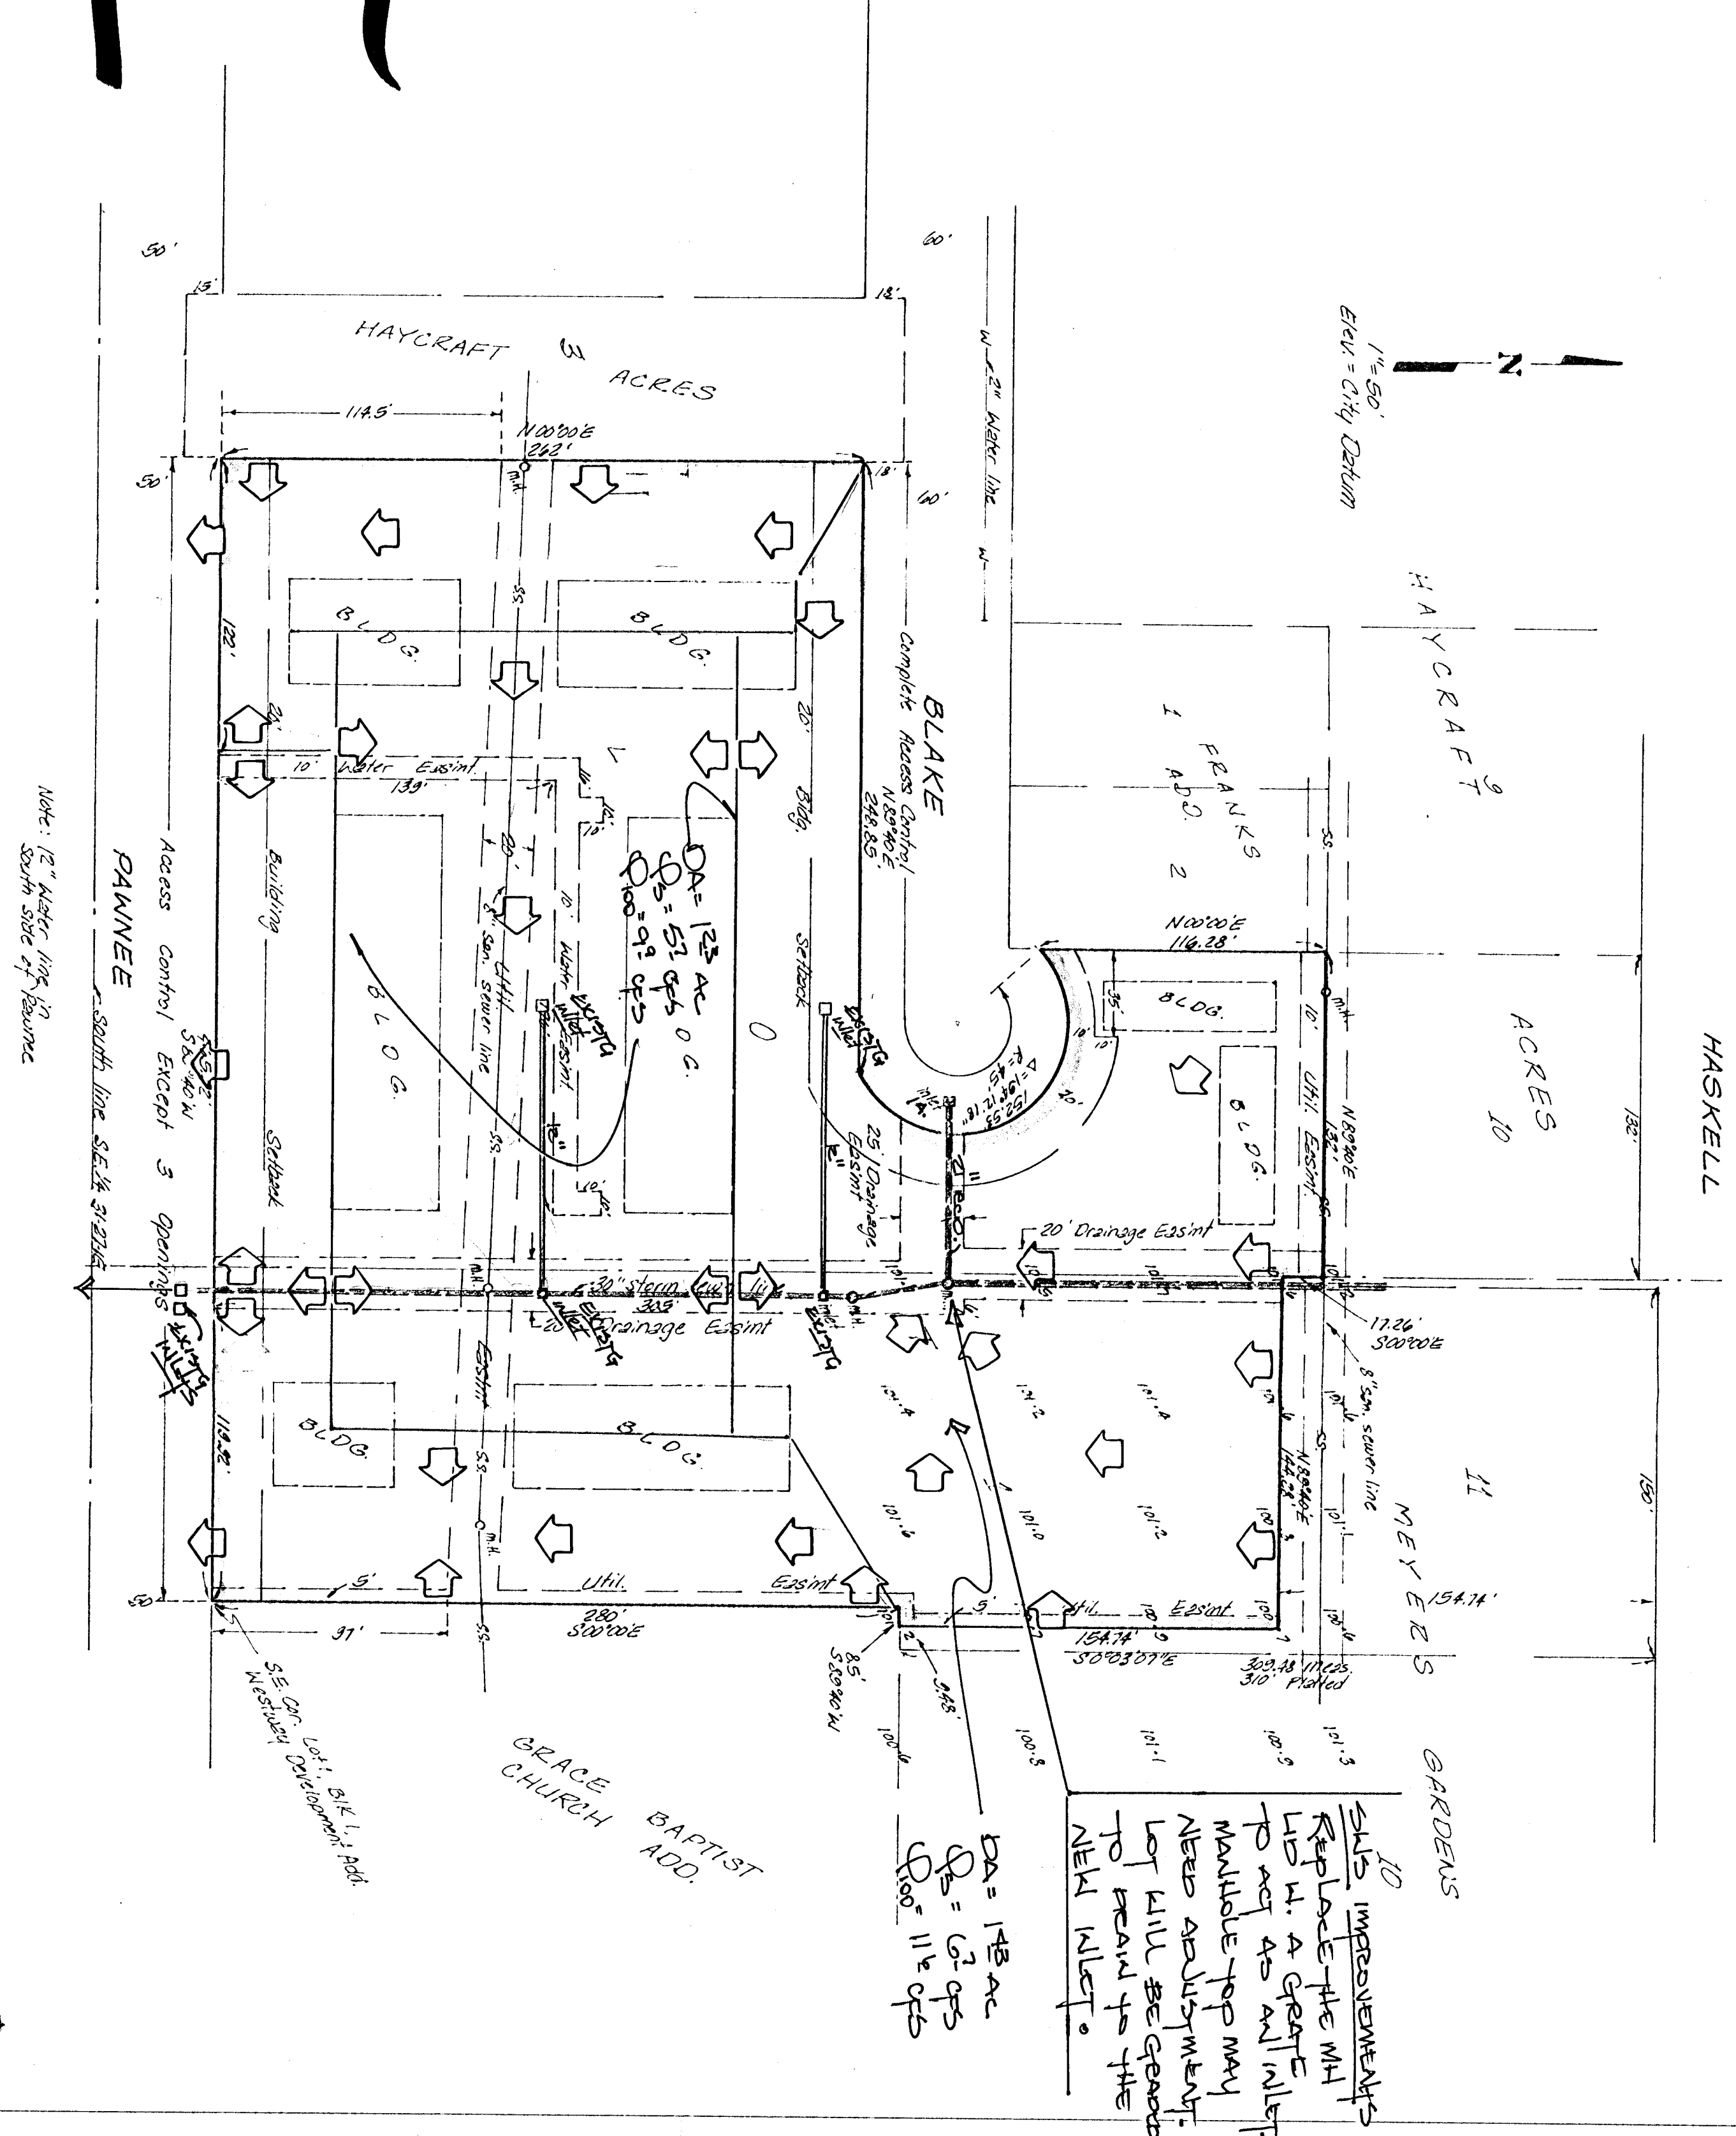

SKETCH PLAT
WESTWAY DEVELOPMENT 2ND ADDITION
 LOT 1, BLOCK 1, WESTWAY DEVELOPMENT ADDITION
 & THE S. 1/2 OF THE WEST 1/4 32 FEET OF LOT 11,
 MEYERS GARDENS
 OWNER: WESTWAY DEVELOPMENT, A KANSAS PARTNERSHIP

BAUGHMAN COMPANY, P.A.
 SURVEYING & ENGINEERING
 316/283-7271 • 300 LAURA • WICHITA, KANSAS 67211

Oct. 14, 1983