SOUTH LAKE 3RD. ADDITION

WICHITA, KANSAS

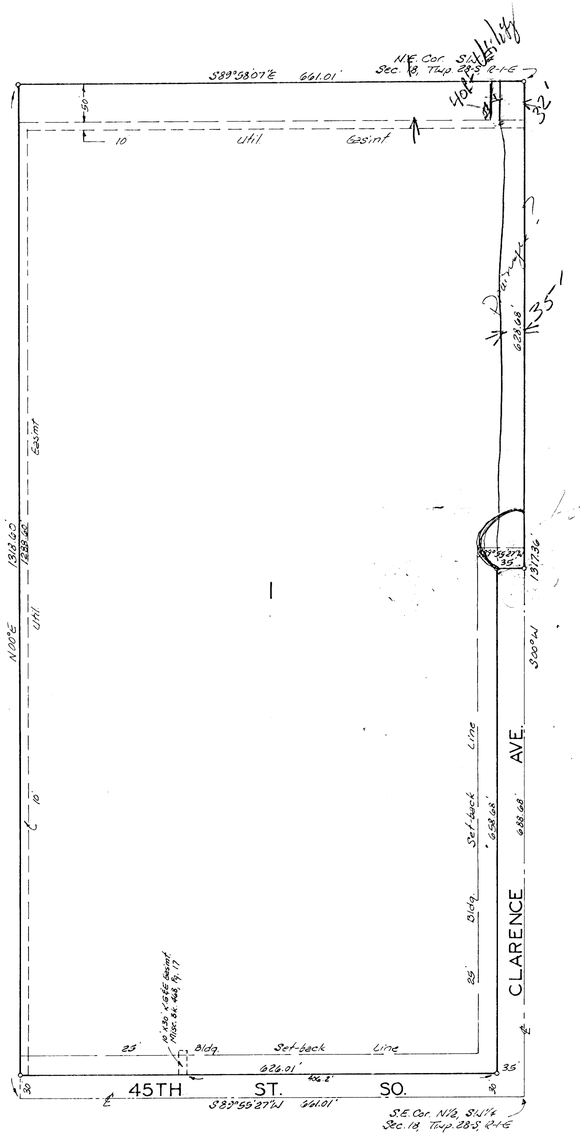

N

1" = 100'
o = iron

State of Kansas } S.S.
Sedgwick County }

We Baughman Company P.A., surveyors in aforesaid county and state do hereby certify that we have surveyed and platted "SOUTH LAKE 3RD. ADDITION", Wichita, Kansas and that the accompanying plat is a true and correct exhibit of the property surveyed described as the east 20 acres of the N½ of the SW¼ of Sec. 18, Twp. 28-S, R-1-E of the 6th. P.M., Sedgwick County, Kansas.

Baughman Company, P.A.

Date

William L. Korber — Surveyor

Know all men by these presents that we, the undersigned, have caused the land described in the surveyors certificate to be platted into a Lot and Streets to be known as "SOUTH LAKE 3RD. ADDITION", Wichita, Kansas. The easements are hereby granted as indicated for the construction and maintenance of all public utilities. The streets are hereby dedicated to and for the use of the public.

Melvin L. Davis — Barbara L. Davis

State of Kansas } S.S.
Sedgwick County }

The foregoing instrument was acknowledged before me, this ____ day of ____ 198__, by Melvin L. Davis and Barbara L. Davis his wife.

Notary Public

My App't. Exp. ____

This plat of "SOUTH LAKE 3RD. ADDITION", Wichita, Kansas, has been submitted to and approved by the Wichita-Sedgwick County Metropolitan Area Planning Commission, Wichita, Kansas Dated this ____ day of ____ 198__.
Wichita-Sedgwick County Metropolitan Area Planning Commission.

Robert K. Chisholm — Chairman

Robert A. Lakin — Secretary

This plat approved and all dedications shown hereon accepted by the Board of Commissioners of the City of Wichita, Kansas, this ____ day of ____ 198__

Marpalee Wright — Mayor

Donald C. Gisick — City Clerk

This plat approved and all dedications shown hereon accepted by the Board of Commissioners, Sedgwick County, Kansas, this ____ day of ____ 198__.

Jack Spratt — Chairman

Donald E. Gragg — Commissioner

Tom Scott — Commissioner

Dorothy K. White — County Clerk

Entered on transfer record this ____ day of ____ 198__.

Dorothy K. White — County Clerk

State of Kansas } S.S.
Sedgwick County }

This is to certify that this plat has been filed for record in the office of the Register of Deeds this ____ day of ____ 198__, at ____ o'clock ____ M; and is duly recorded.

Bette F. McCart — Register of Deeds

Pat Kettler — Deputy