


SOUTH PARK ADDITION

TO WICHITA, SEDGWICK CO., KANSAS

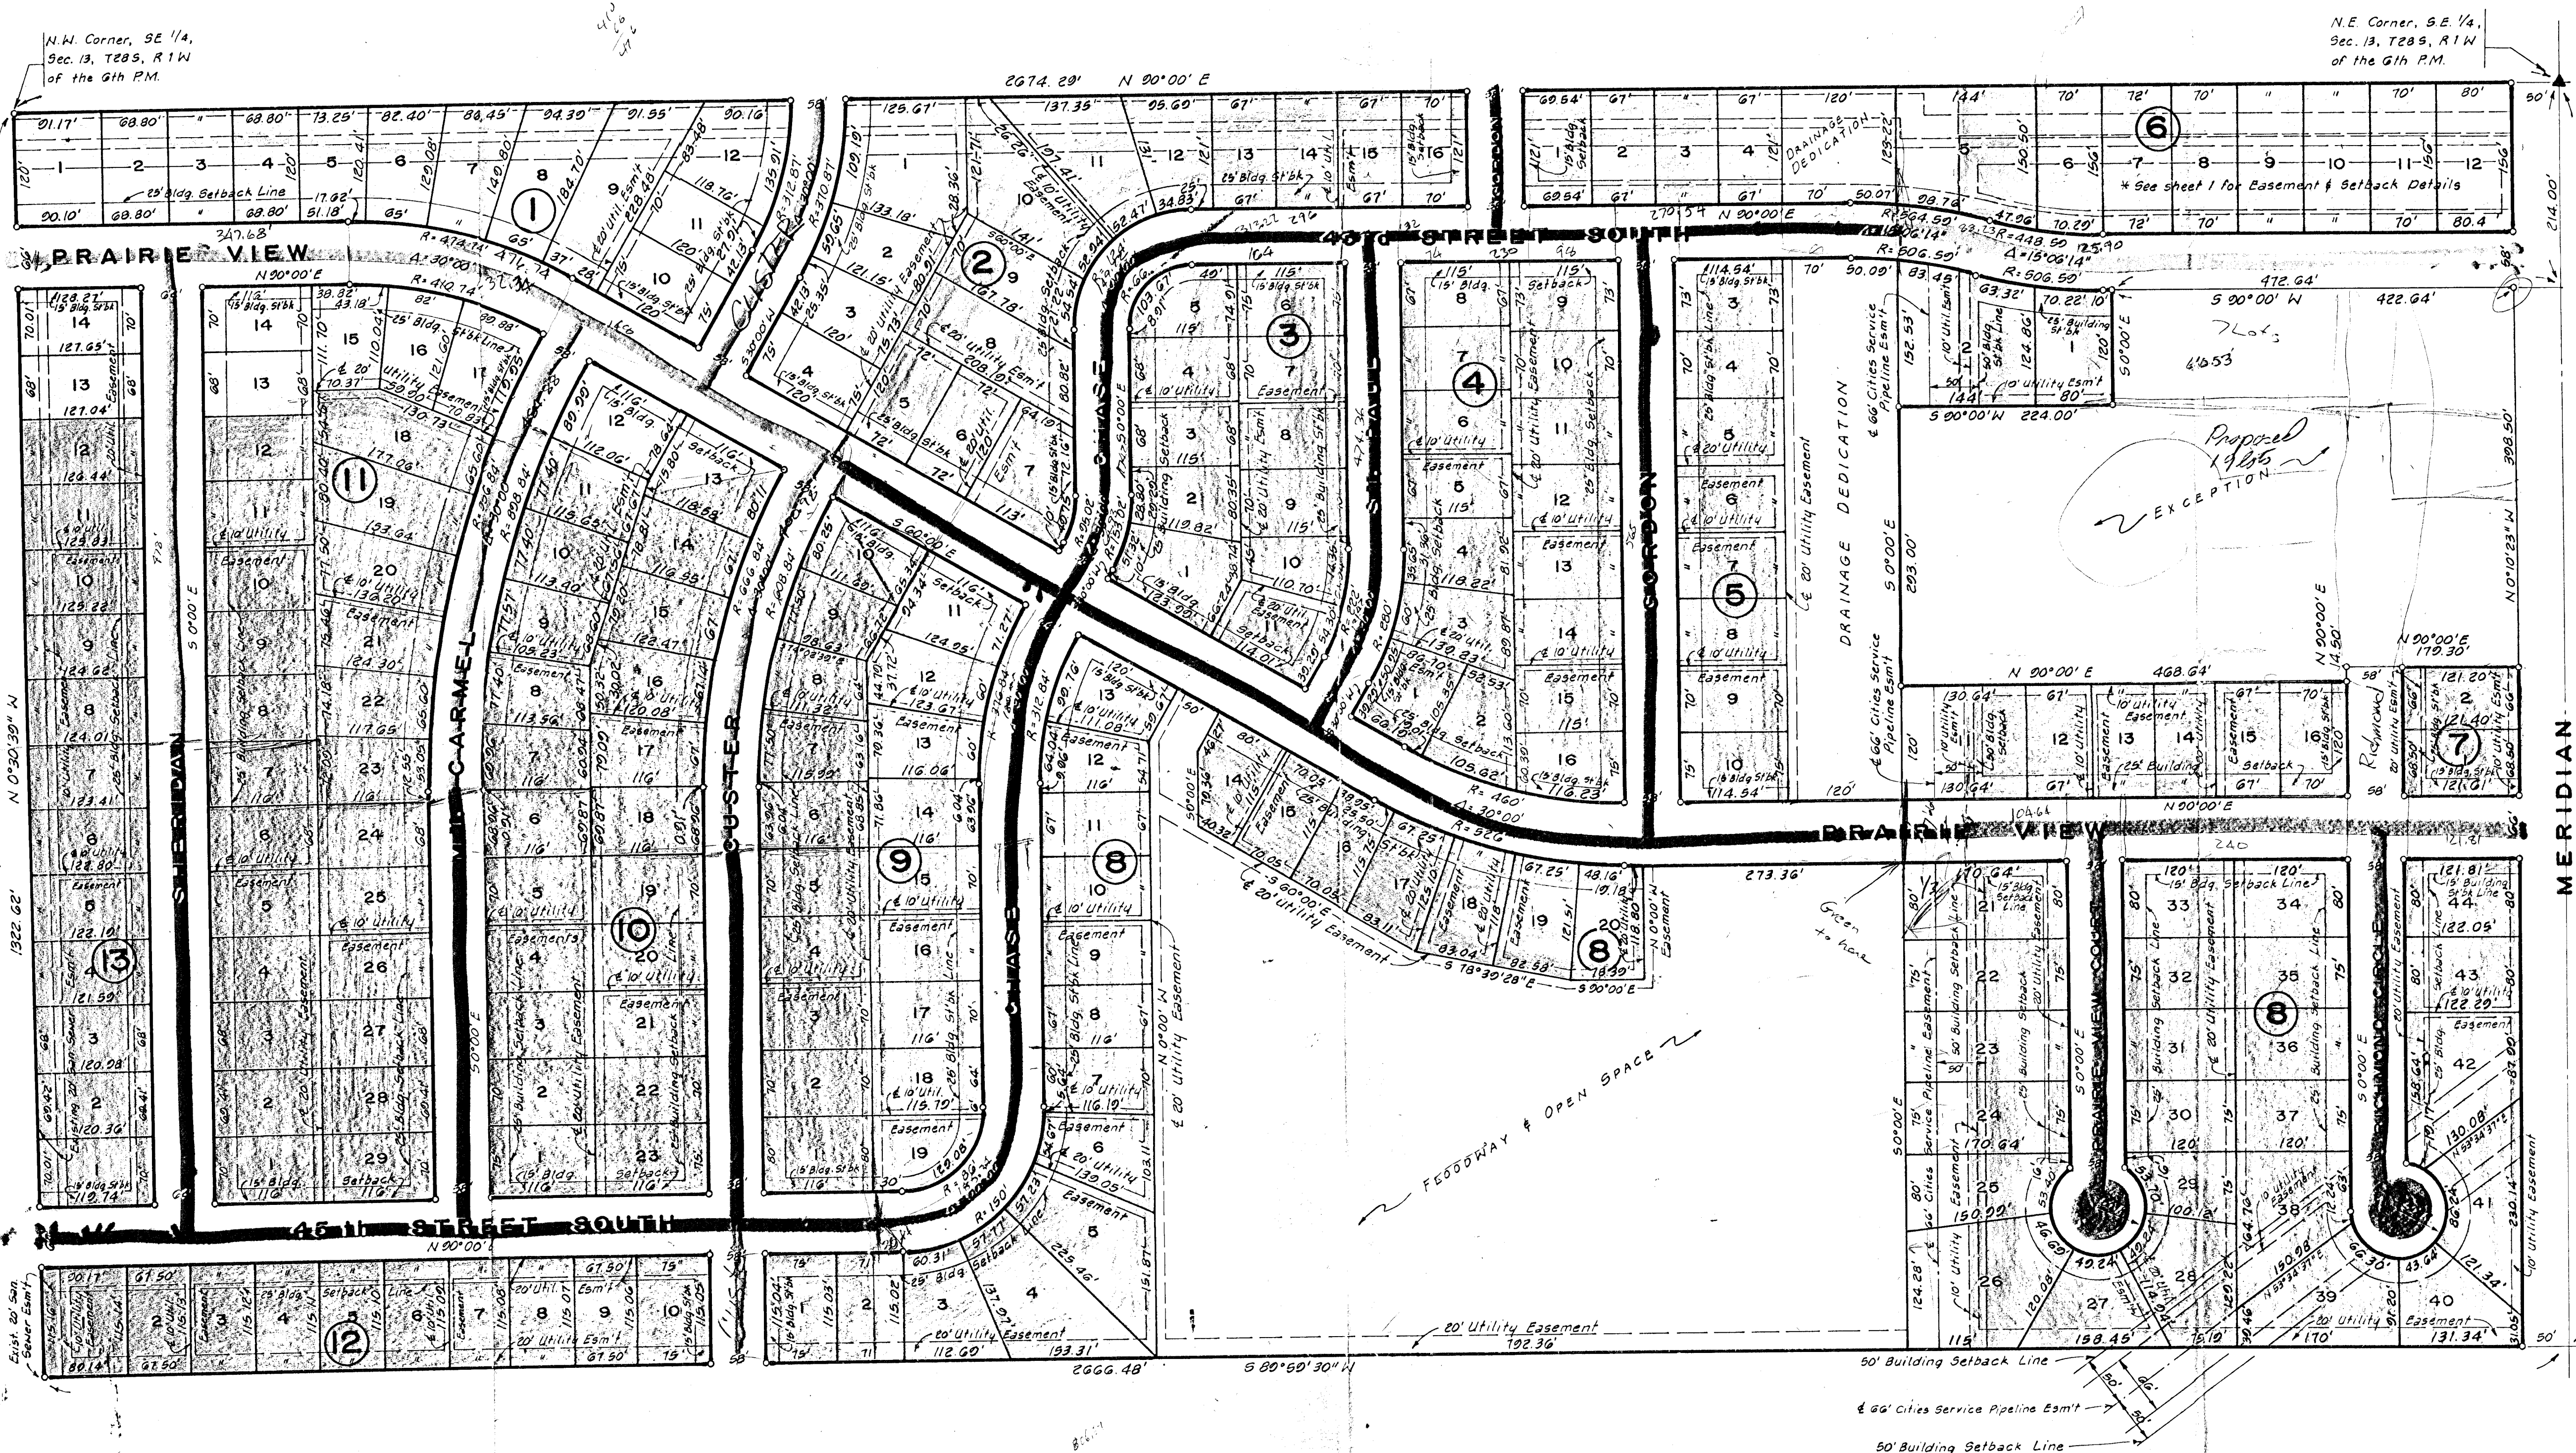

Scale: 1"=100'
September 10, 1980

B.M. - City Bench Mark Disc, 44' north and 30' east of E. 1/4 Corner. Elev. 93.30

- #1
- #2 ✓
- #3 ✓
- #4 ✓
- #5 ✓