


# SOUTH PARK ADDITION

TO WICHITA, SEDGWICK CO., KANSAS

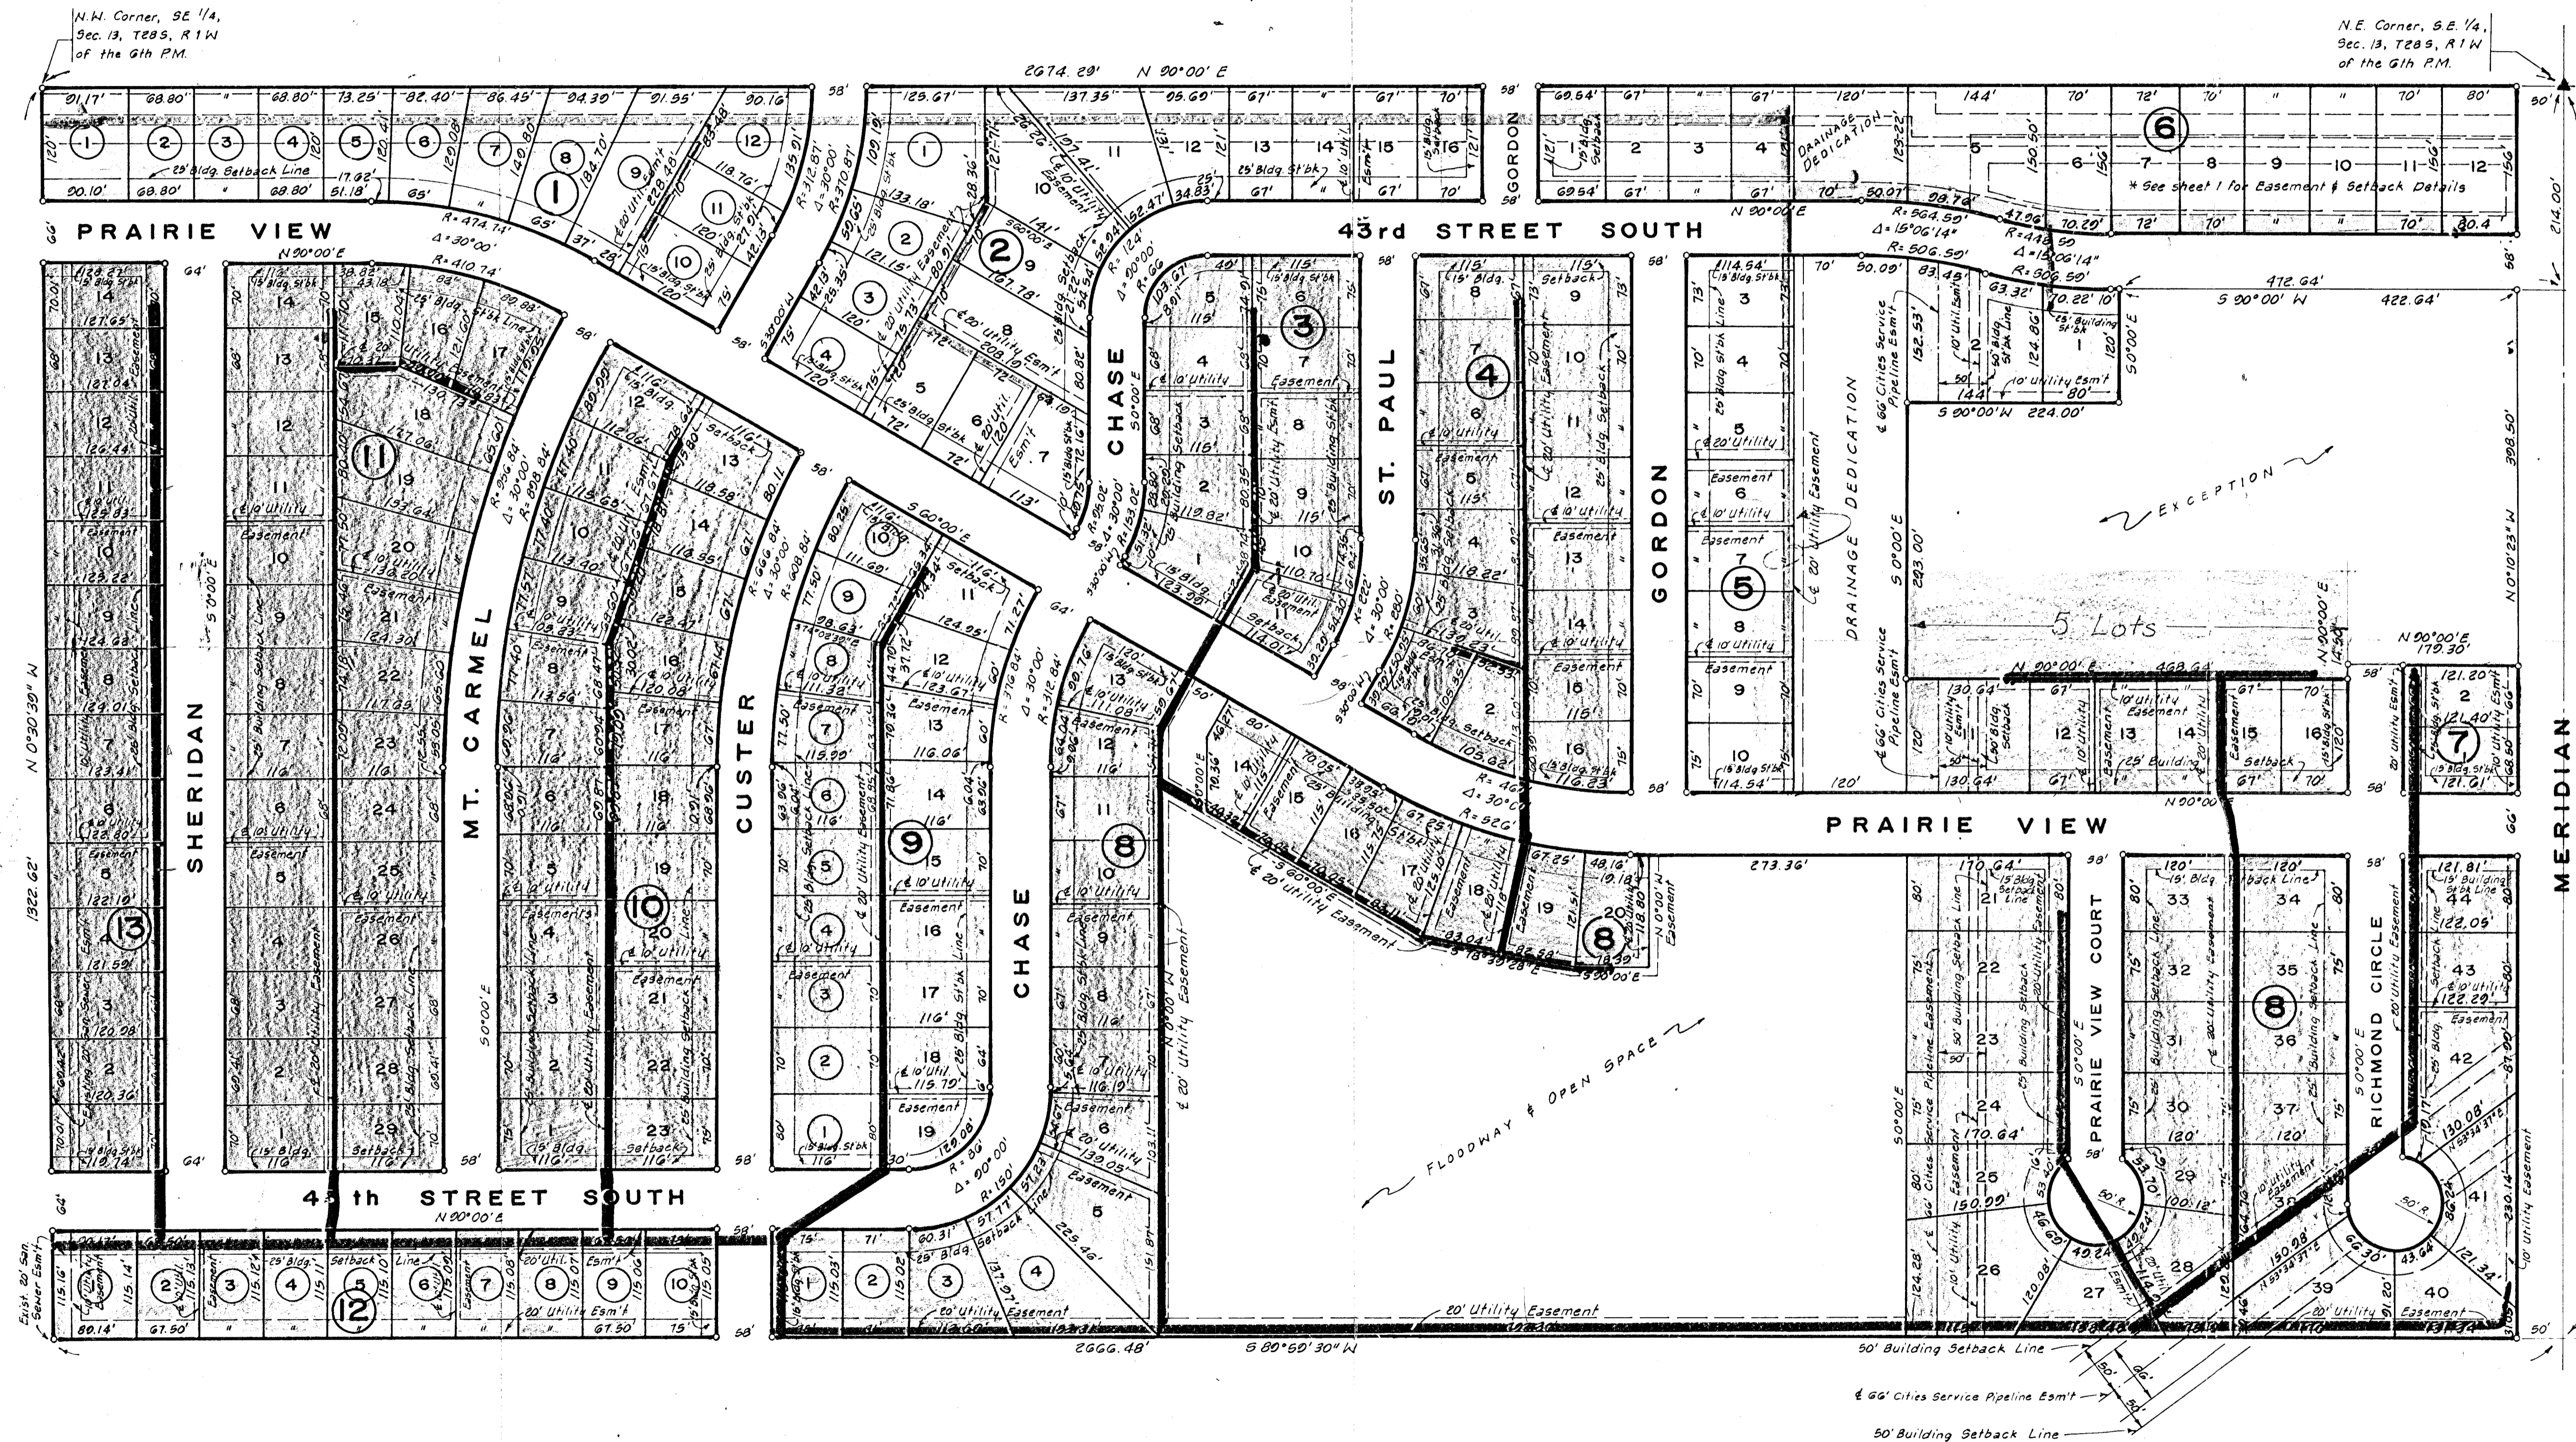

Scale: 1" = 100'  
September 10, 1980

B.M. - City Bench Mark Disc, 44'  
north and 30' east of E. 1/4  
Corner. Elev. 93.30