PRELIMINARY PLAT

SEDGWICK COUNTY ANDALE YARD

SEDGWICK COUNTY, KANSAS

DRAINAGE CONCEPT

GROSS ACREAGE=14.14
NET ACREAGE=13.60

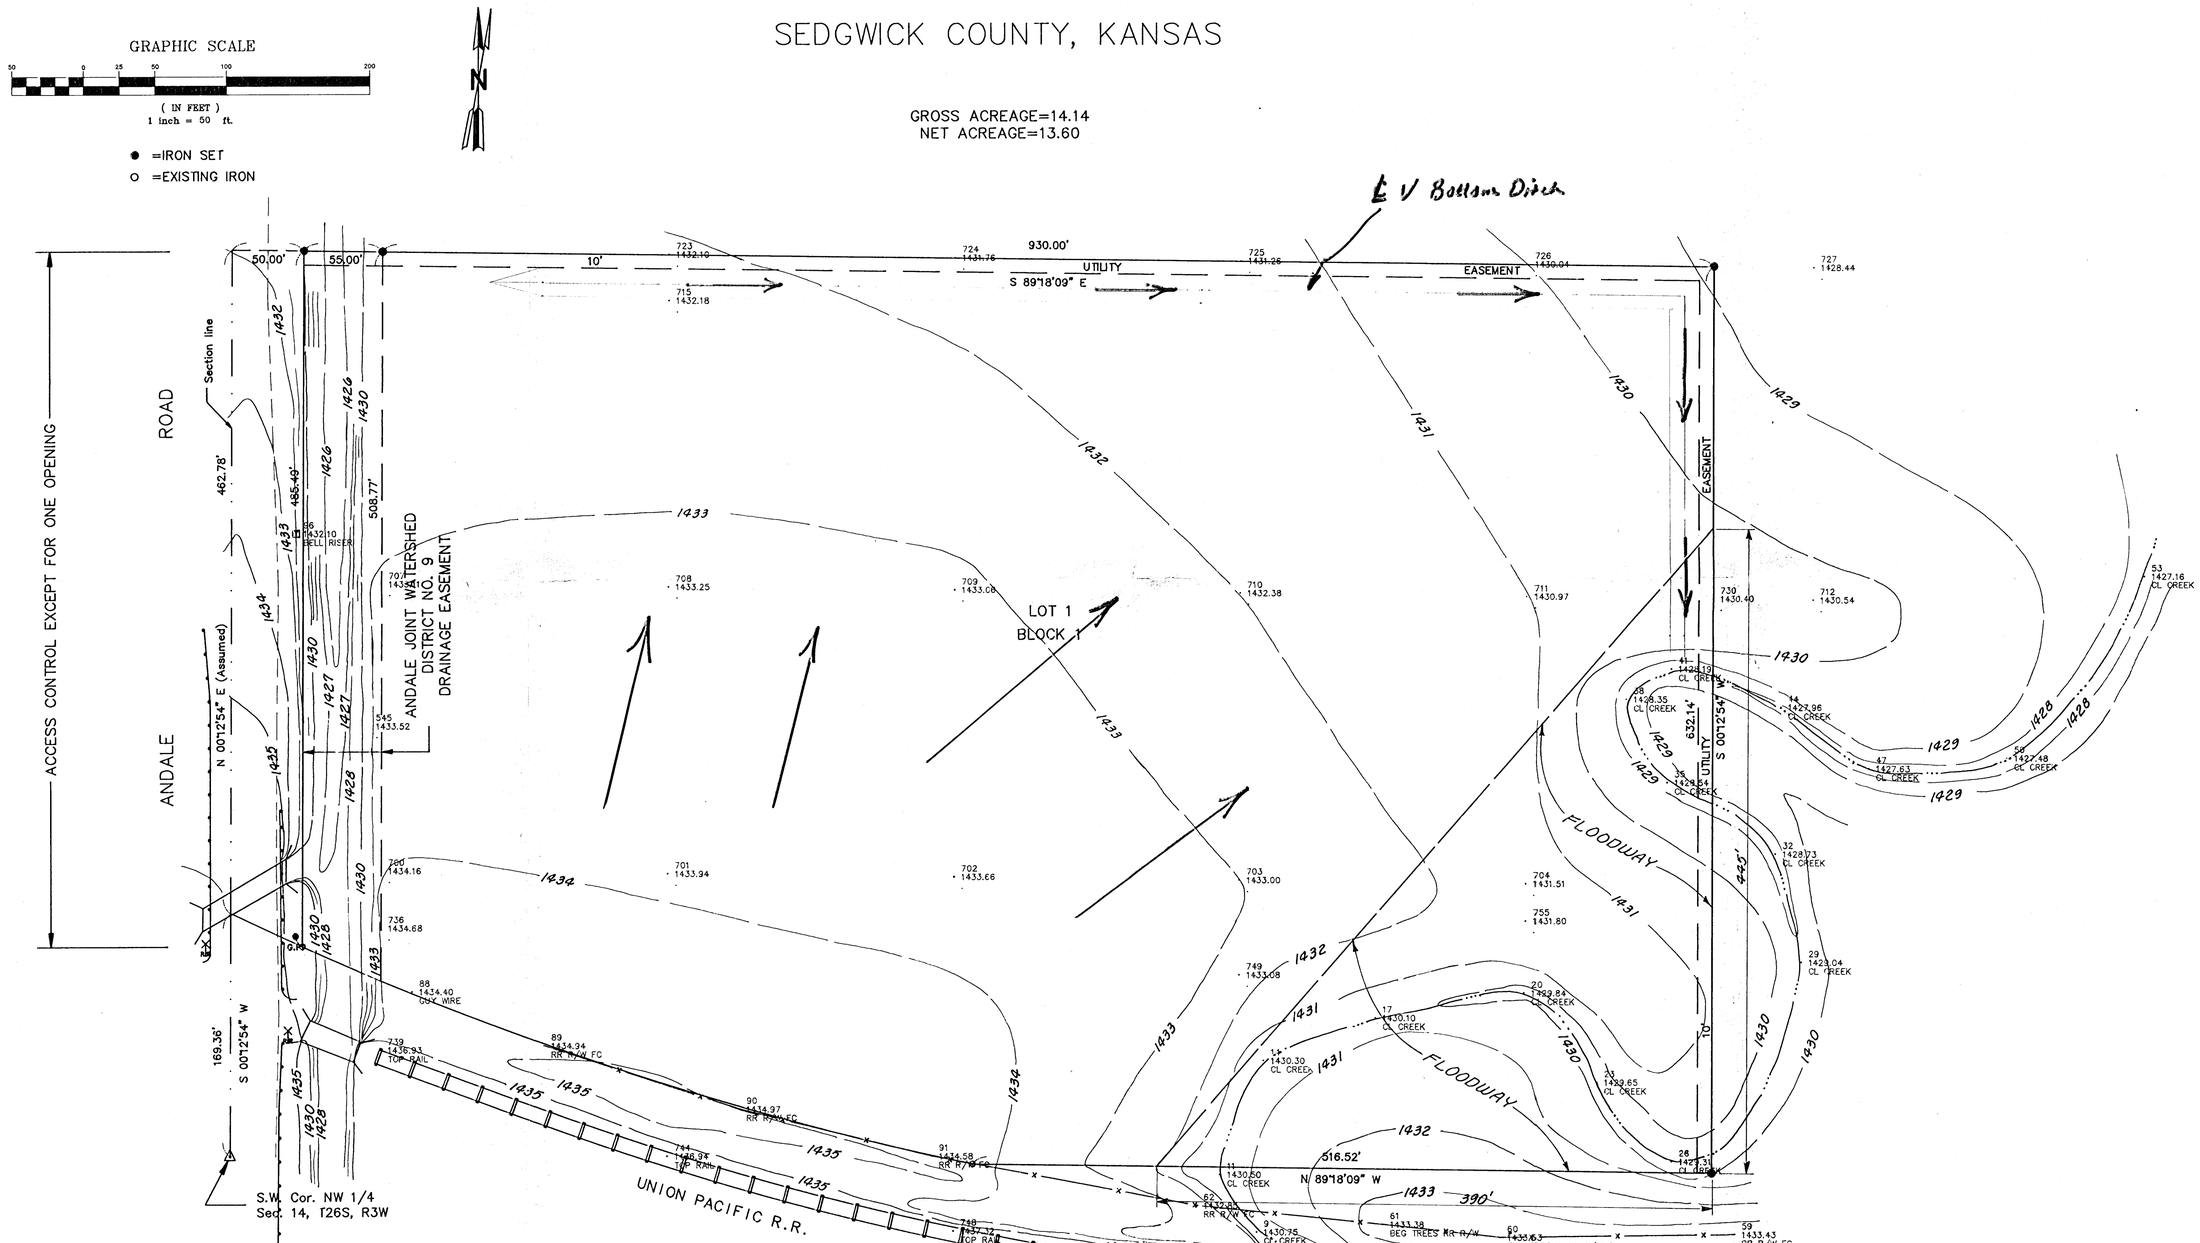

BENCHMARK– RR spike in P.P. 35.7' NW of W 1/4 corner Sec. 14, 26S, 3W
Elev.– 1436.94

PREPARED BY
SEDGWICK COUNTY BUREAU OF PUBLIC SERVICES
HIGHWAY DIVISION
DAVID C. SPEARS, P.E. DIRECTOR/COUNTY ENGINEER