
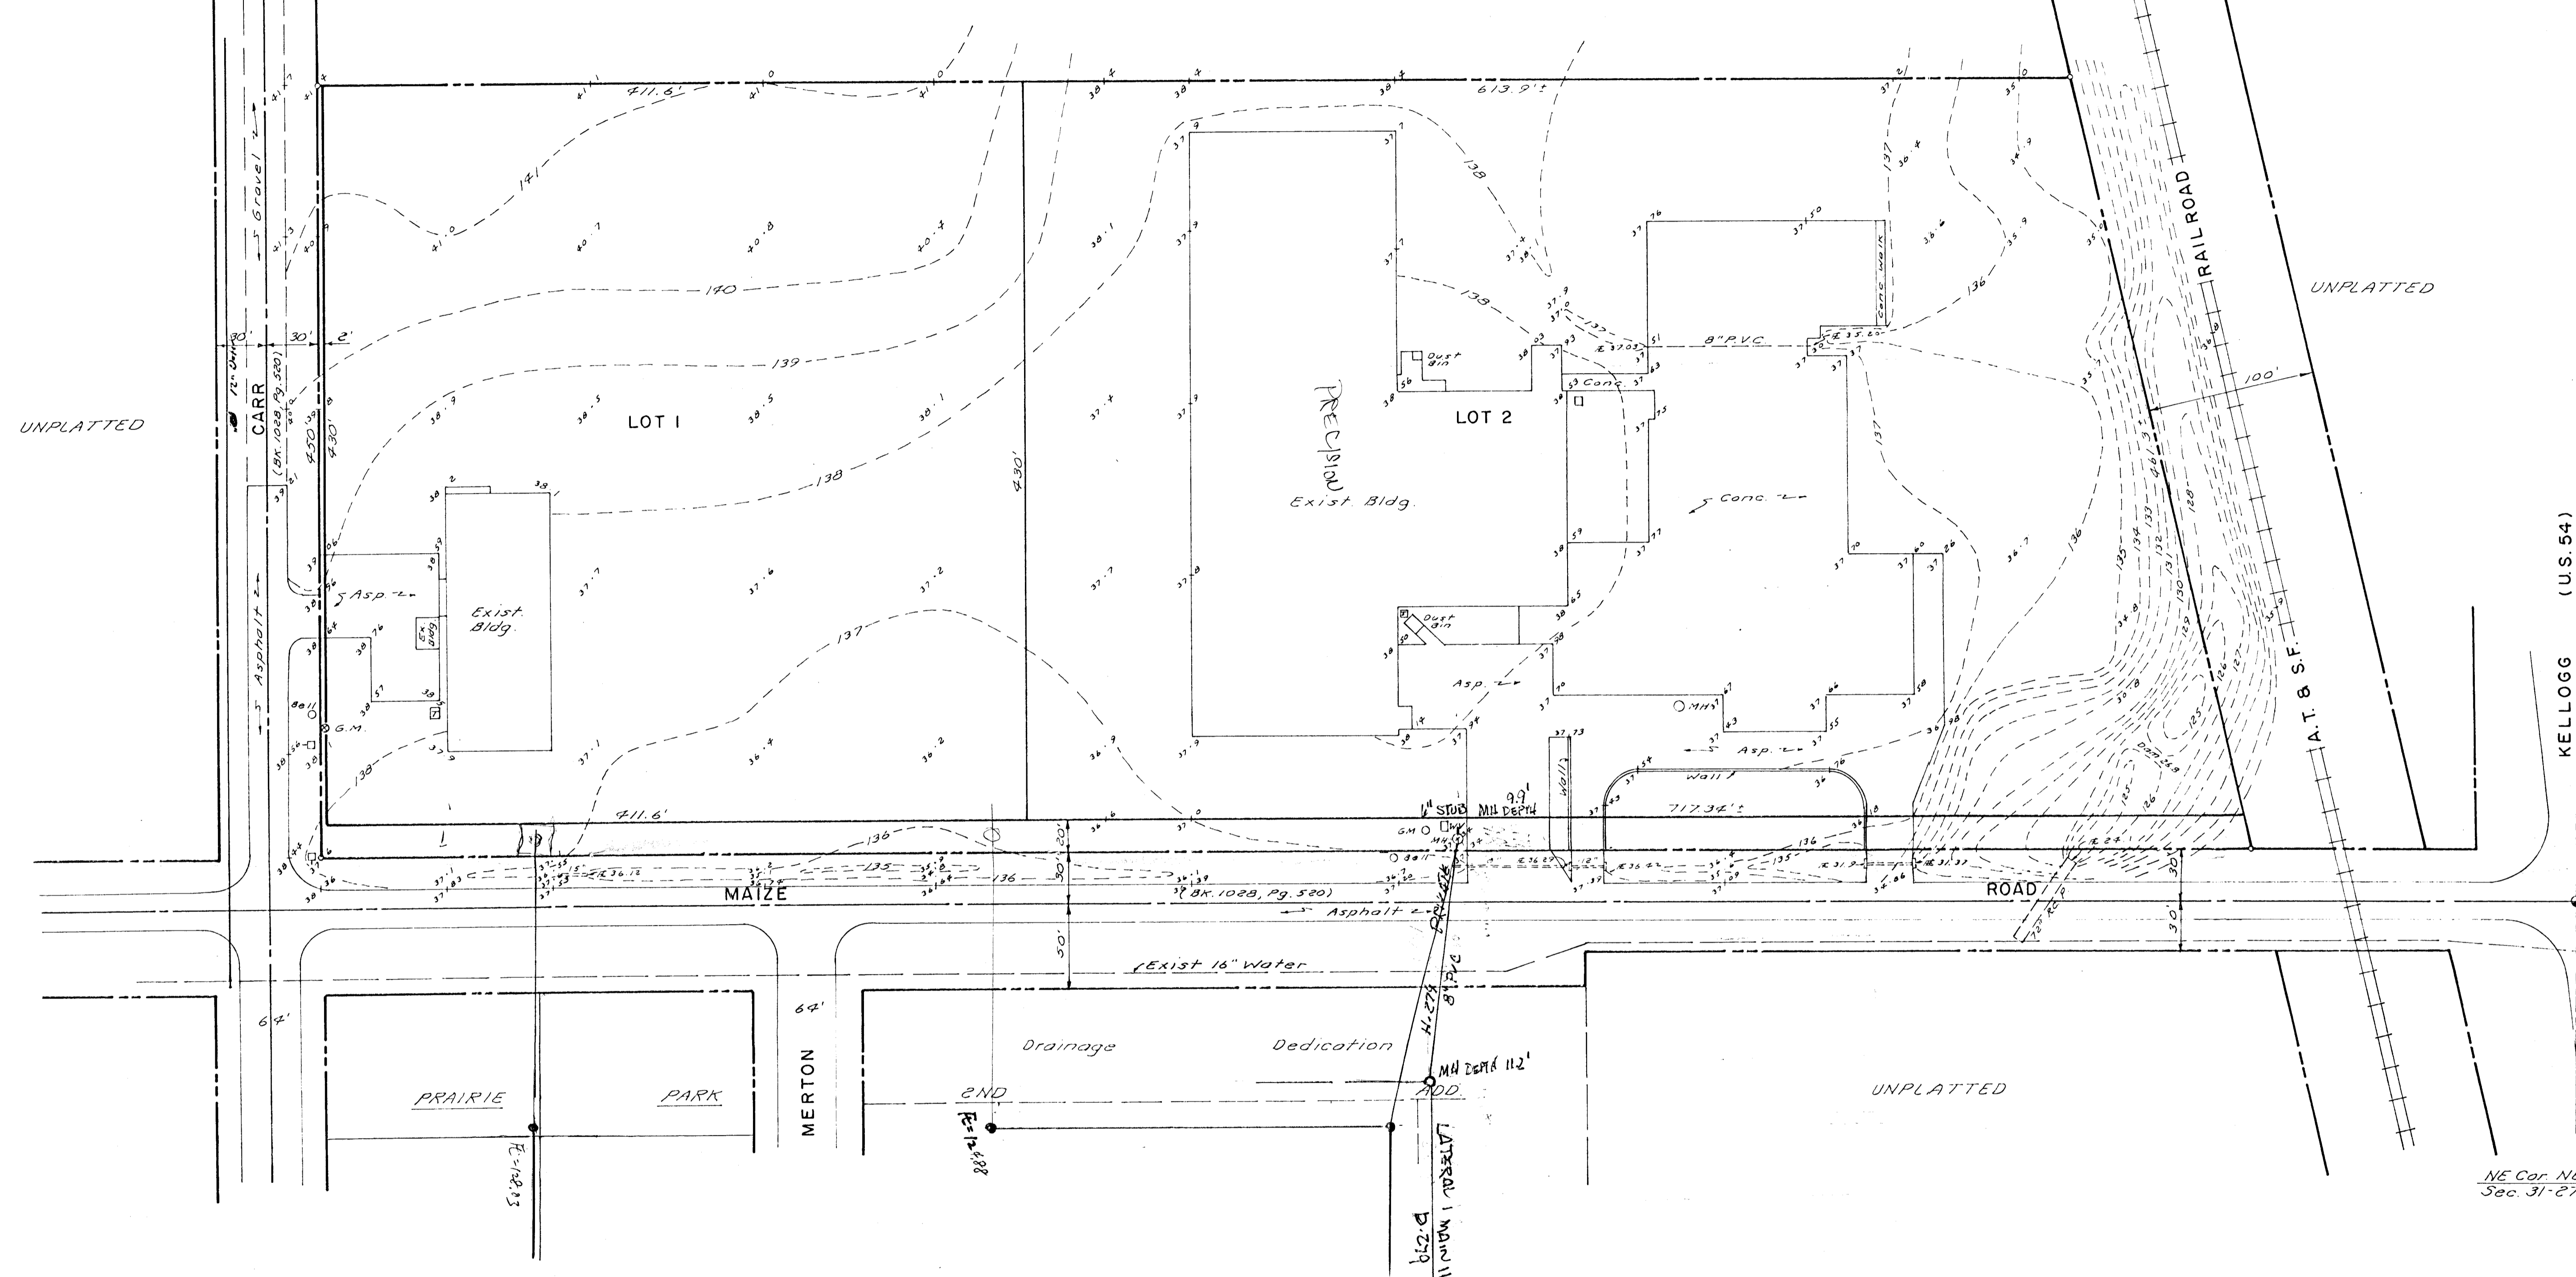


UNPLATTED

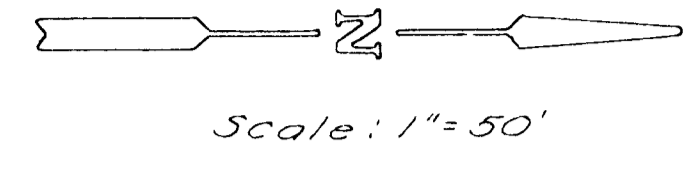

PRELIMINARY PLAT  
**MAIZE AVENUE ADDITION**  
PART OF THE NE 1/4 OF SEC. 31-27-1W

B.M. - City disc, center of median  
40' E. & Maize & U.S. 54  
Elev. 136.97

Aug. 1, 1985  
**BAUGHMAN COMPANY, P.A.**  
SURVEYING & ENGINEERING  
316/262-7271 • 330 LAURA • WICHITA, KANSAS 67211