



1.8/14.0
1.8/18.6
2.0' dwp
1.8' wack

HOOVER ROAD

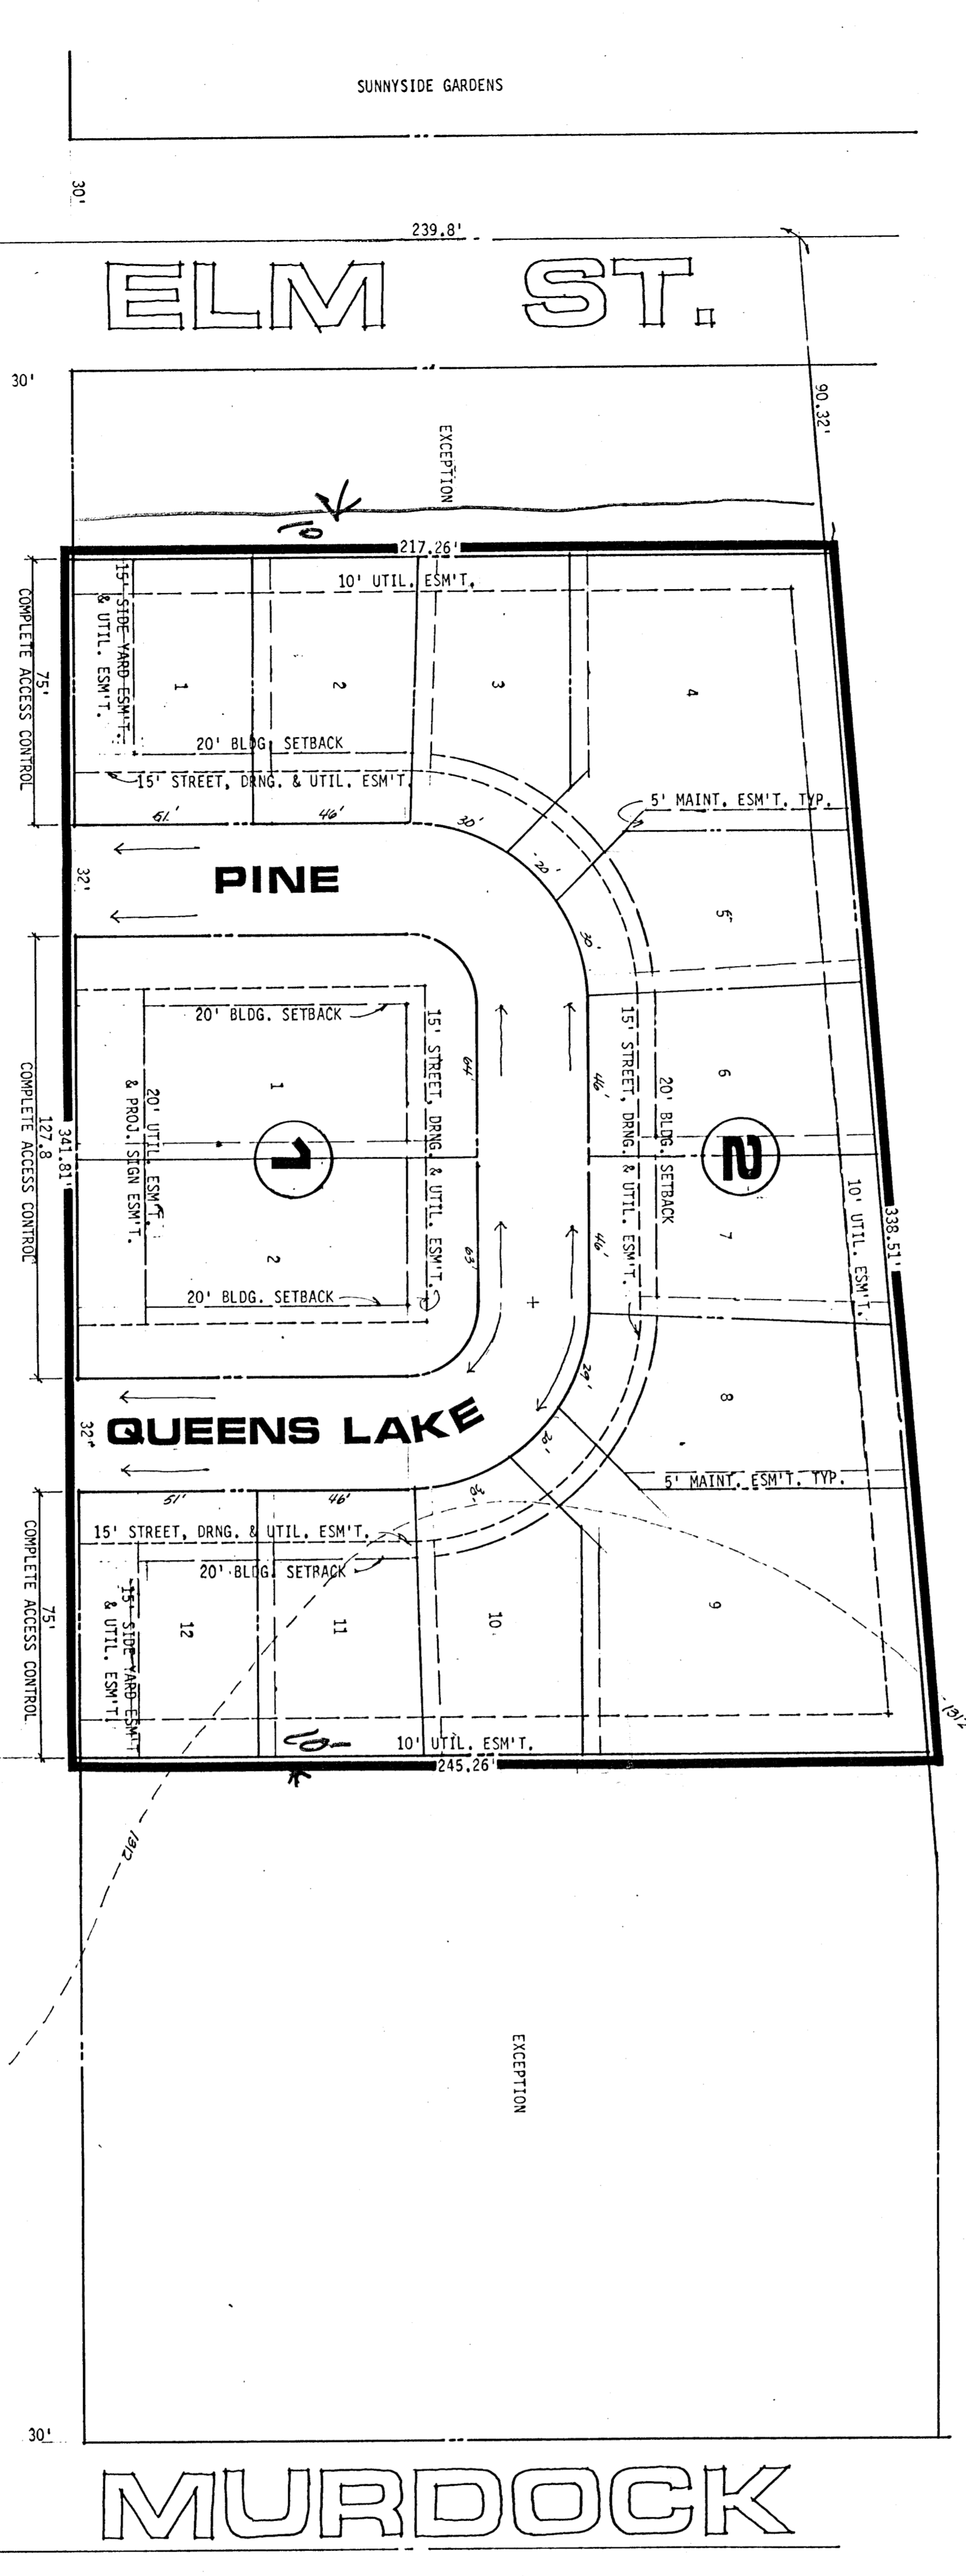

INTERSTATE I-235

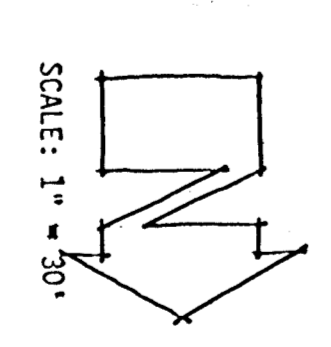

Preliminary Plat
PINE COVE