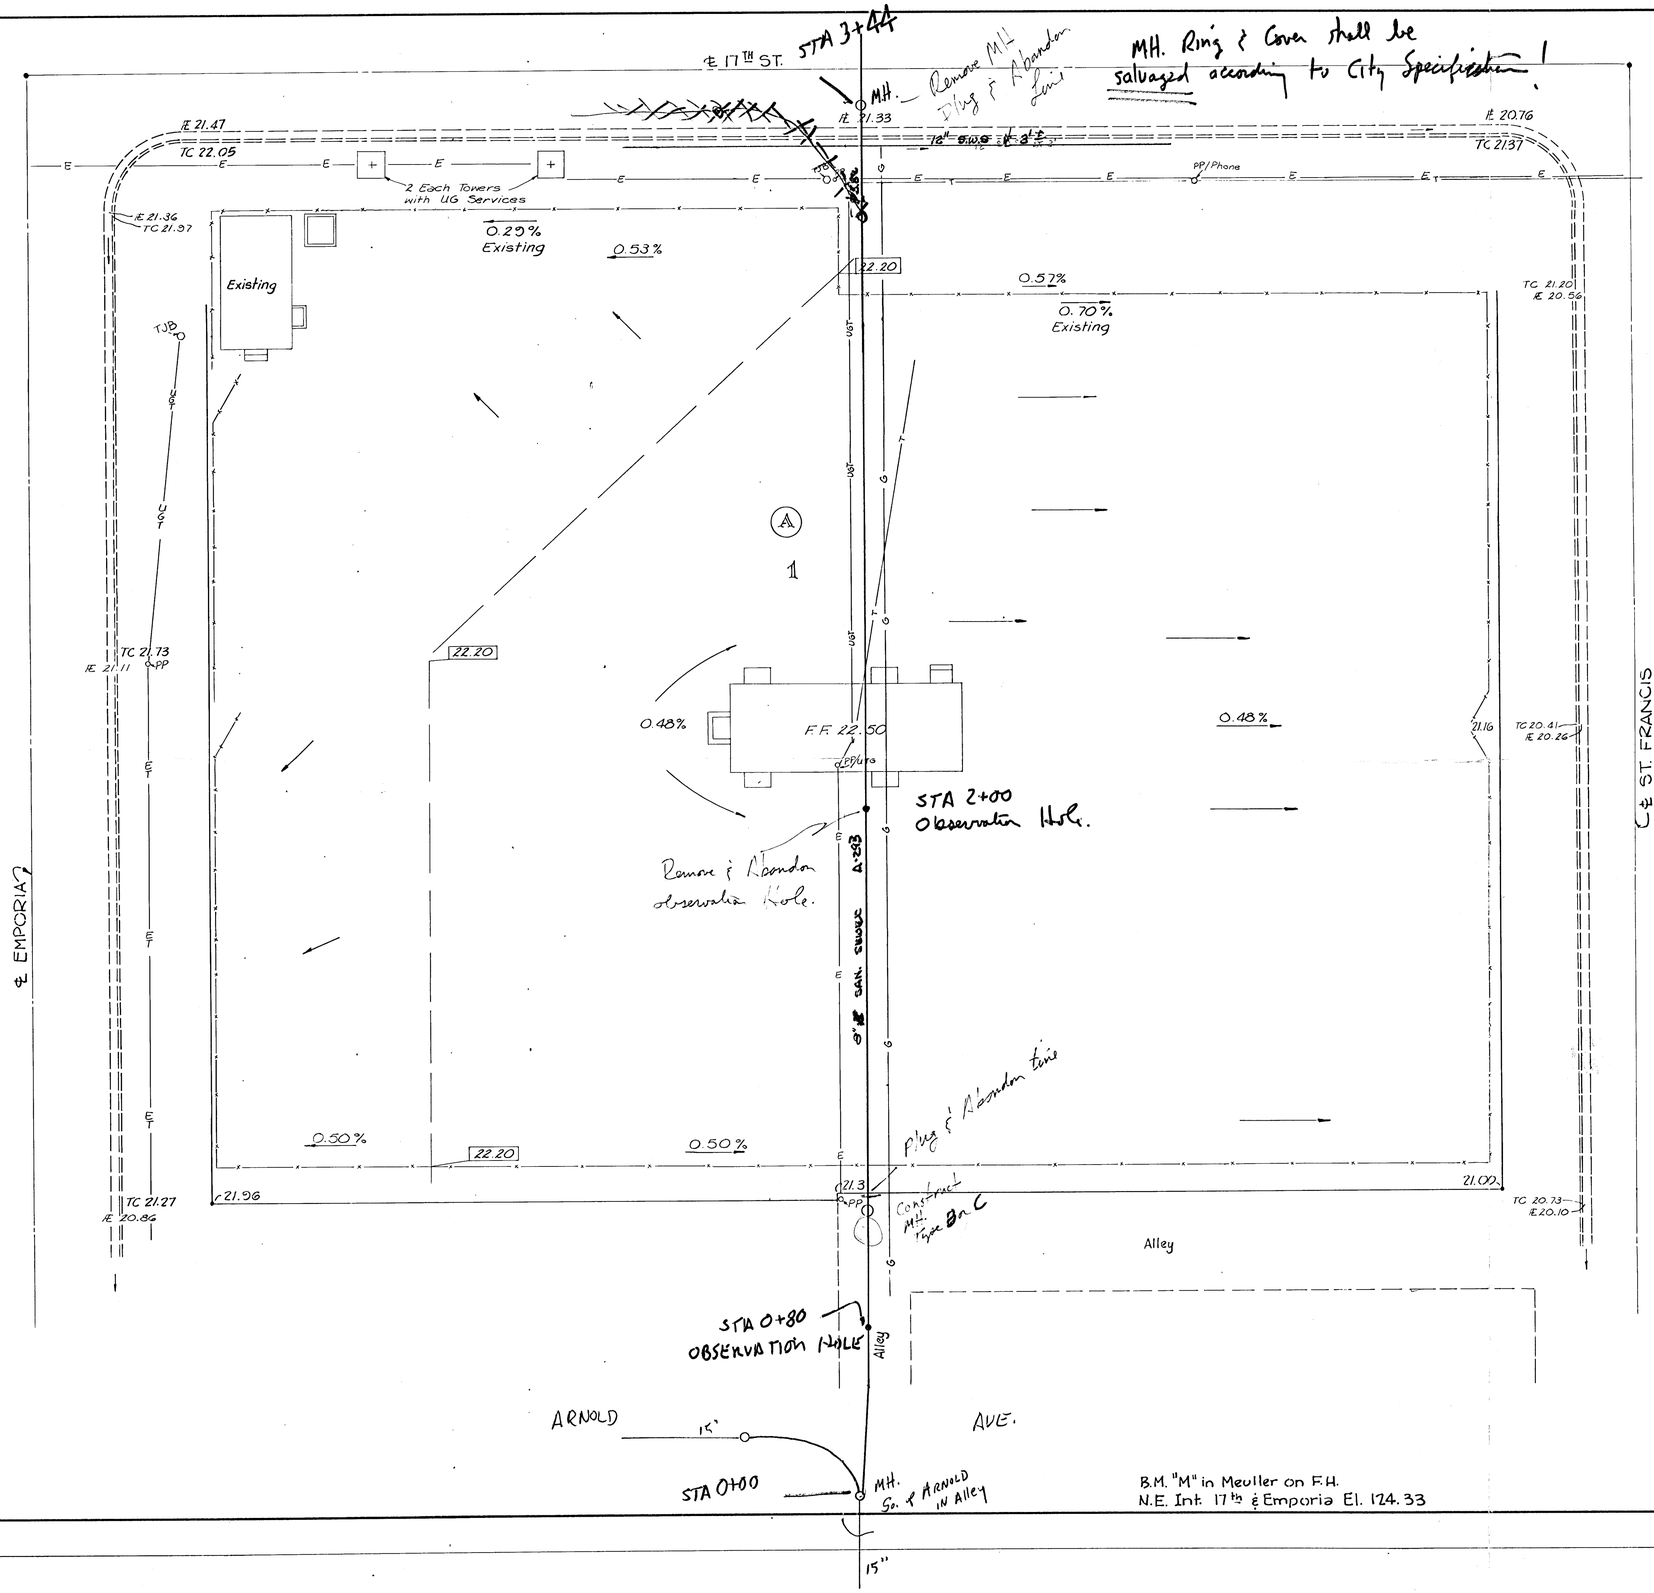

Contact Central Inspection Division (C.I.D.) to record Seal offs for existing House Laterals in Area.

LEGEND

- 0.00 = Finish Grade Elev.
- 00.00 = Existing Grade
- —→ = Flow Arrow
- ——— = Break Line
- —T— = Telephone Line
- —UGT— = Underground Telephone Cable
- —G— = 3" Gas Line (Gas Service Co.)

SKETCH PLAT

KANSAS GAS AND ELECTRIC COMPANY
WICHITA, KANSAS

DRAINAGE PLAN
17th St. SUBSTATION

Booker/Freund
Engineers Architects Planners

SCALE	DATE	DWG. NO.
1/16" = 1'	Dec., 1981	K-1043-201

SURV. | PLOT. | DES. | DR. | TR. | CKD. | APP.

N06208