

FOX POINTE

LOT 15

38 SHANNON WOODS?  
11744 B/L  
7394-3182


204 FOX POINTE  
11127-3237  
7550-7074

203 FOX POINTE  
1151-3257  
7800-8744

213 FOX POINTE  
1152-3246  
7755-8504

118 SHANNON WOODS  
1152-3246  
7755-8504

LOT 24

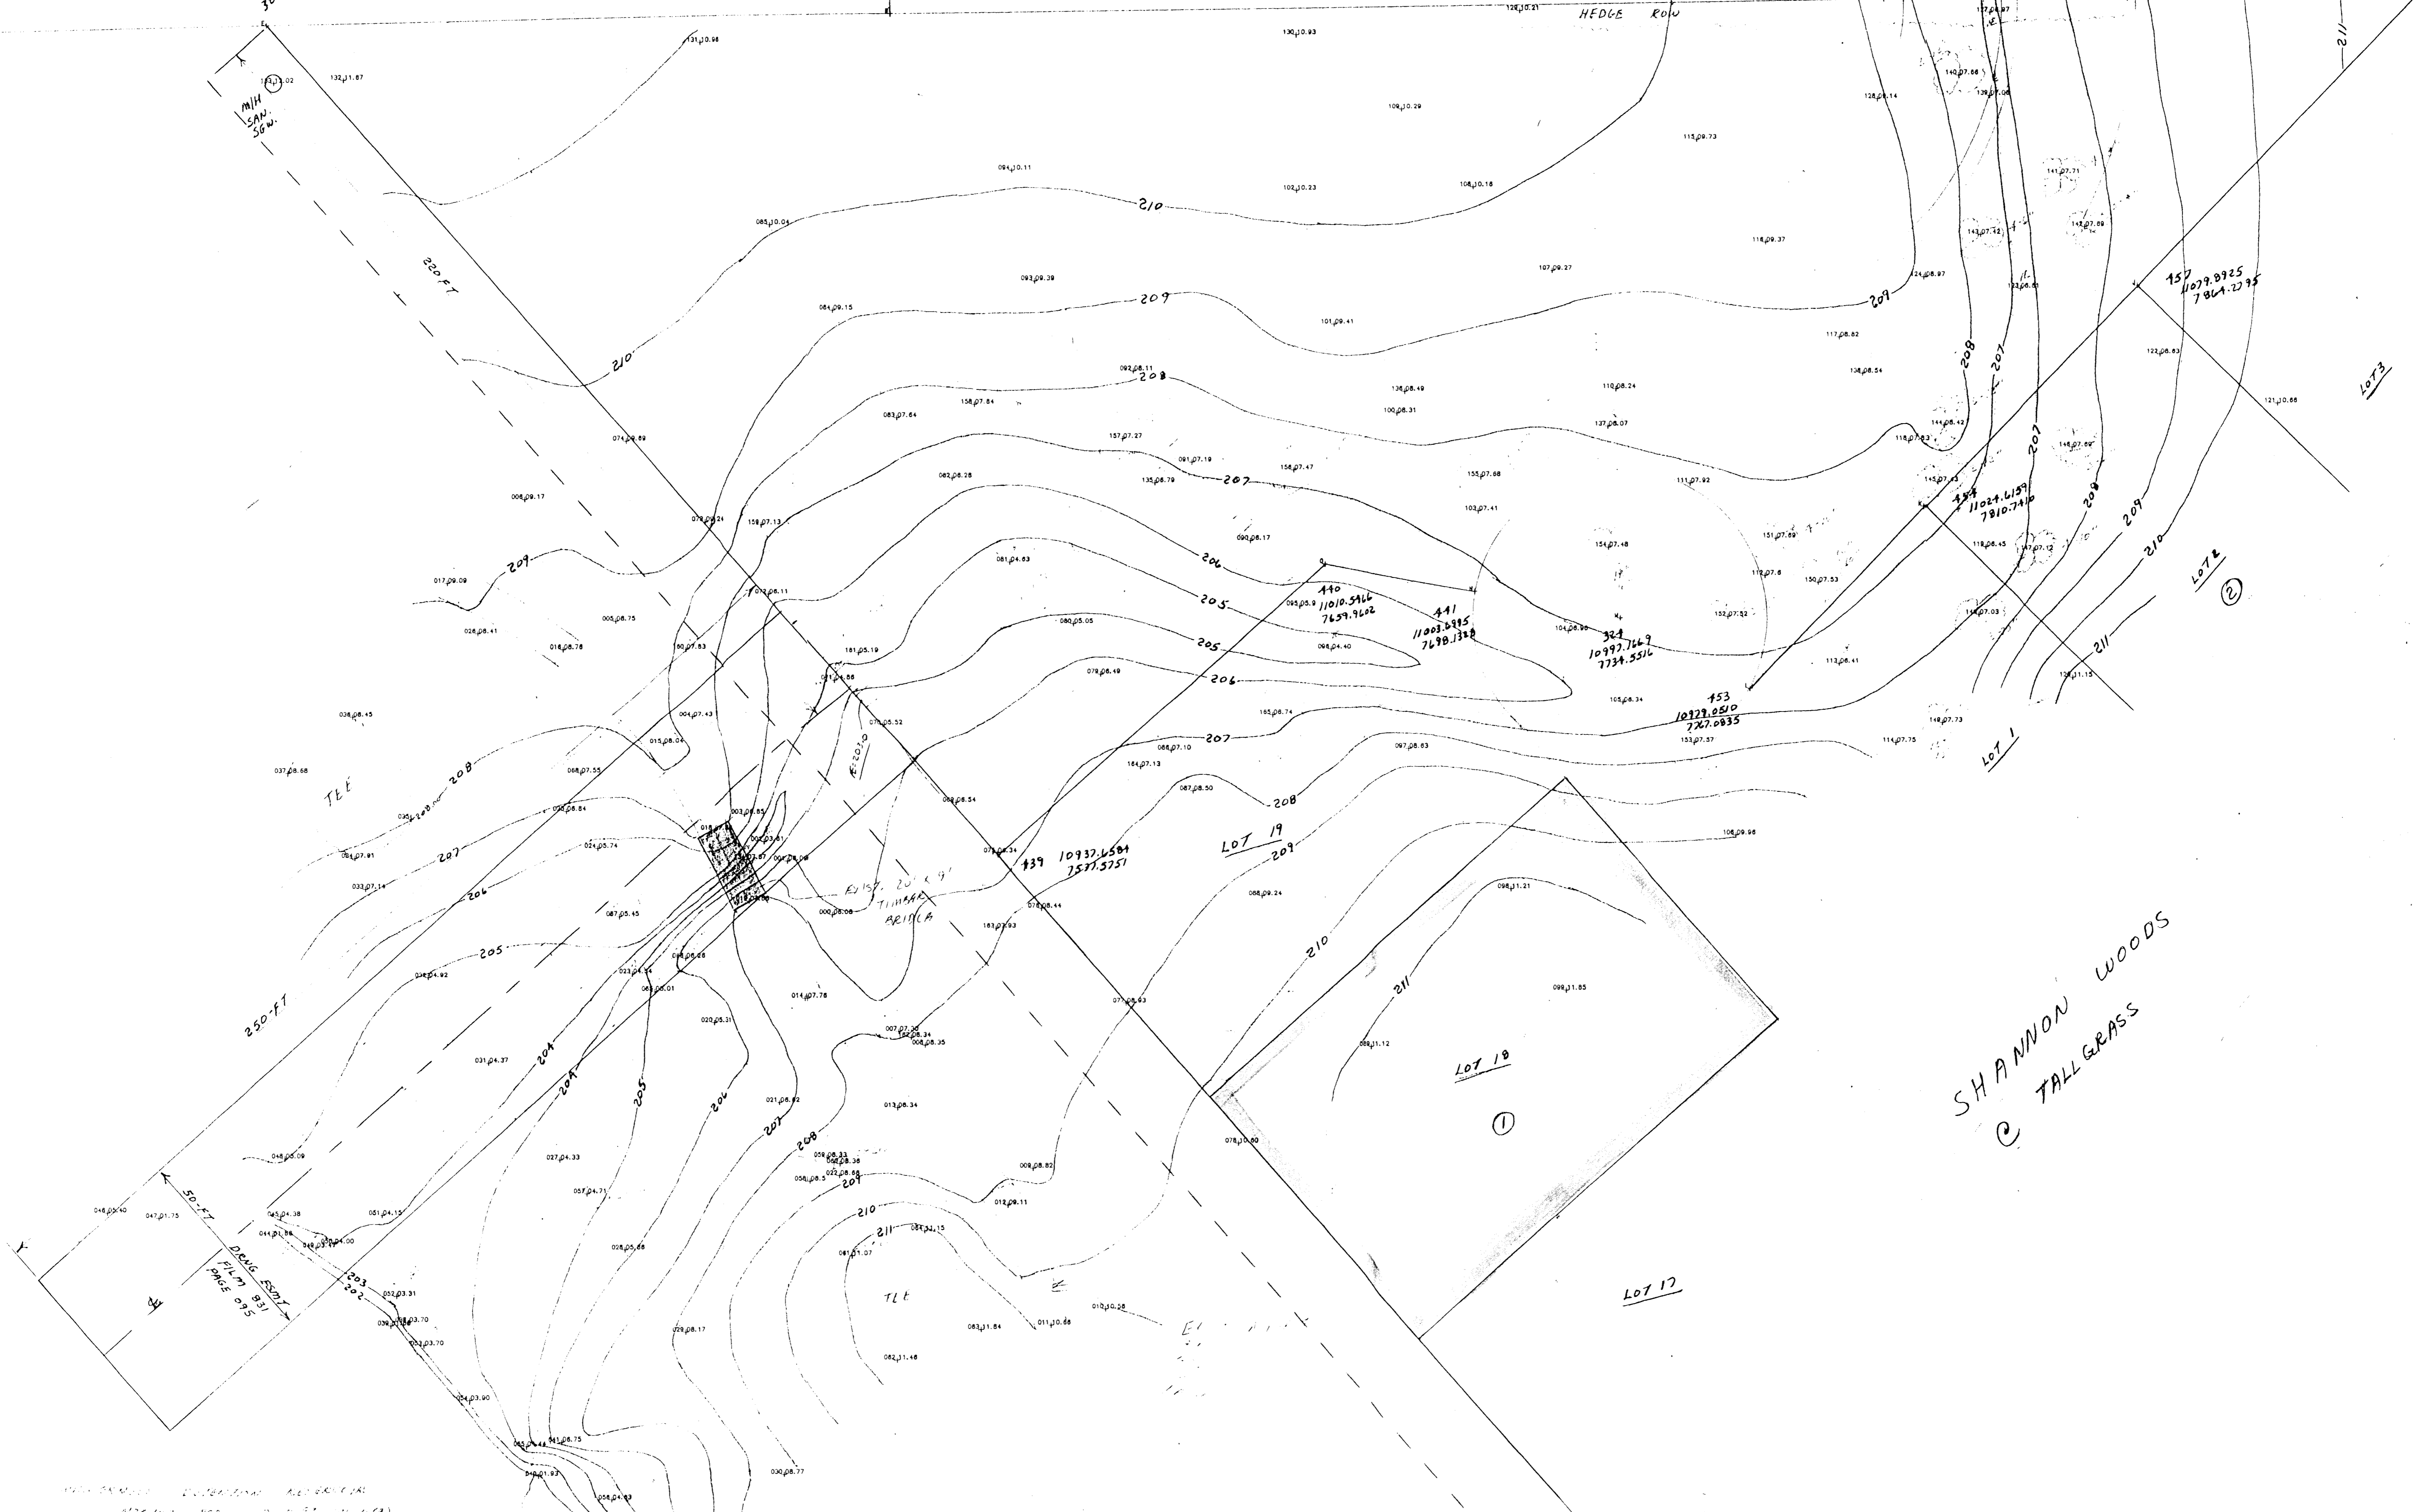

SHANNON WOODS  
© TALL GRASS

B:8920-D.SDR

SCALE = 20 FT/IN

11/14/2011  
11/14/2011  
11/14/2011  
11/14/2011