


SKETCH PLAT

HOUDEK ADDITION

WICHITA, SEDGWICK COUNTY, KANSAS

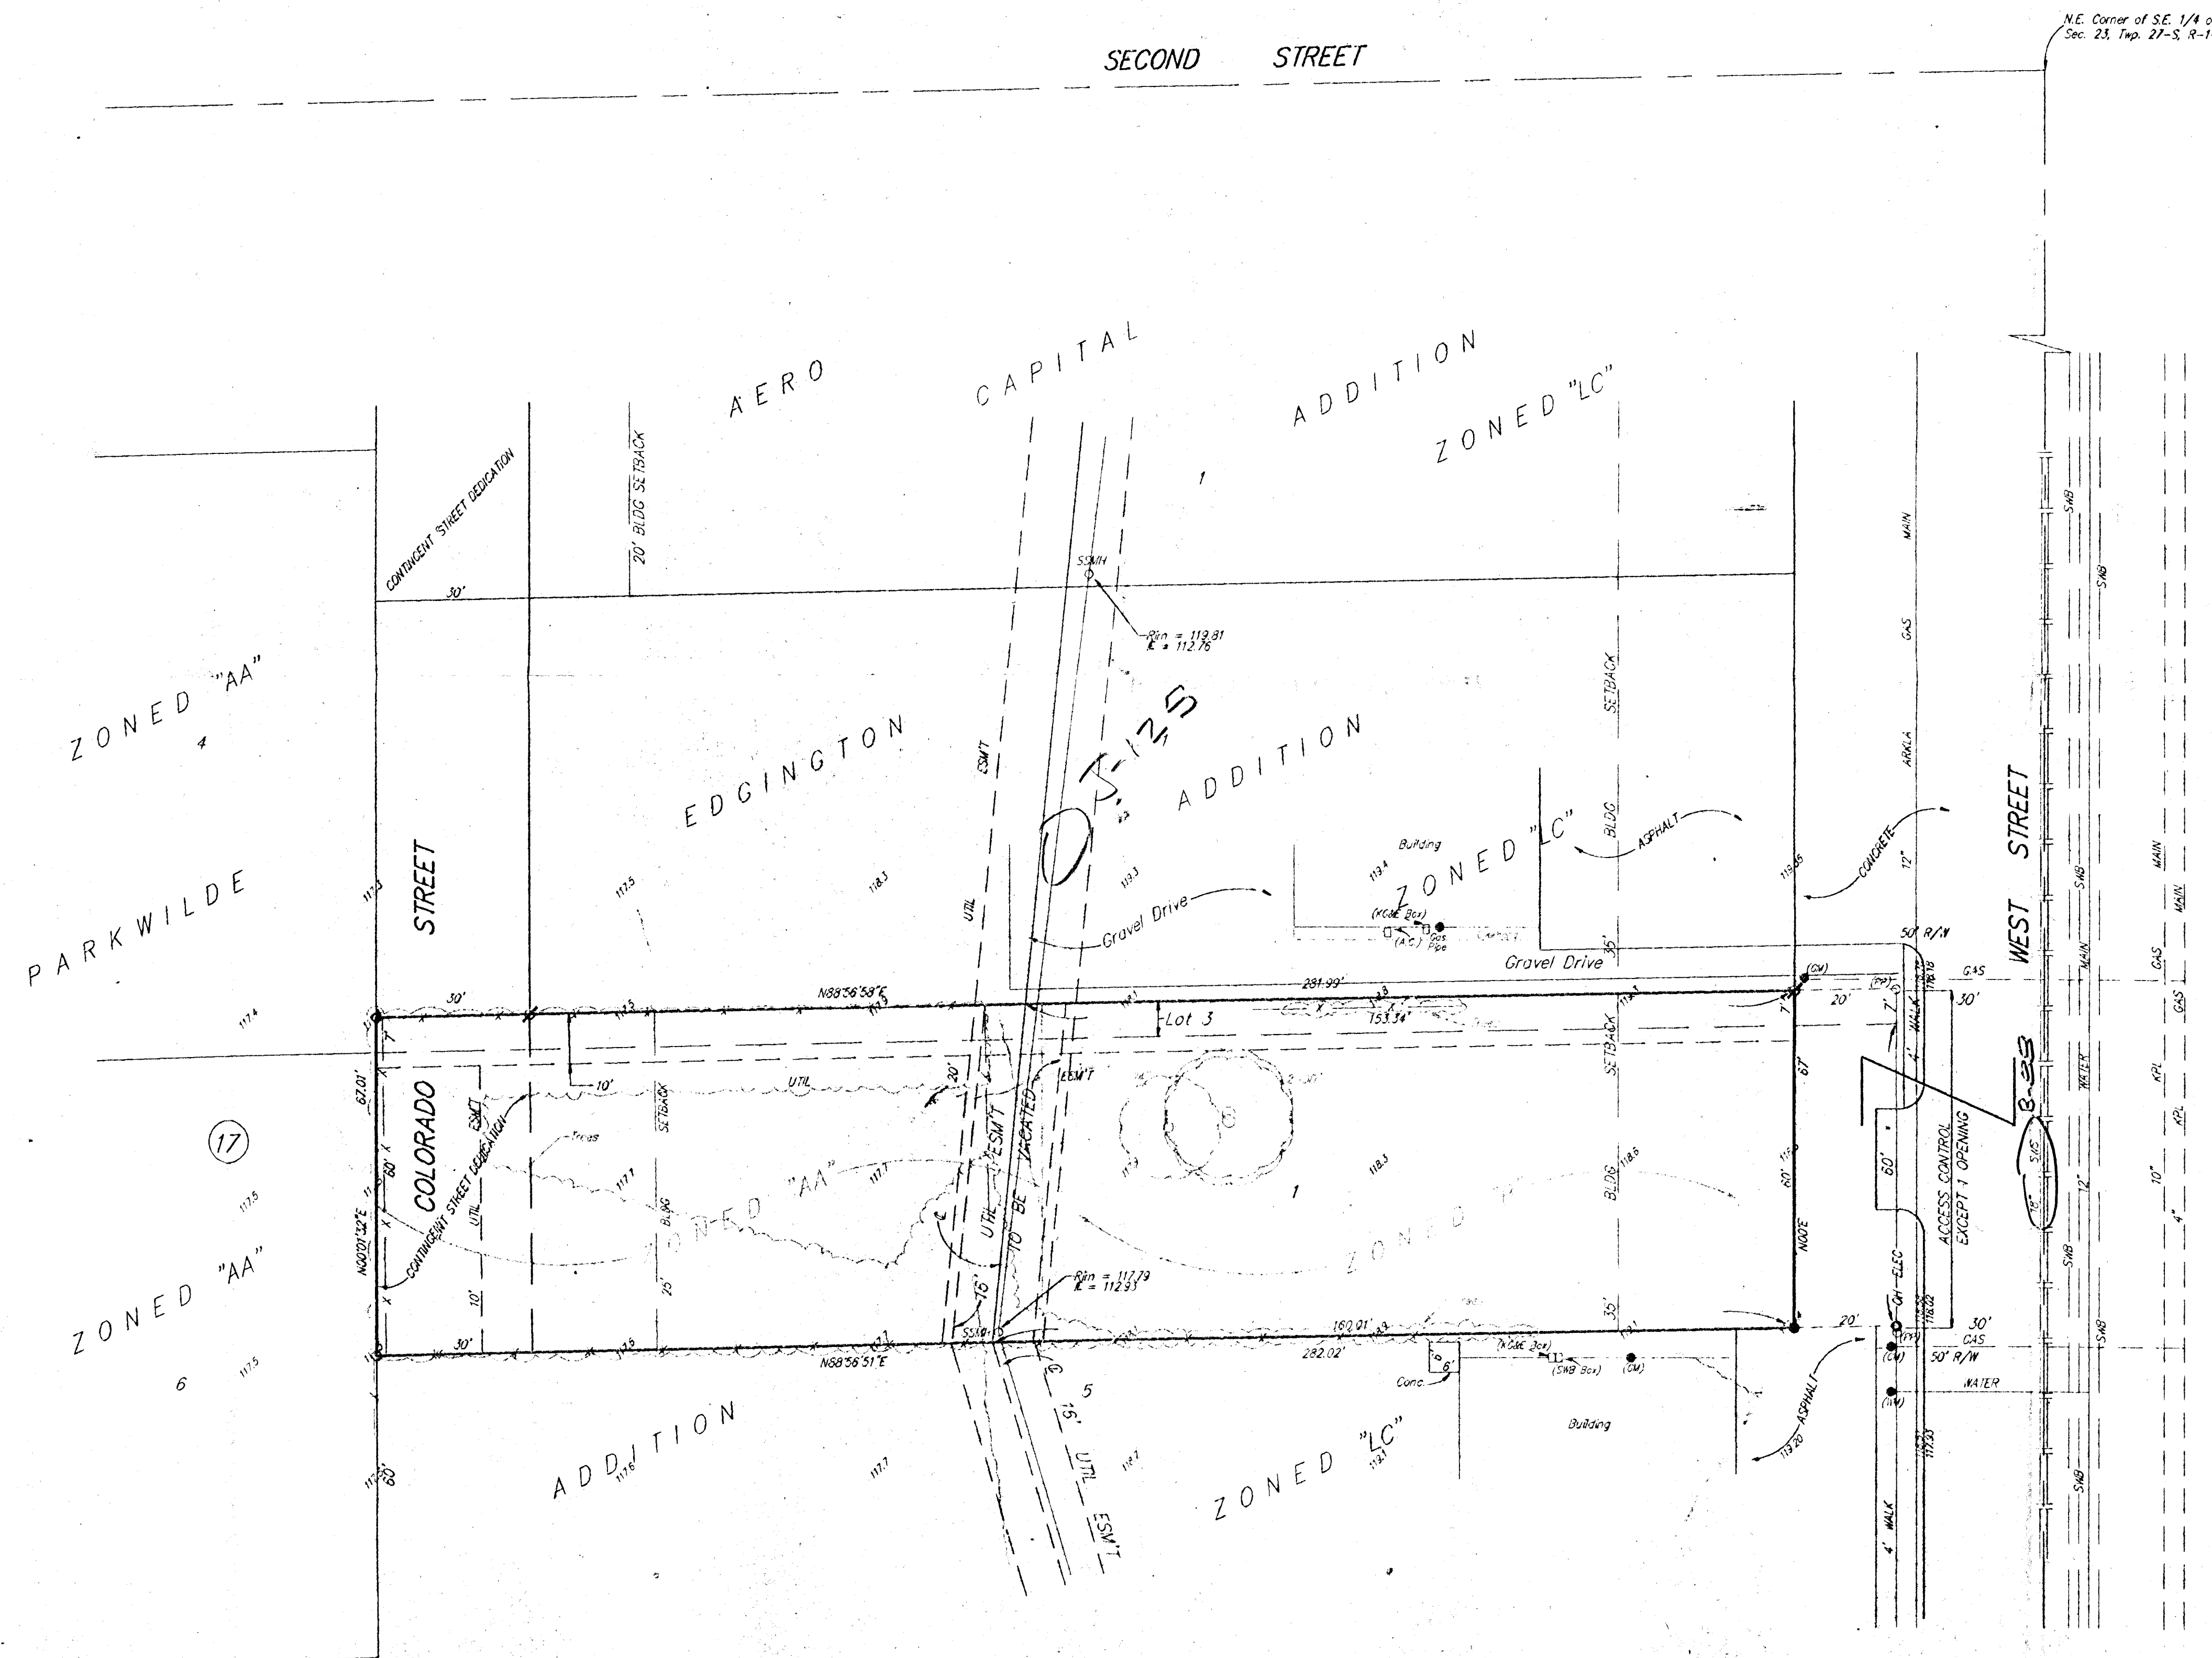


SCALE
1" = 20'

• = 1/2" REBAR "BAUGHMAN" CAP (SET)
○ = 1/2" REBAR (FOUND)
○ = 3/4" REBAR (FOUND)
○ = 1" REBAR (FOUND)

LEGAL
A replat of the South 7' of Lot 3 and the North 60' of Lot 5, Block 17, Parkville Addition, Wichita, Kansas, located in the SE 1/4 of Sec. 23, Twp. 27-S, R-1-W.

BENCHMARK
City Disk 34' West and 19' South of intersection of 2nd Street North and 2nd Street North. Elevation = 118.87

OWNER
Mama Houdek
1107 N. Wood
Wichita, KS 67212
(316) 942-2256

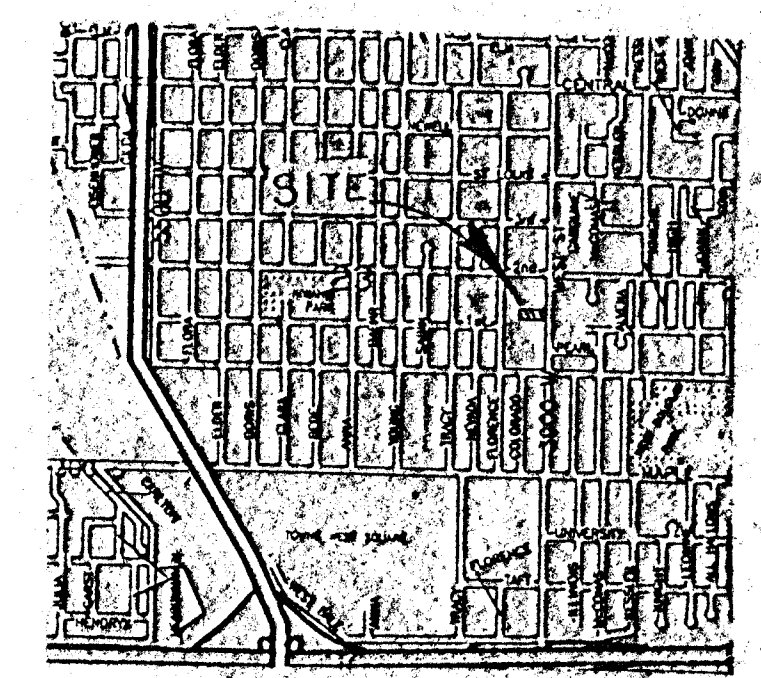

VICINITY MAP