


SOCORA VILLAGE

AN ADDITION TO WICHITA, SEDGWICK COUNTY, KANSAS

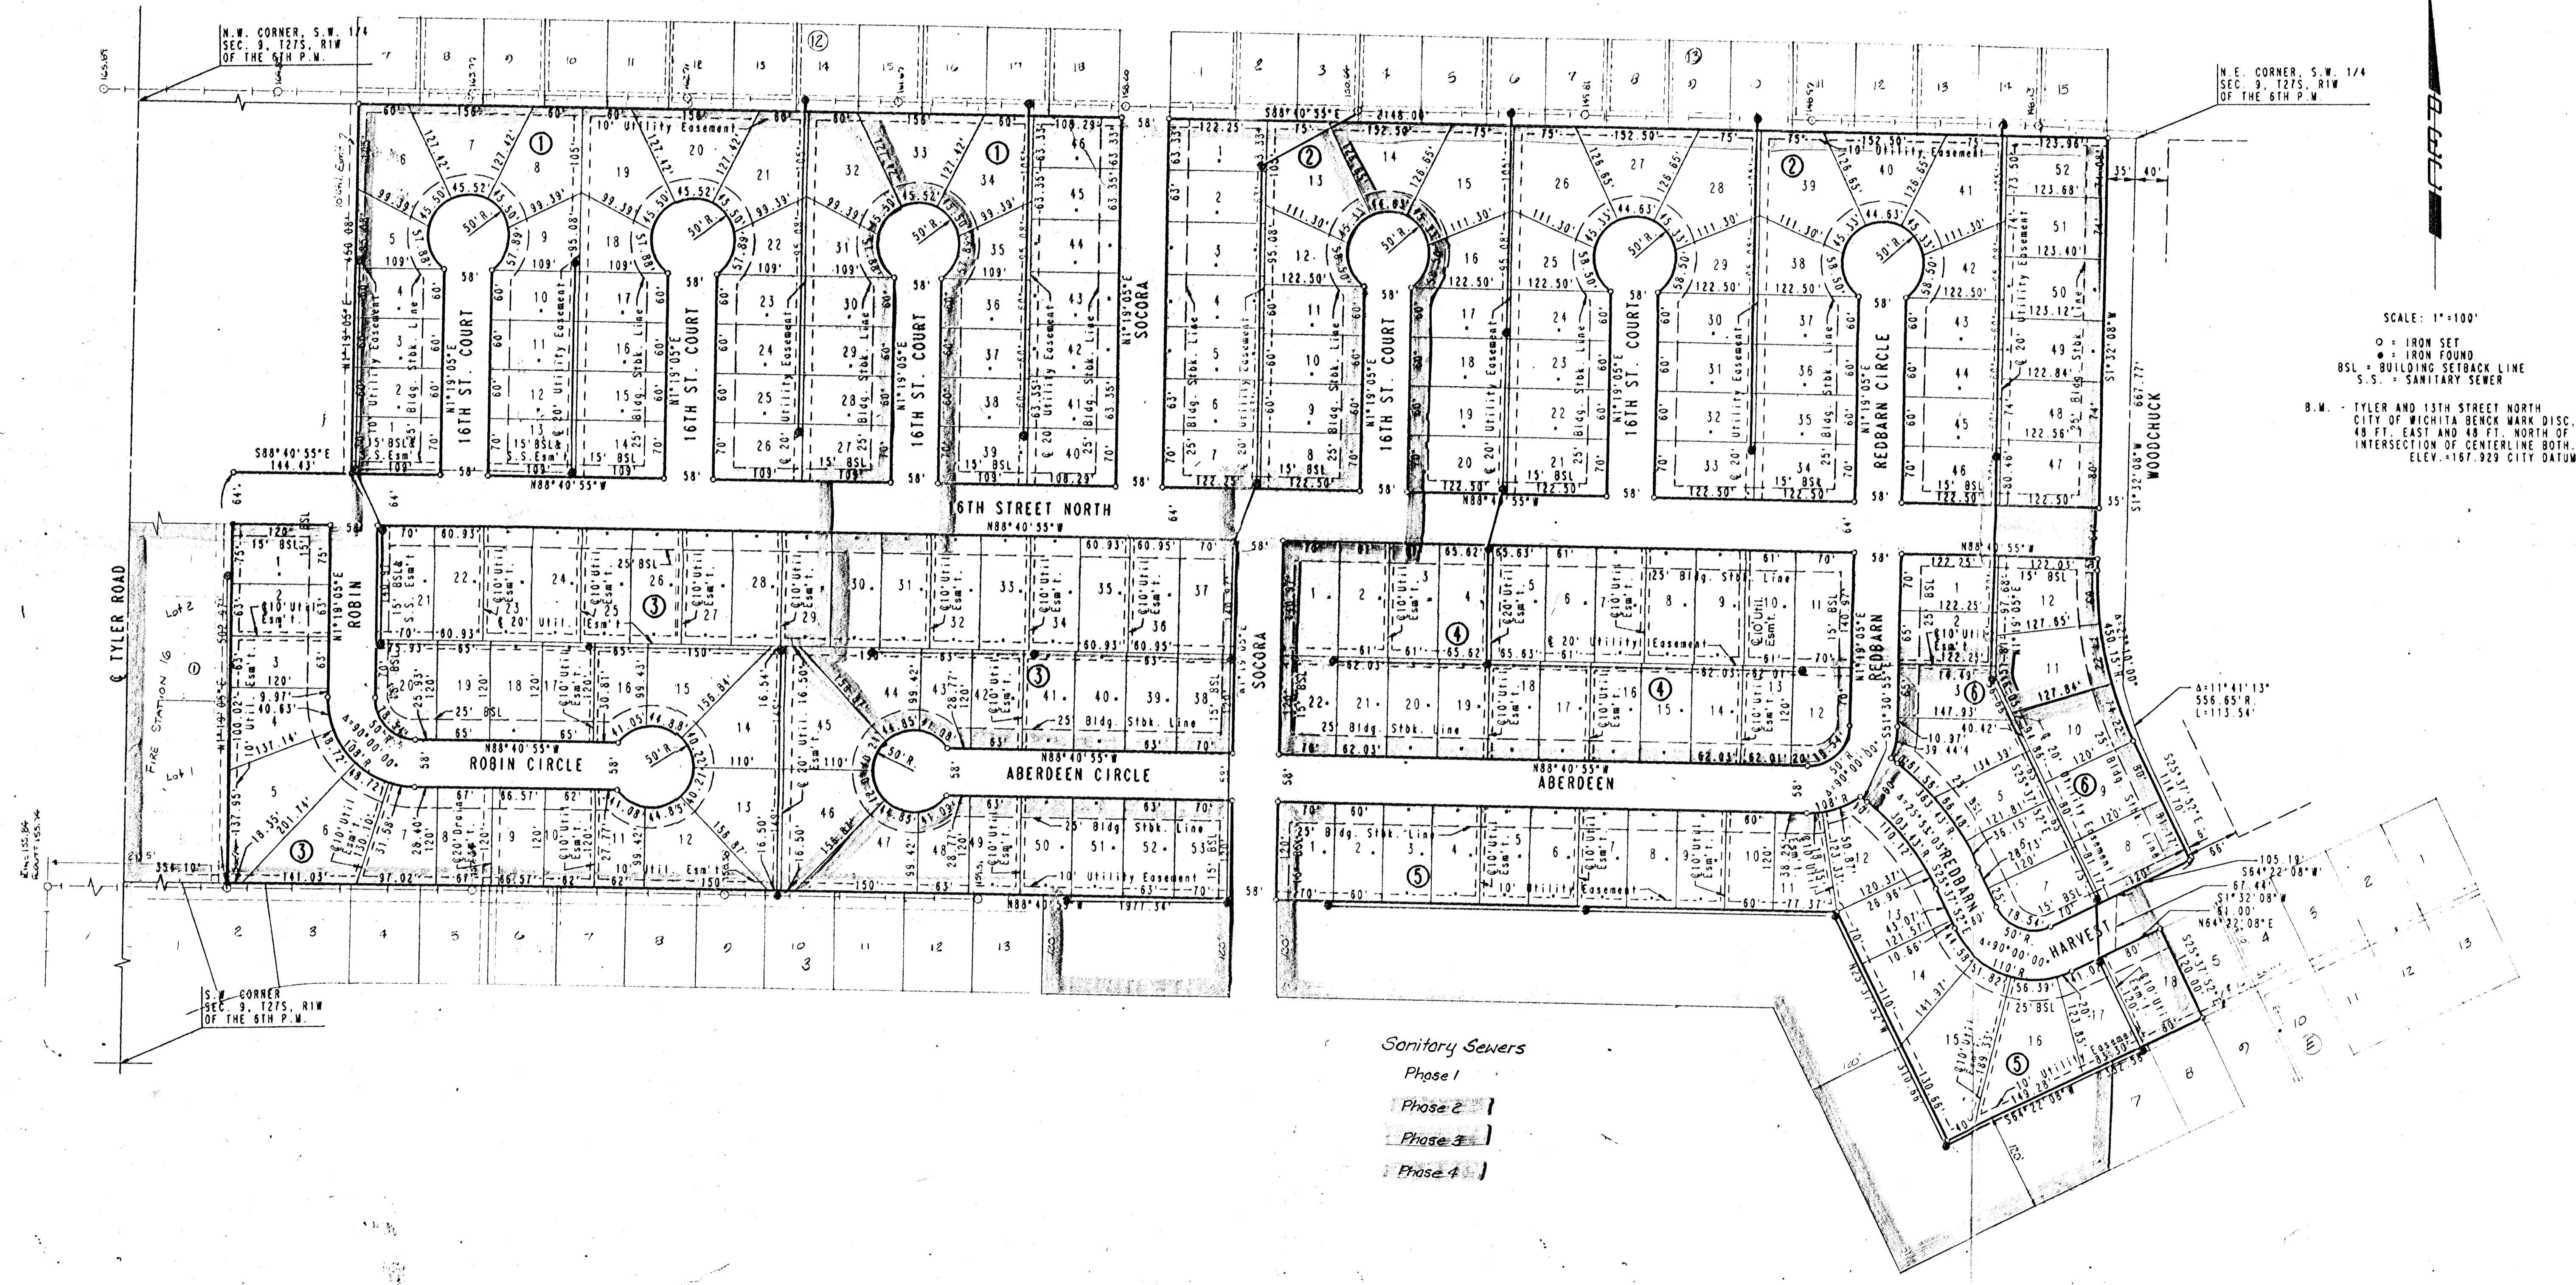

SCALE: 1"=100'

○ = IRON SET
 ● = IRON FOUND
 BSL = BUILDING SETBACK LINE
 S.S. = SANITARY SEWER

 CITY OF WICHITA BENCH MARK DISC.
 48 FT. EAST AND 48 FT. NORTH OF
 INTERSECTION OF CENTERLINE BOTH.
 ELEV. -167.929 CITY DATUM