



KOENIGS 2nd ADDITION

Sedgwick County, Ks.

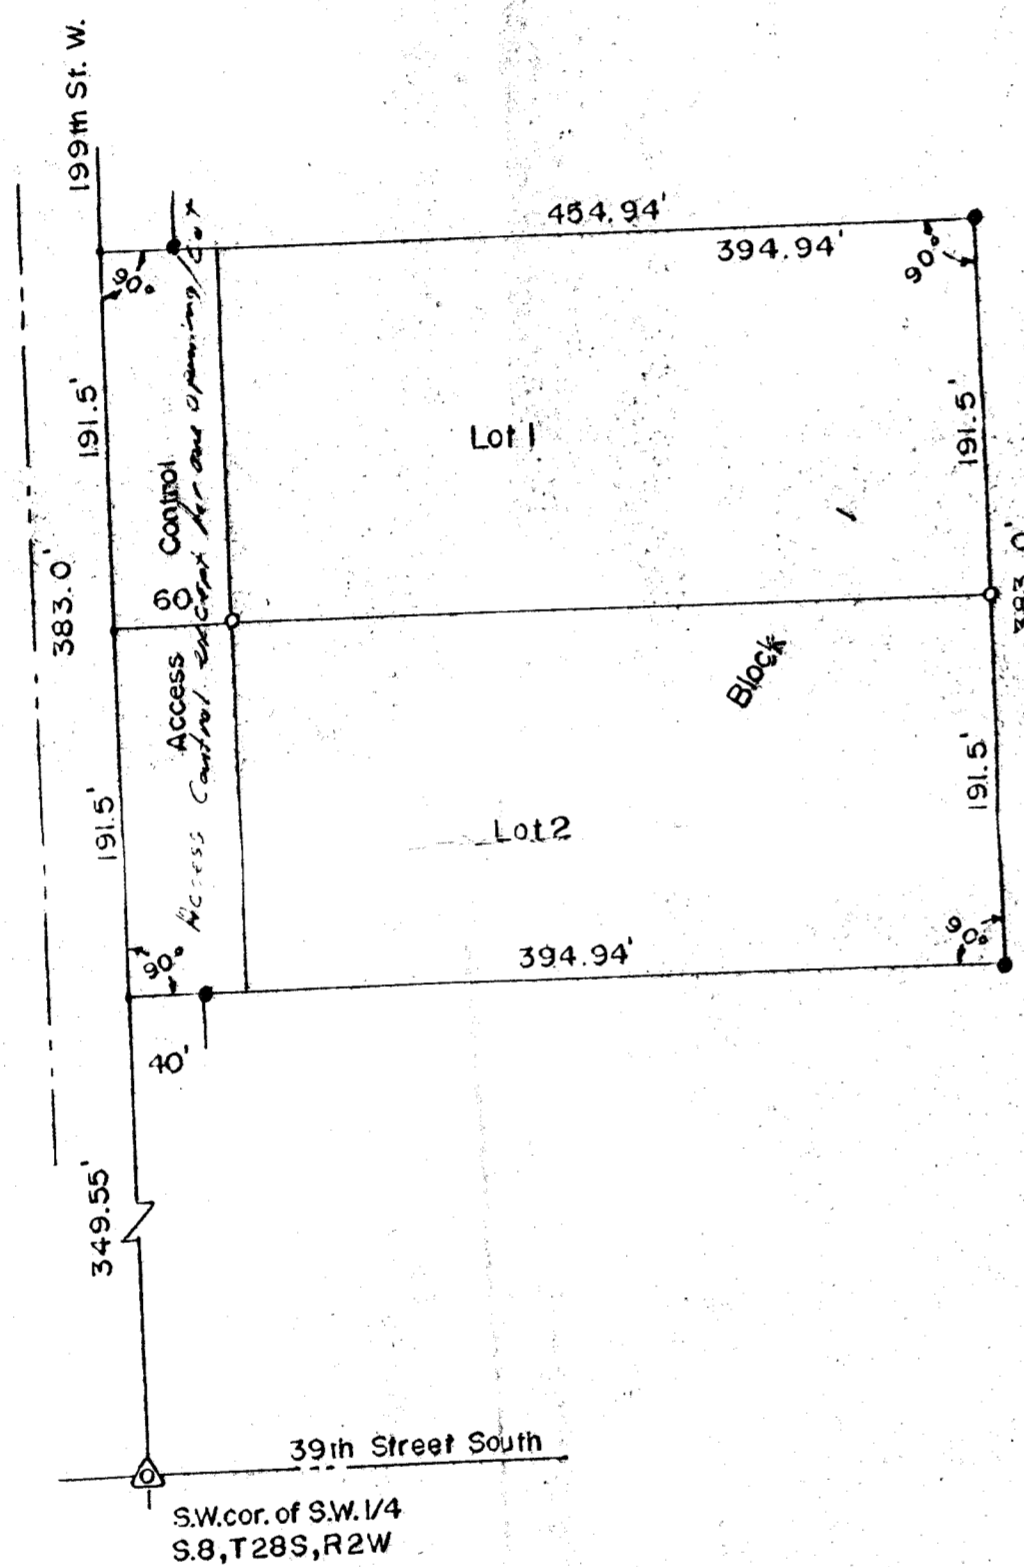

Scale: 1" = 100'
 ● = iron pipe (found)
 ○ = iron pin (set)
 * = Nail

STATE OF KANSAS ss
 SEDGWICK COUNTY ss
 We, Stuckey Surveying, Surveyors in aforesaid county and state do hereby certify that we have surveyed and platted "KOENIGS 2nd ADDITION" in Southwest Quarter of Section 6 Township 28 South, Range 2 West of the 6th PM, and that the accompanying plat is a true and correct exhibit of the property surveyed as described: Beginning 349.55 feet North of the Southwest corner of the Southwest Quarter of S.8, T.28S, R.2W, thence North 383.0 feet, thence East 484.94 feet, thence South 383.0 feet, thence West 454.94 feet to the place of beginning.
 November 29, 1982
 Date
 Lloyd R. Stuckey
 Lloyd R. Stuckey, L.S. # 728
 Stuckey Surveying
 Winfield, Kansas

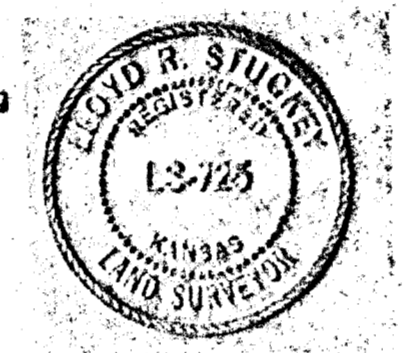

PLANNING COMMISSION:
 This plat of "KOENIGS 2nd ADDITION" has been submitted to and approved by the Wichita-Sedgwick County Metropolitan Area Planning Commission, Wichita, Kansas.
 Dated this ___ day of ___, 1982.
 Wichita-Sedgwick County Metropolitan Area Planning Commission

David Bayouth Chairman
 Robert A. Lakin Secretary

BOARD OF COUNTY COMMISSIONERS:
 This plat approved and all dedications shown hereon, if any, accepted by the Board of County Commissioners of Sedgwick County, Kansas, this ___ day of ___, 1982.

ATTEST:
 Dorothy K. White County Clerk
 Jack Spratt Commissioner
 Tom Scott Commissioner
 Donald E. Gragg Commissioner


Entered on transfer record this day of ___, 1982.

Dorothy K. White County Clerk

Know all men by these presents that we, the undersigned, have caused the land described in the surveyors certificate to be platted in to lots to be known as "KOENIGS 2nd ADDITION" in Sedgwick County, Kansas. Access Control to 199th Street West over and across the west line of Lots 1 and 2 is hereby granted to the appropriate governing body provided however that each lot shall have access to 199th Street West at one location to be determined by the appropriate engineer.

Gerald F. Koenigs
 Joyce Koenigs

STATE OF KANSAS ss
 SEDGWICK COUNTY ss
 Be it remembered that on this 29 day of November 1982, before me a Notary Public in aforesaid county and state came Gary Koenigs to me known to be the same person who executed the foregoing instrument of writing and duly acknowledged the execution of the same. In testimony whereof I have hereunto set my hand and affixed my notarial seal the day and year above written.

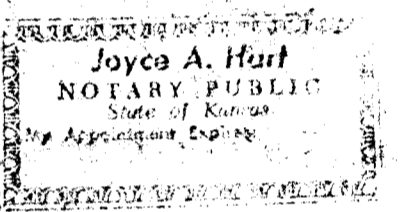

My comm. exp. October 27, 1986
 Joyce A. Hart
 Notary Public

STATE OF KANSAS ss
 SEDGWICK COUNTY ss
 This is to certify that this instrument was filed for record in the Register of Deeds Office, at ___ a.m. ___ p.m., on the ___ day of ___, 1982.

Bette F. McCart Register of Deeds
 Deputy