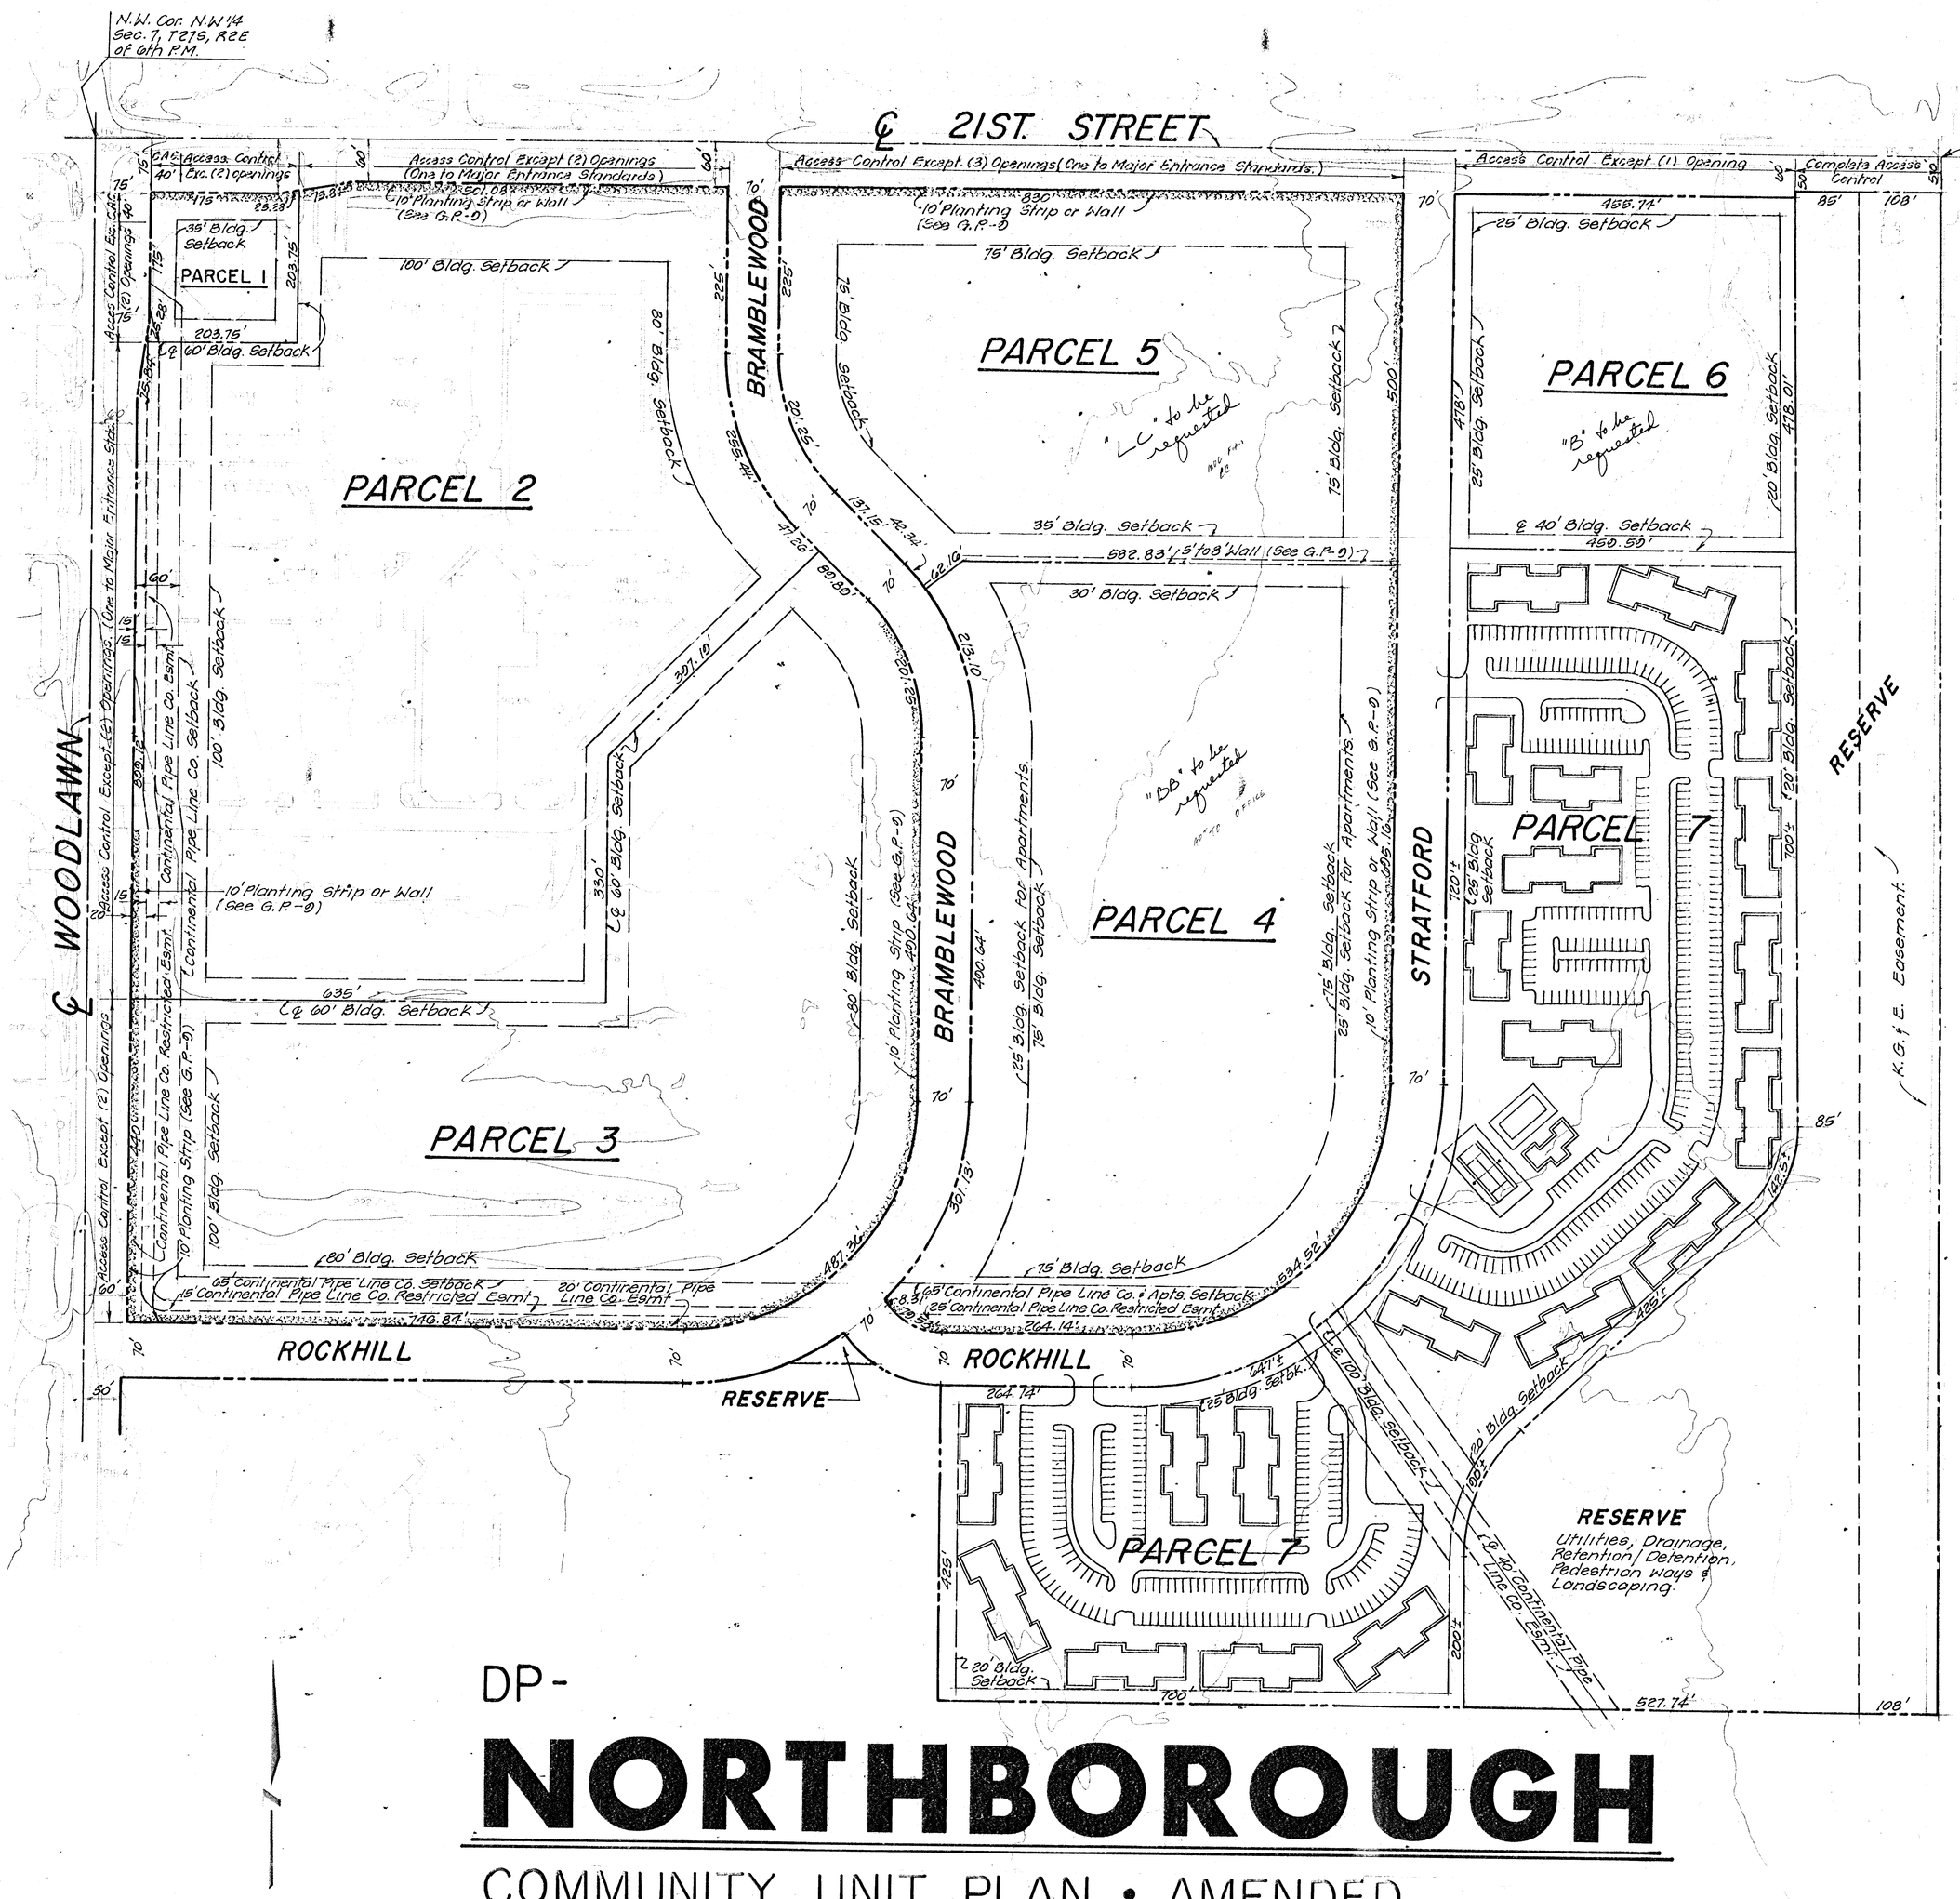

DP-

NORTHBOROUGH

COMMUNITY UNIT PLAN • AMENDED

N.W. 1/4 SECTION 7, 27S/2E.
SEDGWICK COUNTY, KANSAS

P.E.C.-ALLIED LABORATORIES

100' 0 100' 200' 300'