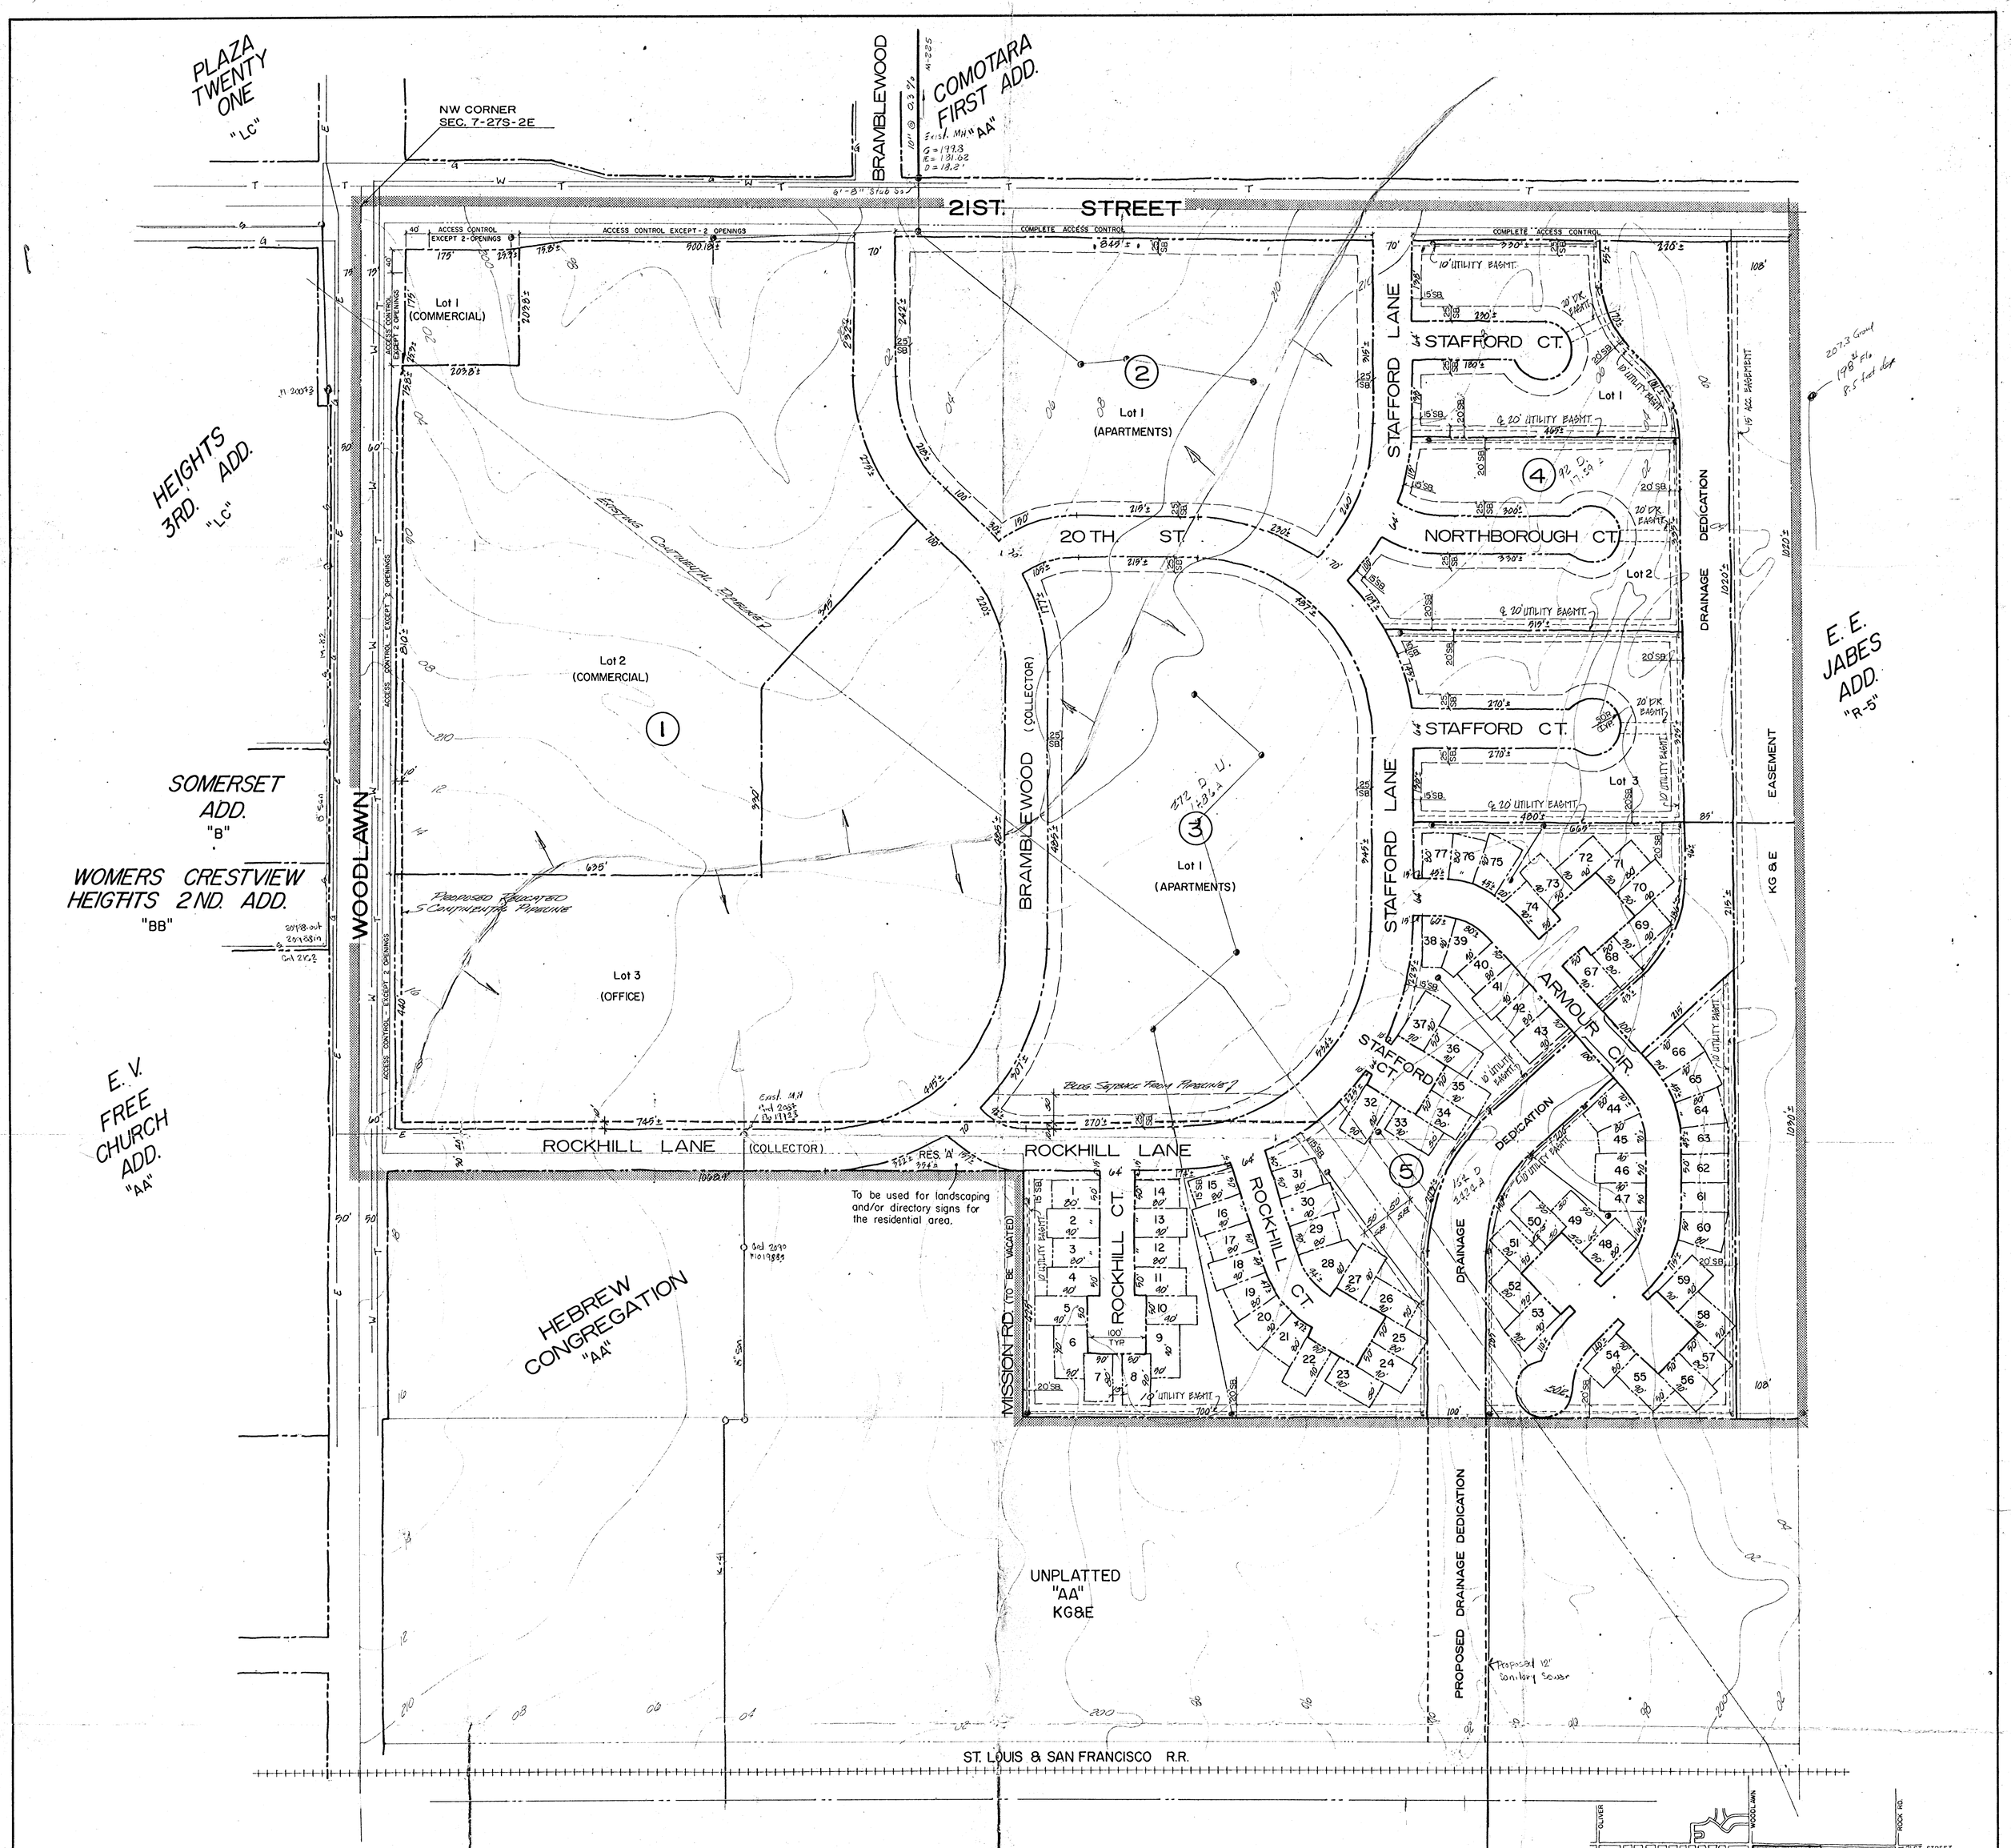

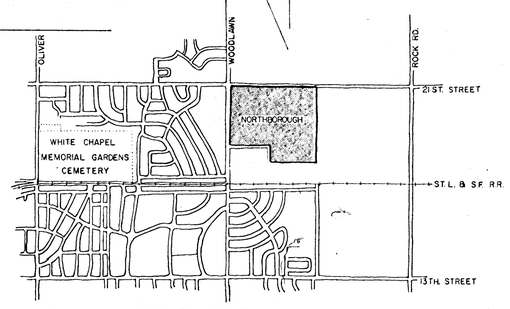

VICINITY MAP

NORTHBOROUGH

PRELIMINARY PLAT

OWNER/DEVELOPER • THEODORE GORE, ROBERT M. BEREN, THEODORE I. LEBEN
WICHITA, KANSAS

NORTH

SCALE IN FEET
0 50 100 200 300

CONTOURS 2-FOOT INTERVALS
CITY DATUM ELEVATIONS

Sheet	Sheet Title	Project		
1 Of 1	PRELIMINARY PLAT	M-32 K-41 NORTHBOROUGH	Drawn G. WILEY Checked Revised	oblinger-smith corporation