



FOR DESIGN REVIEW  
 DATE  
 AUG 30 1989  
 PRINTED

KELLOGG (U.S. 54)

ORME STREET

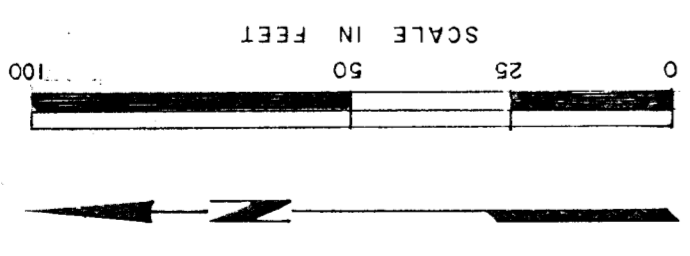

- LEGEND**
- REMOVE EXISTING PAVEMENT
  - 2" A.C. OVERLAY
  - REPLACE PAVT WITH R.C.C. PAVT.
  - NEW A.C. PAVT
  - H.P. HANDICAP PARKING - 12'x18'
  - S.P. STANDARD PARKING - 9'x18'
  - C.P. COMPACT PARKING - 6'x18'

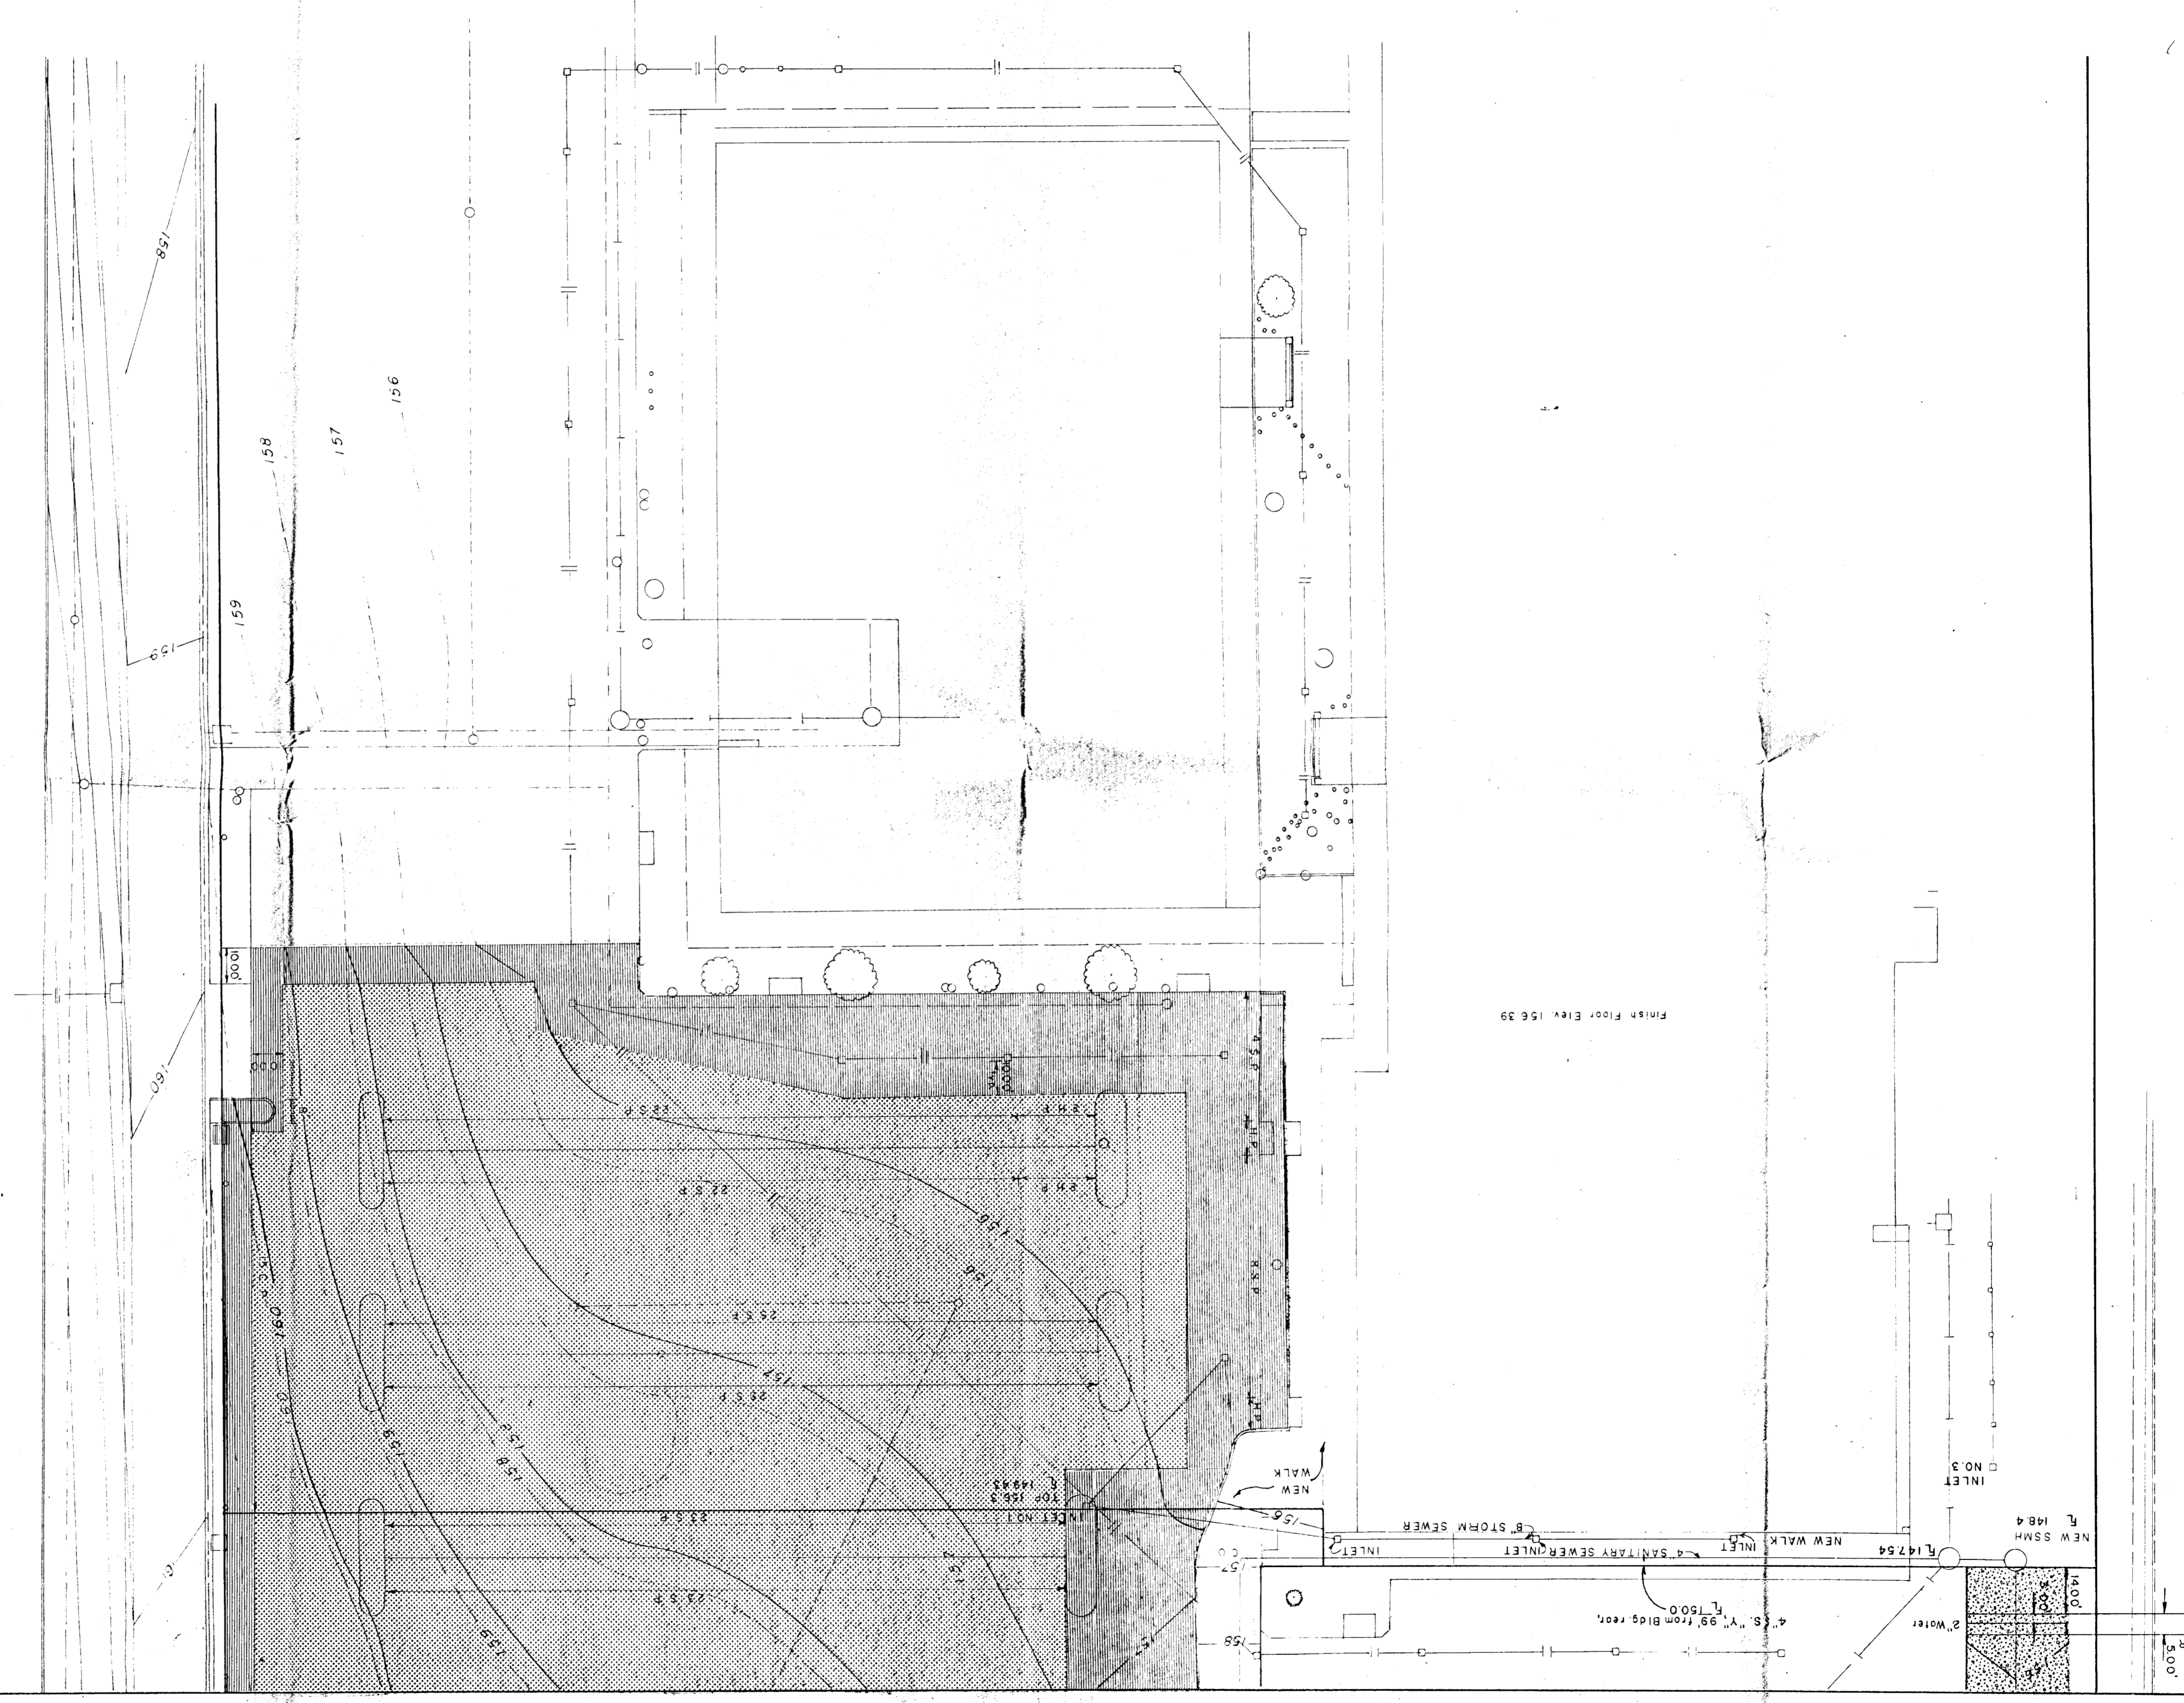

Finish floor Elev 156.39

"WATER" 100'

GAS

"Water"

NEW SSMH

INLET

INLET NO. 3

NEW WALK

NEW WALK

