N

1" = 100'
Elevations = City Datum
Bench Mark: City Standard
Disc. 30' south & 45' East of
@ Seneca & 53 th St. So
Elevation = 80.123 City
Datum.

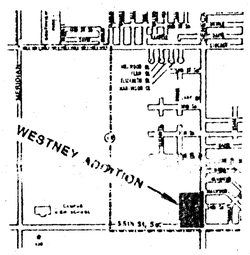

VICINITY PLAT

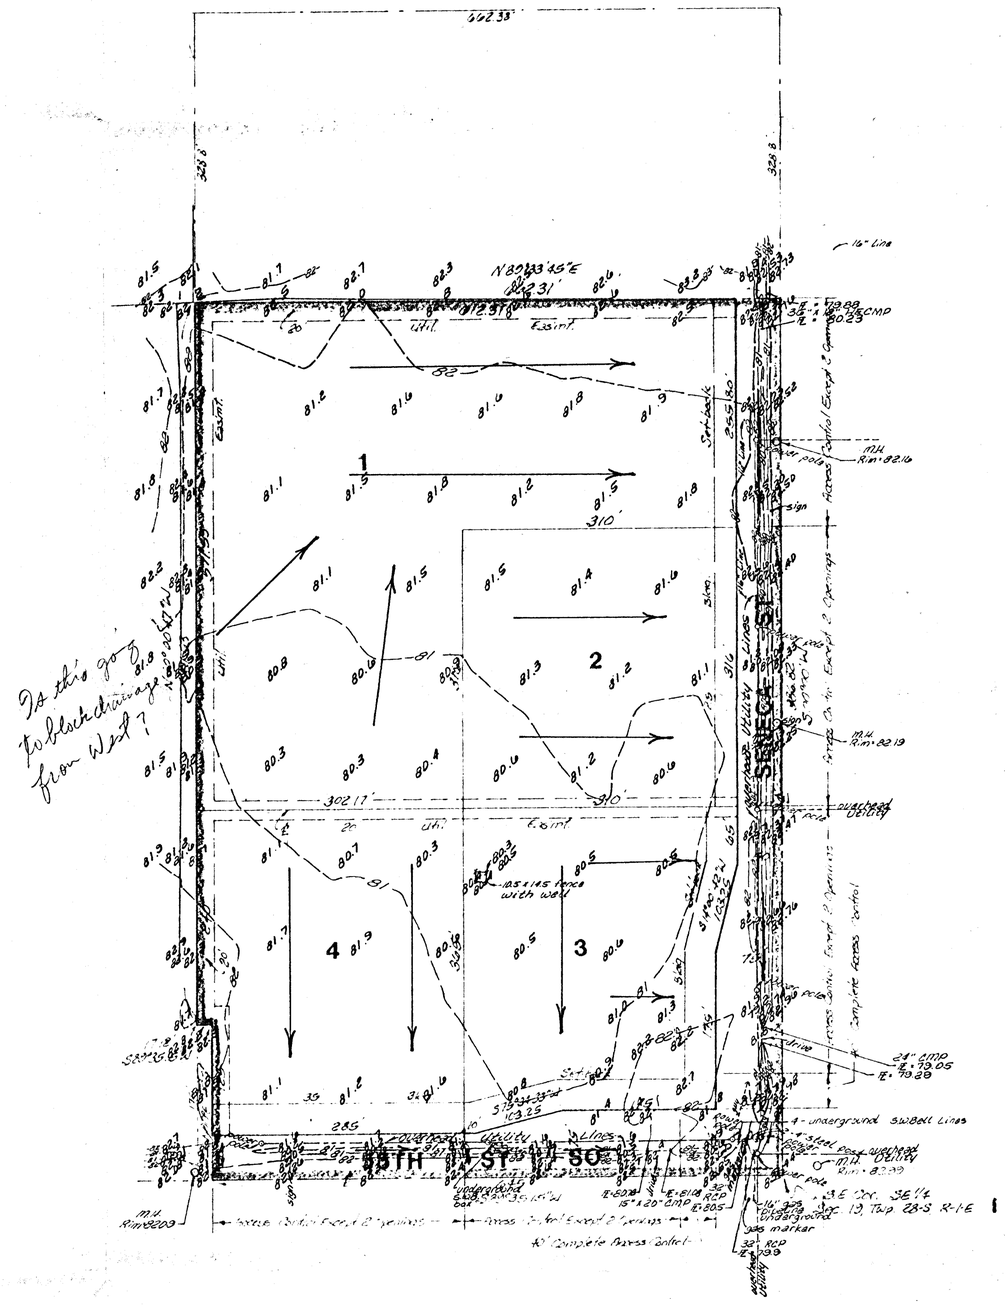

PRELIMINARY PLAT

WESTNEY ADDITION

WICHITA, KANSAS

PART OF THE E1/2 OF THE SE1/4 OF THE SE1/4 OF SEC 19,

TWP 28-S R-1-E OF THE 6TH PM, SEDGWICK COUNTY, KANSAS

WALT WESTNEY

DRAINAGE CONCEPT

BAUGHMAN COMPANY, P.A.
SURVEYING & ENGINEERING
316/262-7271 • 315 ELLIS • WICHITA, KANSAS 67211

7 SEP 88