

**CONST TYPE 1-A CURB  
INLET OVER EXISTING  
24" PIPE. Top curb 15737  
Existing 24" 1499! W:4'2"**

Sta. 3+31 Existing  
Type 1-A Inlet w=5'0"

DRAINAGE &  
14th STREET

UTILITY EASEMENT

existing 15" Pipe  
PLUG INLET OPENING  
20'

existing type 1-A  
inlet. Top 157.20


**CONST TYPE 1-A CURB INLET  
OVER EXISTING 15" PIPE W:4'2"  
Top curb 15756 Exist'g 15" 15320!**

NOTE: All inlets this sheet are Type 1A Curb  
Inlets w=4'2" unless otherwise noted.

revised sept 1979

15" Inlet, w=5'0"  
57.20

Prepared by  
RUTGERS  
P.A. Co.  
2000 20-00

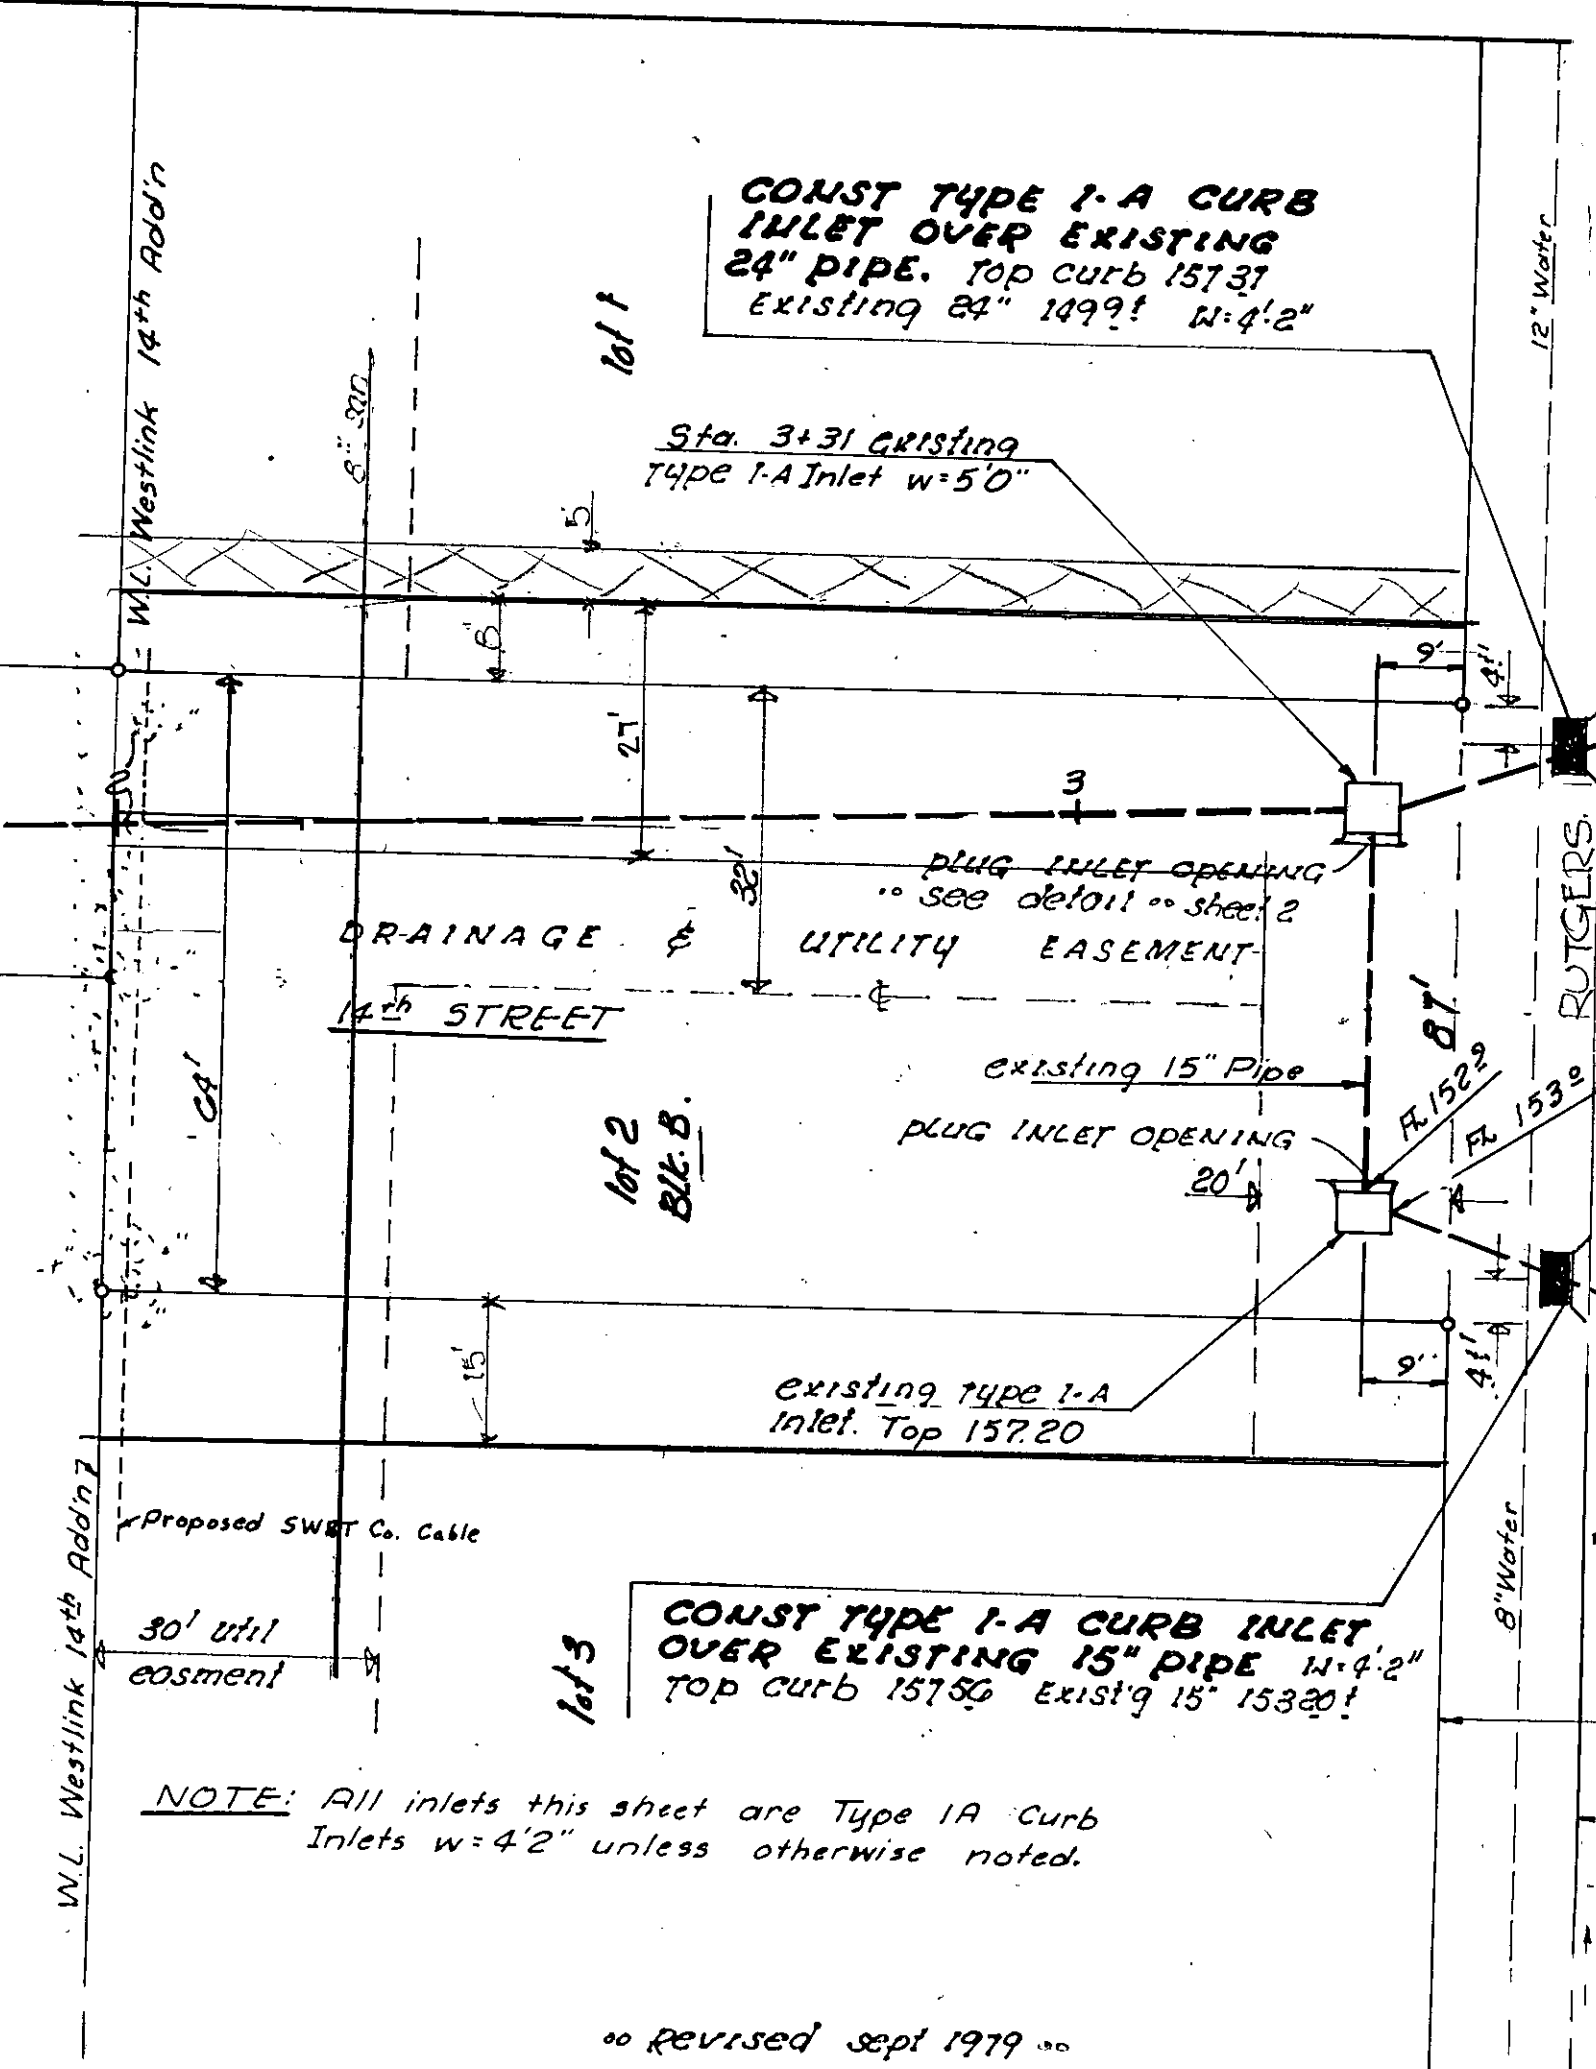



SUBDIVISION REPORT

SUBDIVISION COMMITTEE  
METROPOLITAN AREA  
PLANNING COMMISSION

S/D NO. 79-130 Name Westlink Village 20th Addition  
Date Application Rec'd. 11-5-79 Preliminary Approval \_\_\_\_\_  
Scheduled S/D Meeting 11-15-79

DESCRIPTION

General Location North of 13th Street North, 1/2 mile west of Maize Rd.

Owner Thurman Smith  
Surveyor/Engineer Professional Engineering Consultants, P.A. (Gary Wiley)  
Address 1440 E. English, 67211 Phone 262-2691

- 1. Gross Acreage of Plat 1.56 acres±
- 2. Number of Lots:
  - Residential 6
  - Commercial \_\_\_\_\_
  - Industrial \_\_\_\_\_
  - Other \_\_\_\_\_
  - Total Number of Lots 6
- 3. Minimum Lot Frontage 80 ft.
- 4. Minimum Lot Area 11,200 square ft.
- 5. Existing Zoning "AA"
- 6. Proposed Zoning "AA"
- 7. Lineal Feet of New Streets:
  - a.          R/W          ft.
  - b.          R/W          ft.
  - c.          R/W          ft.
  - d.          R/W          ft.
  - e.          R/W          ft.
  - TOTAL -0- ft.
- 8. Sidewalk adjacent to all streets?          yes          no
- 9. Public Water Supply Yes (Yes-No), Name City of Wichita
- 10. Public Sanitary Sewers Yes (Yes-No), Name City of Wichita
- 11. Health Department Approval (where applicable) \_\_\_\_\_ (Yes-No)
- 12. City of Wichita X: Three-Mile Area \_\_\_\_\_


STAFF COMMENTS:

Note: The plat has been submitted in response to a requirement of preliminary plat approval for the proposed Echo Hills Addition to the west in which it was requested that 14th and 16th Streets in Westlink Village 14th Addition be vacated because, due to drainage, they cannot now be extended further west.

- A. The representative from City Public Works should be prepared to comment on whether the existing 10-foot sanitary sewer easement and the existing 10-foot storm sewer easement on Lot 2, Block A, can be shifted north and south respectively, so as to produce a larger building site for this lot.
- B. The representatives from City Public Works and the Water Department should be prepared to comment on the need to revise street paving, sanitary sewer, and water plans and assessments caused by this relotting.
- C. Recording of the plat within 30 days after approval by the Board of City Commissioners.

Note: This plat is submitted in final form only, as provided for in Article 4, Part 5 of the MAPC Subdivision Regulations. The Utility Advisory Committee should be prepared to comment on existing utilities and other various improvements, or discuss the feasibility of the applicant extending and/or installing same.

WICHITA—SEDGWICK COUNTY

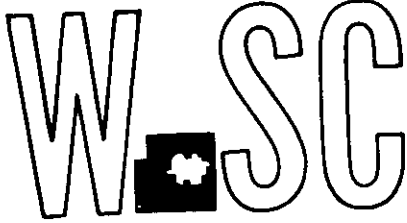

METROPOLITAN AREA PLANNING  
DEPARTMENT

CITY HALL — TENTH FLOOR  
455 NORTH MAIN STREET  
WICHITA, KANSAS 67202

November 16, 1979

Professional Engineering Consultants, P.A.  
1440 E. English  
Wichita, Ks. 67211

Re: S/D 79-130 - Final plat of Westlink Village 20th Addition

Gentlemen:

At the regular meeting of the Subdivision Committee of the Metropolitan Area Planning Commission, November 15, 1979, the above captioned plat was considered. The action of the Committee was to recommend that this plat be approved subject to:

- A. The south 26.5' of Lot 2, Block A shall be labeled as a storm sewer and drainage easement.
- B. The north 15' of Lot 2, Block A shall be labeled as a utility easement.
- C. The south 5' of Lot 1, Block B shall be relabeled as a utility easement.
- D. The applicant shall guarantee the storm sewer revisions necessitated by this replat.
- E. Recording of the plat within 30 days after approval by the Board of City Commissioners.

Enclosed with the applicant's copy of this letter is a list the five methods which have been adopted as being acceptable for guaranteeing improvements required in the approval of plats. Forms for the bond and irrevocable letter of credit are available from this office.

The enclosed "marked" copy of the final plat is for your attention and files.


Professional Engineering Consultants, P.A.

11-16-79

Page 2

This matter will be forwarded to the Planning Commission for its consideration on Monday, November 19, 1979, at 1:30 p.m. If you have any questions regarding this matter, please call.

Sincerely,

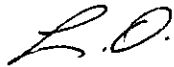

Louise Olivarez  
Senior Planner

LO:bh

cc: Thurman Smith, 11216 W. Maple, 67209  
— Dean Sellers, Assistant City Engineer

January 15, 1981

C.S.I.  
1325 S. Anna  
Wichita, Kansas 67209

Re: Westlink 20th Addition

To Whom It May Concern:

Streets, sanitary sewers, and drainage improvements in Westlink 20th Addition have been designed and constructed to City standards and will be maintained by the City of Wichita.

Sincerely,

Mike Lindebak  
Program Development Engineer

ML:ck

---

# THE CITY OF WICHITA



DEPARTMENT OF ENGINEERING  
CITY HALL — SEVENTH FLOOR  
455 NORTH MAIN STREET  
WICHITA, KANSAS 67202  
(316) 268-4501

February 23, 1982

Mr. Donald M. Wood, General Manager  
Construction Sciences, Inc.  
1325 South Anna  
Wichita, KS 67209

Re: Storm Sewer Easement  
Lot 2, Block B, Westlink  
Village 20th Addition  
1453 North Rutgers

Dear Mr. Wood:

Your inquiry regarding the above referenced property has been reviewed; we have concluded that we have no opposition to vacation of that portion of the storm sewer and drainage easement which has been constructed upon, provided that additional easement north of the existing easement is dedicated and further provided that the storm sewer be relocated within the dedicated easement.

If you have any questions, please feel free to contact me at 268-4530.


Sincerely,

Mike Lindebak  
Program Development Engineer

ML:TC:md

7


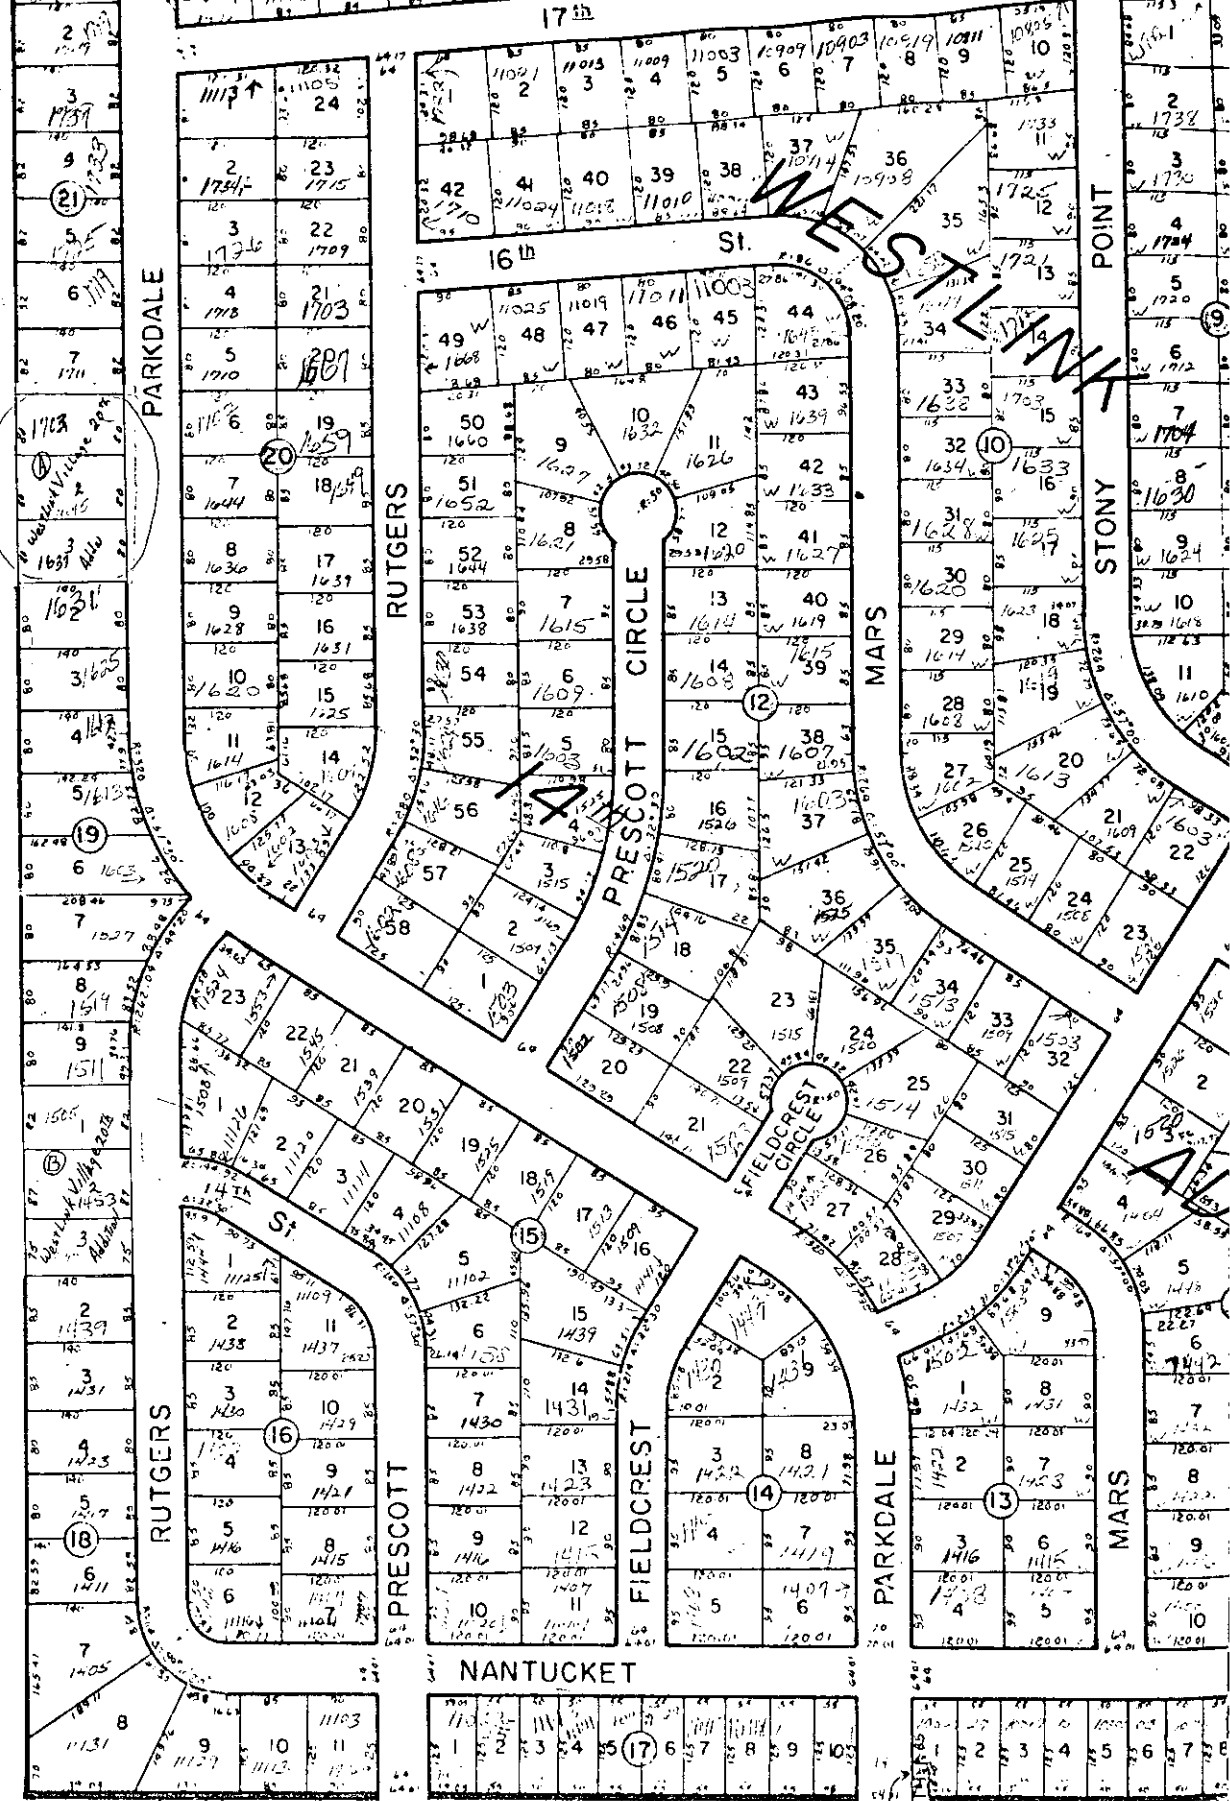

13th  
 1093 1092 1091 