ORIGINAL SURVEY		BY	DATE
NOTE BOOK	SURVEYED		
	PLOTTED		
	TEMPLATE		
	AREAS		
NO.	AREAS CHECKED		

FINAL SURVEY		BY	DATE
NOTE BOOK	SURVEYED		
	PLOTTED		
	TEMPLATE		
	AREAS		
NO.	AREAS CHECKED		

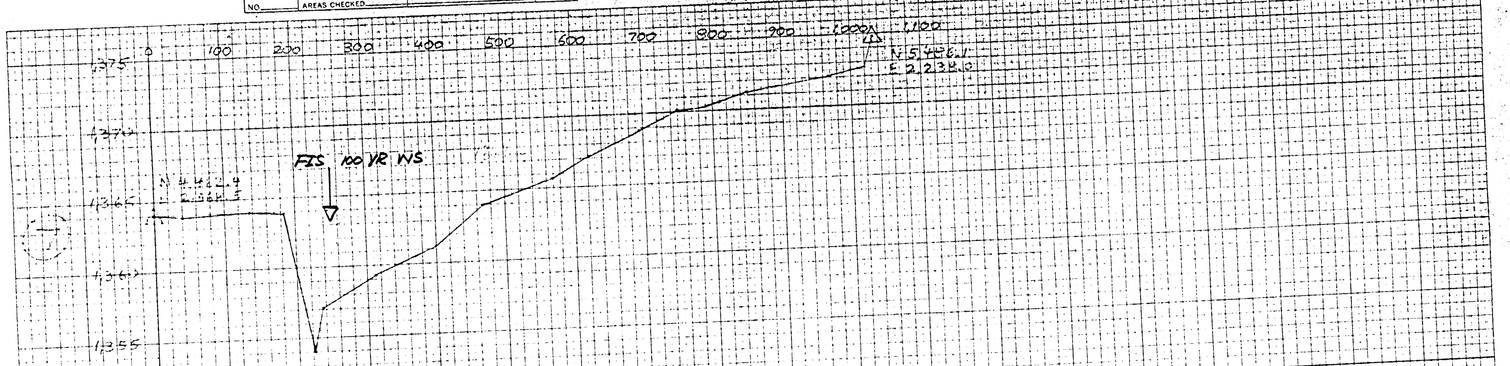

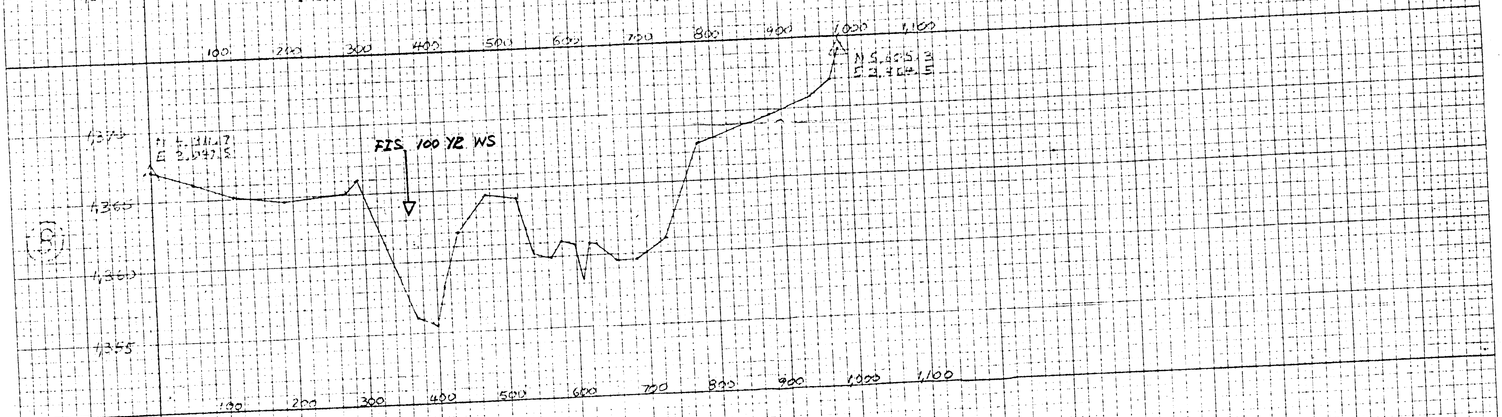

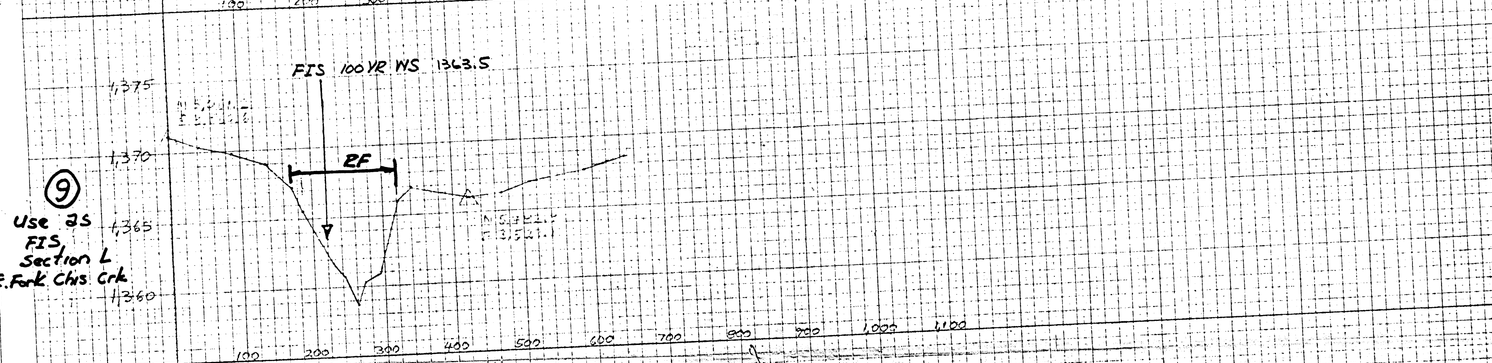

9

Use as FIS Section L E. Fork Chis. Crk.

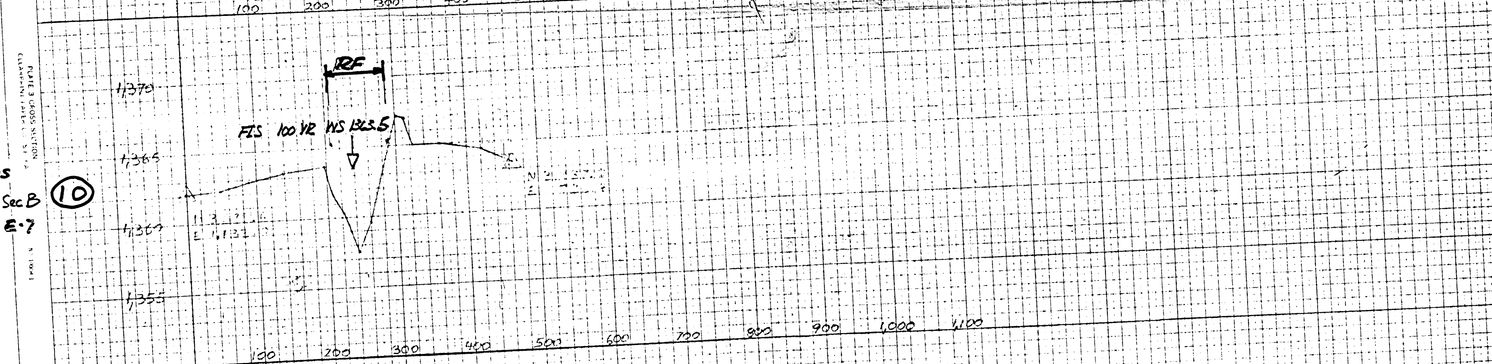

Use as FIS Sec B Trib E-7

10

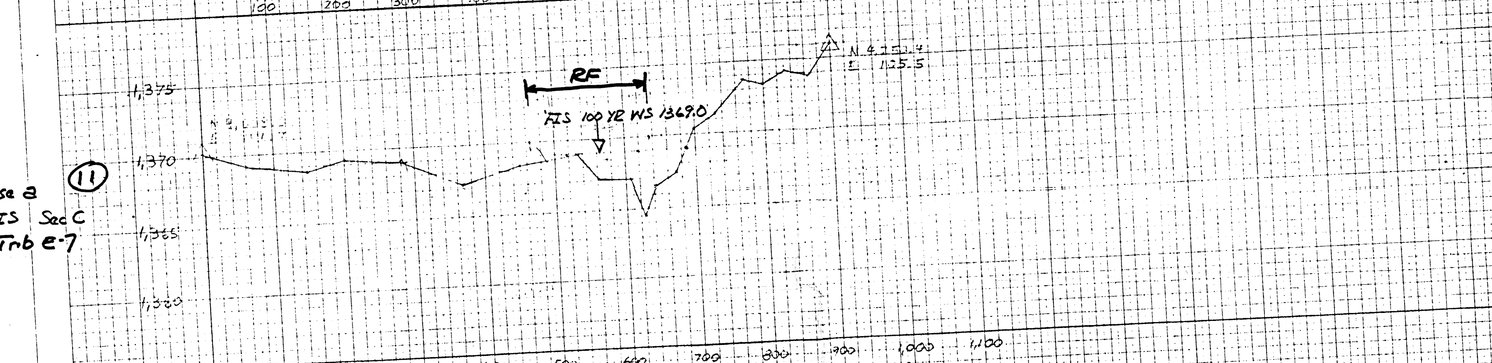

11

Use a FIS Sec C Trib E-7

CHISHOLM CREEK - #8057
Road 2-3-81
Land office - Oliver