

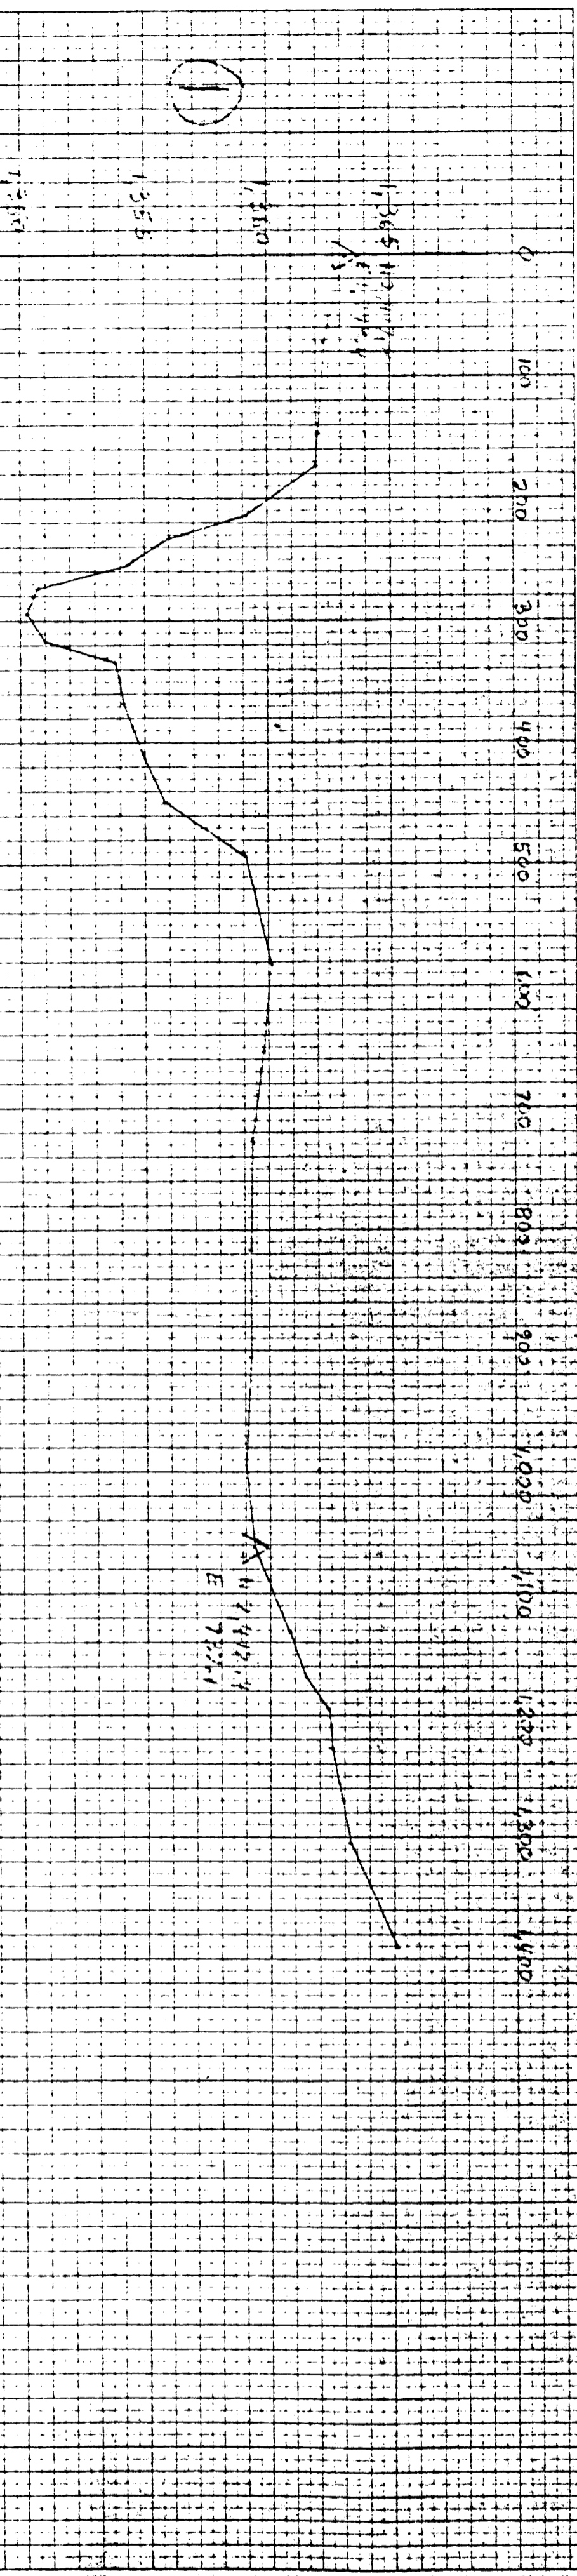
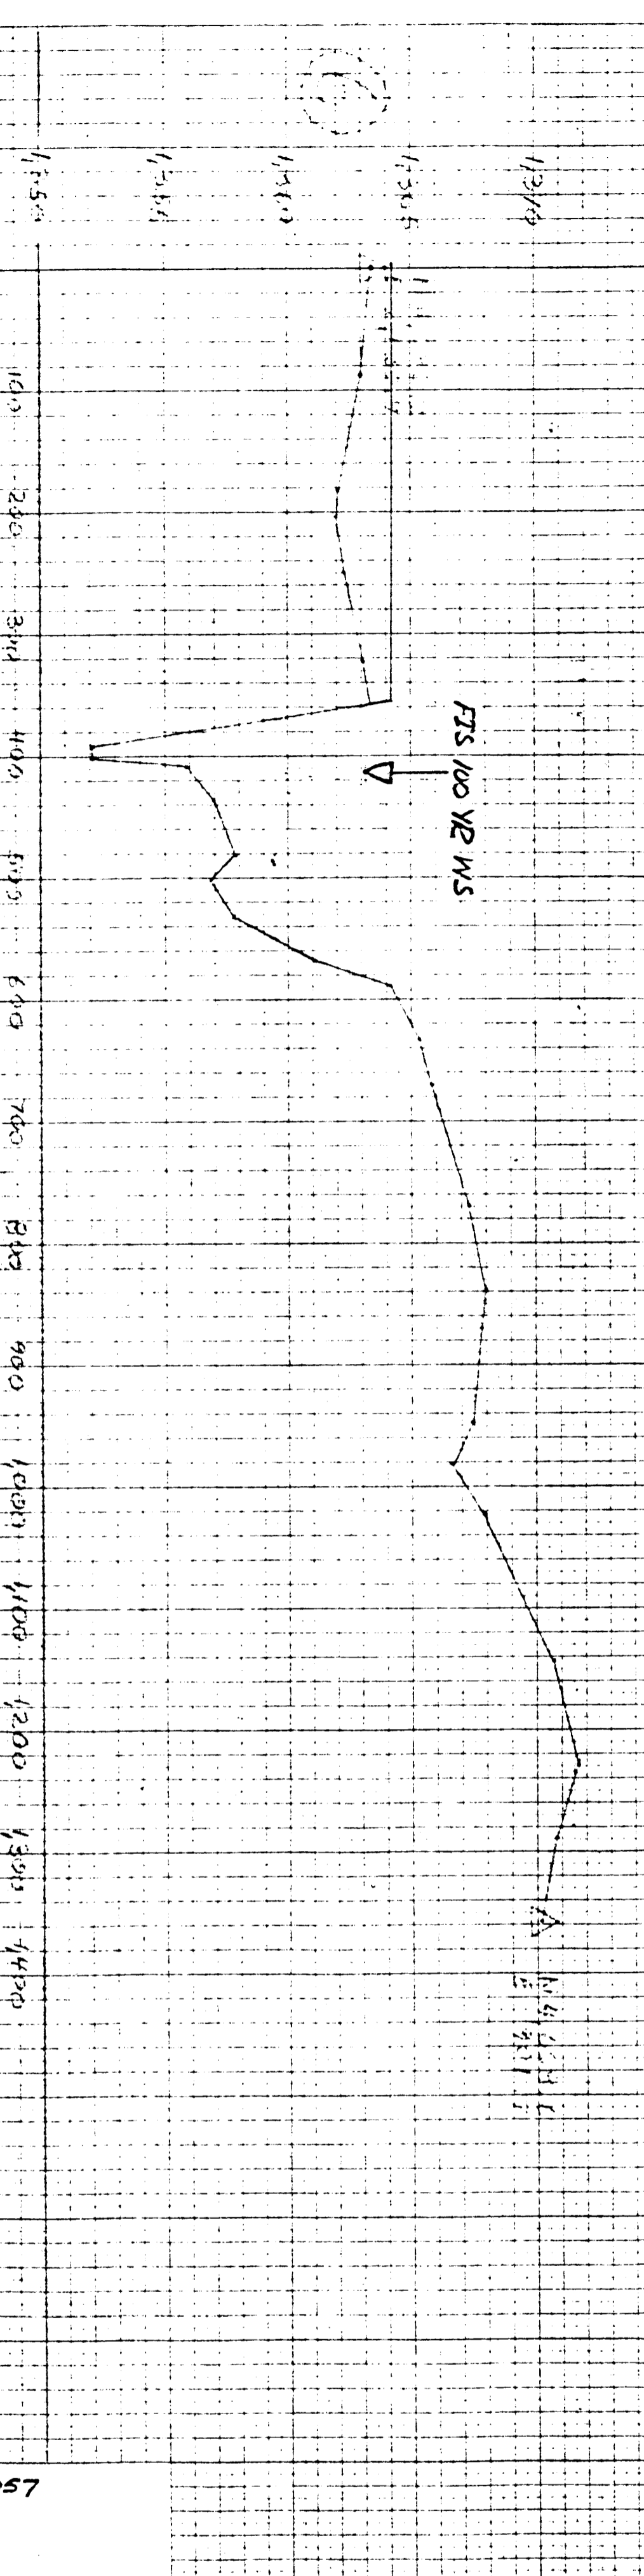
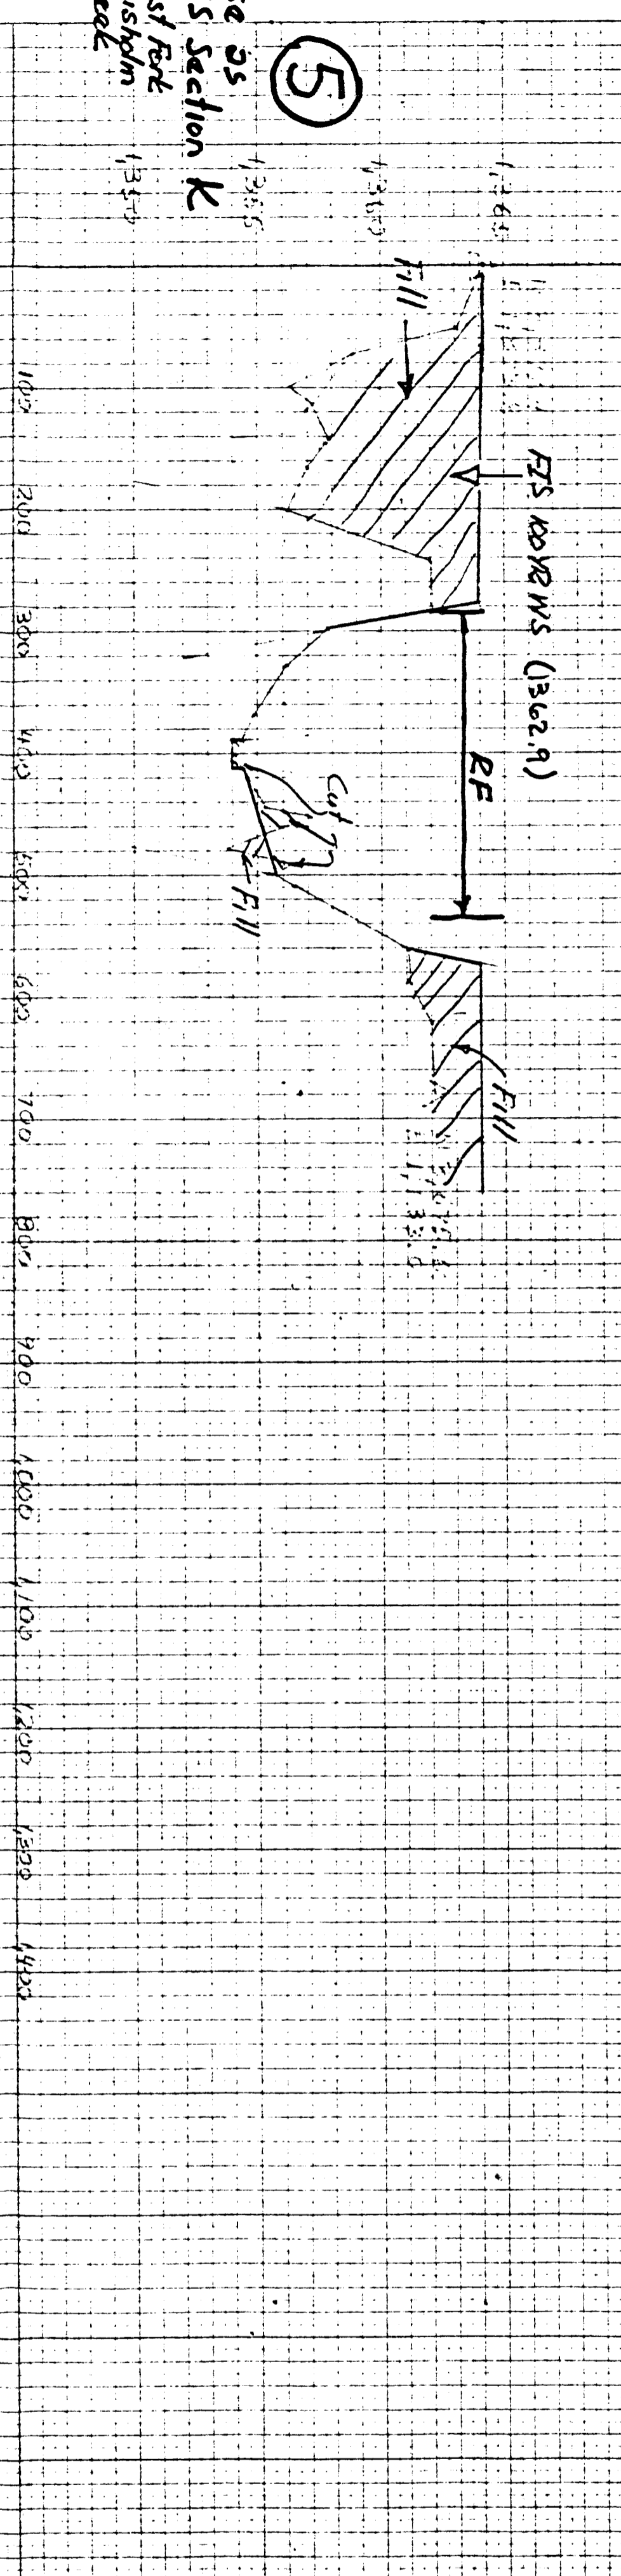
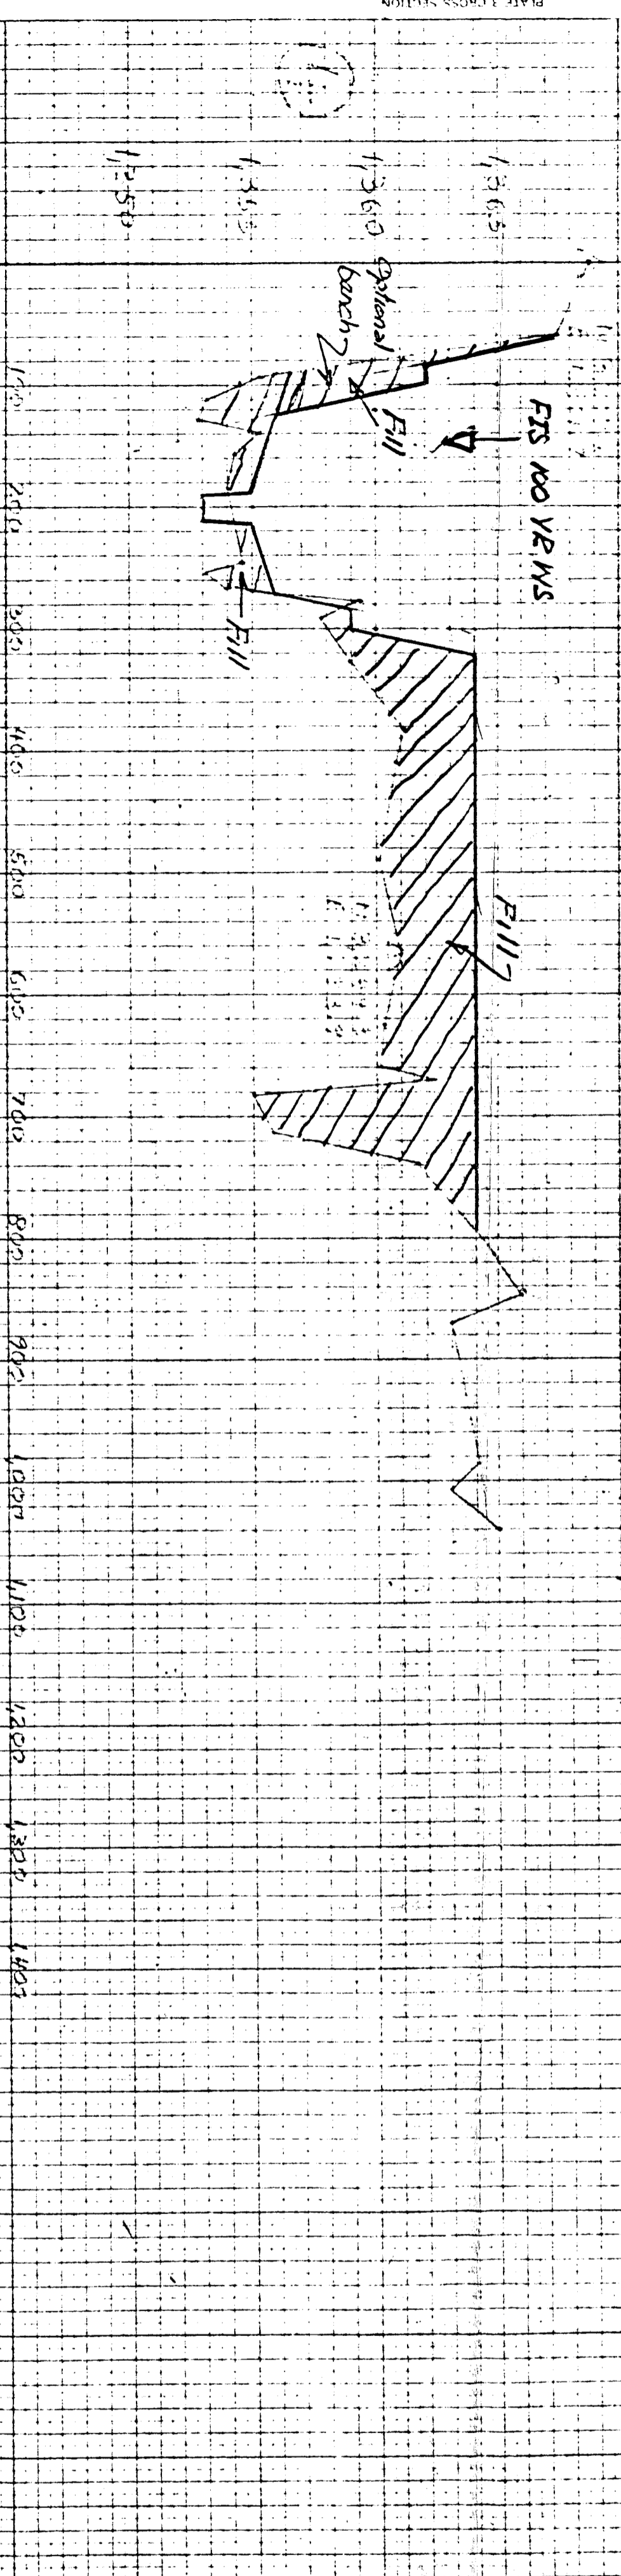


ORIGINAL	NUMBER	DATE
SUBMIT	10010	
NOT BOOK		
AREA CHECKED		

TOTAL	DATE
SUBMIT	
NOT BOOK	
AREA CHECKED	

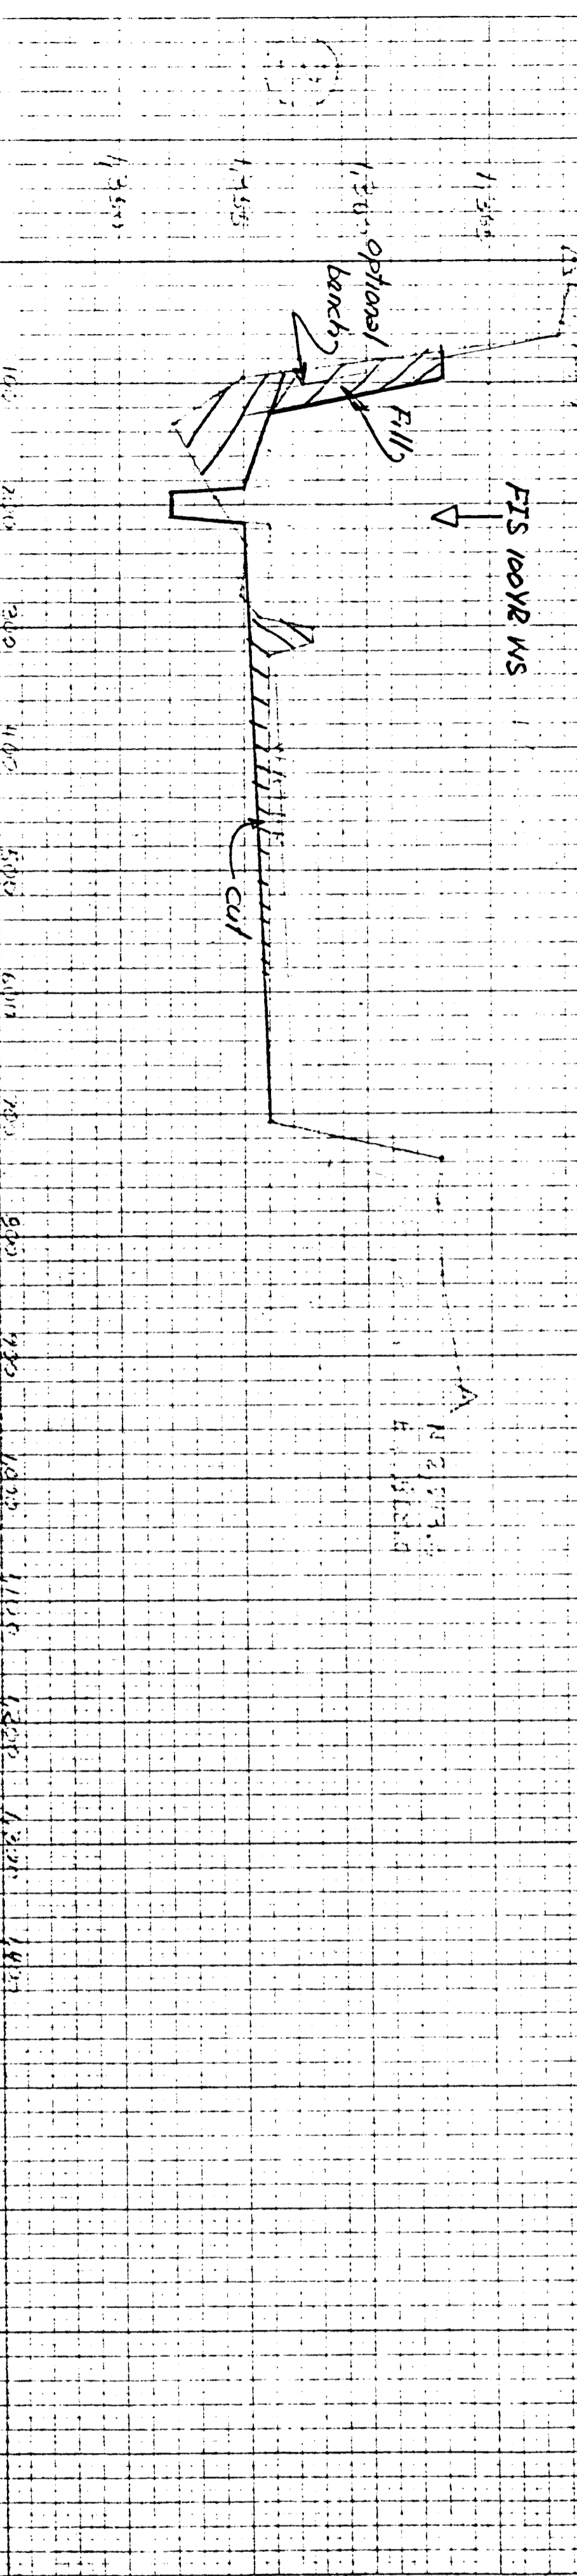

Move to
110' US
& 374'
Use as FIS
Section
East Fork
Chisholm Creek

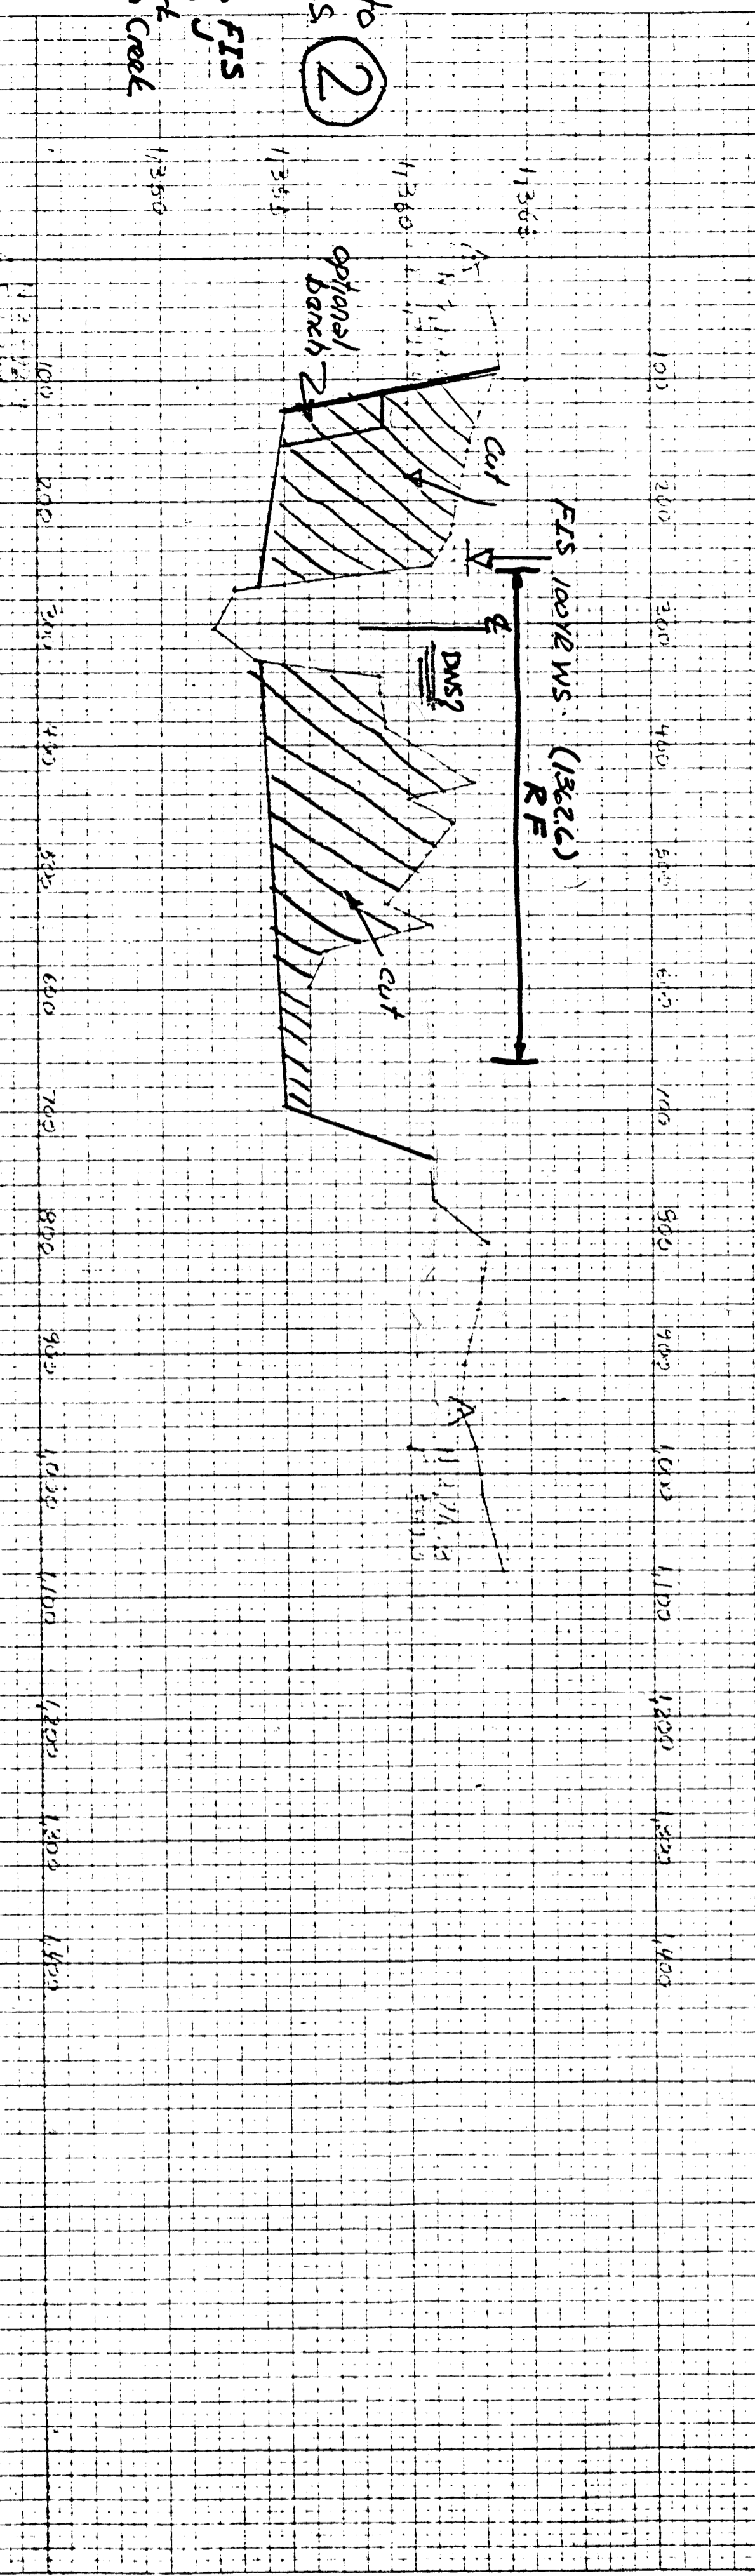

CHISHOLM CREEK - #8057
Reed 2-3-81
Land office - Oliver