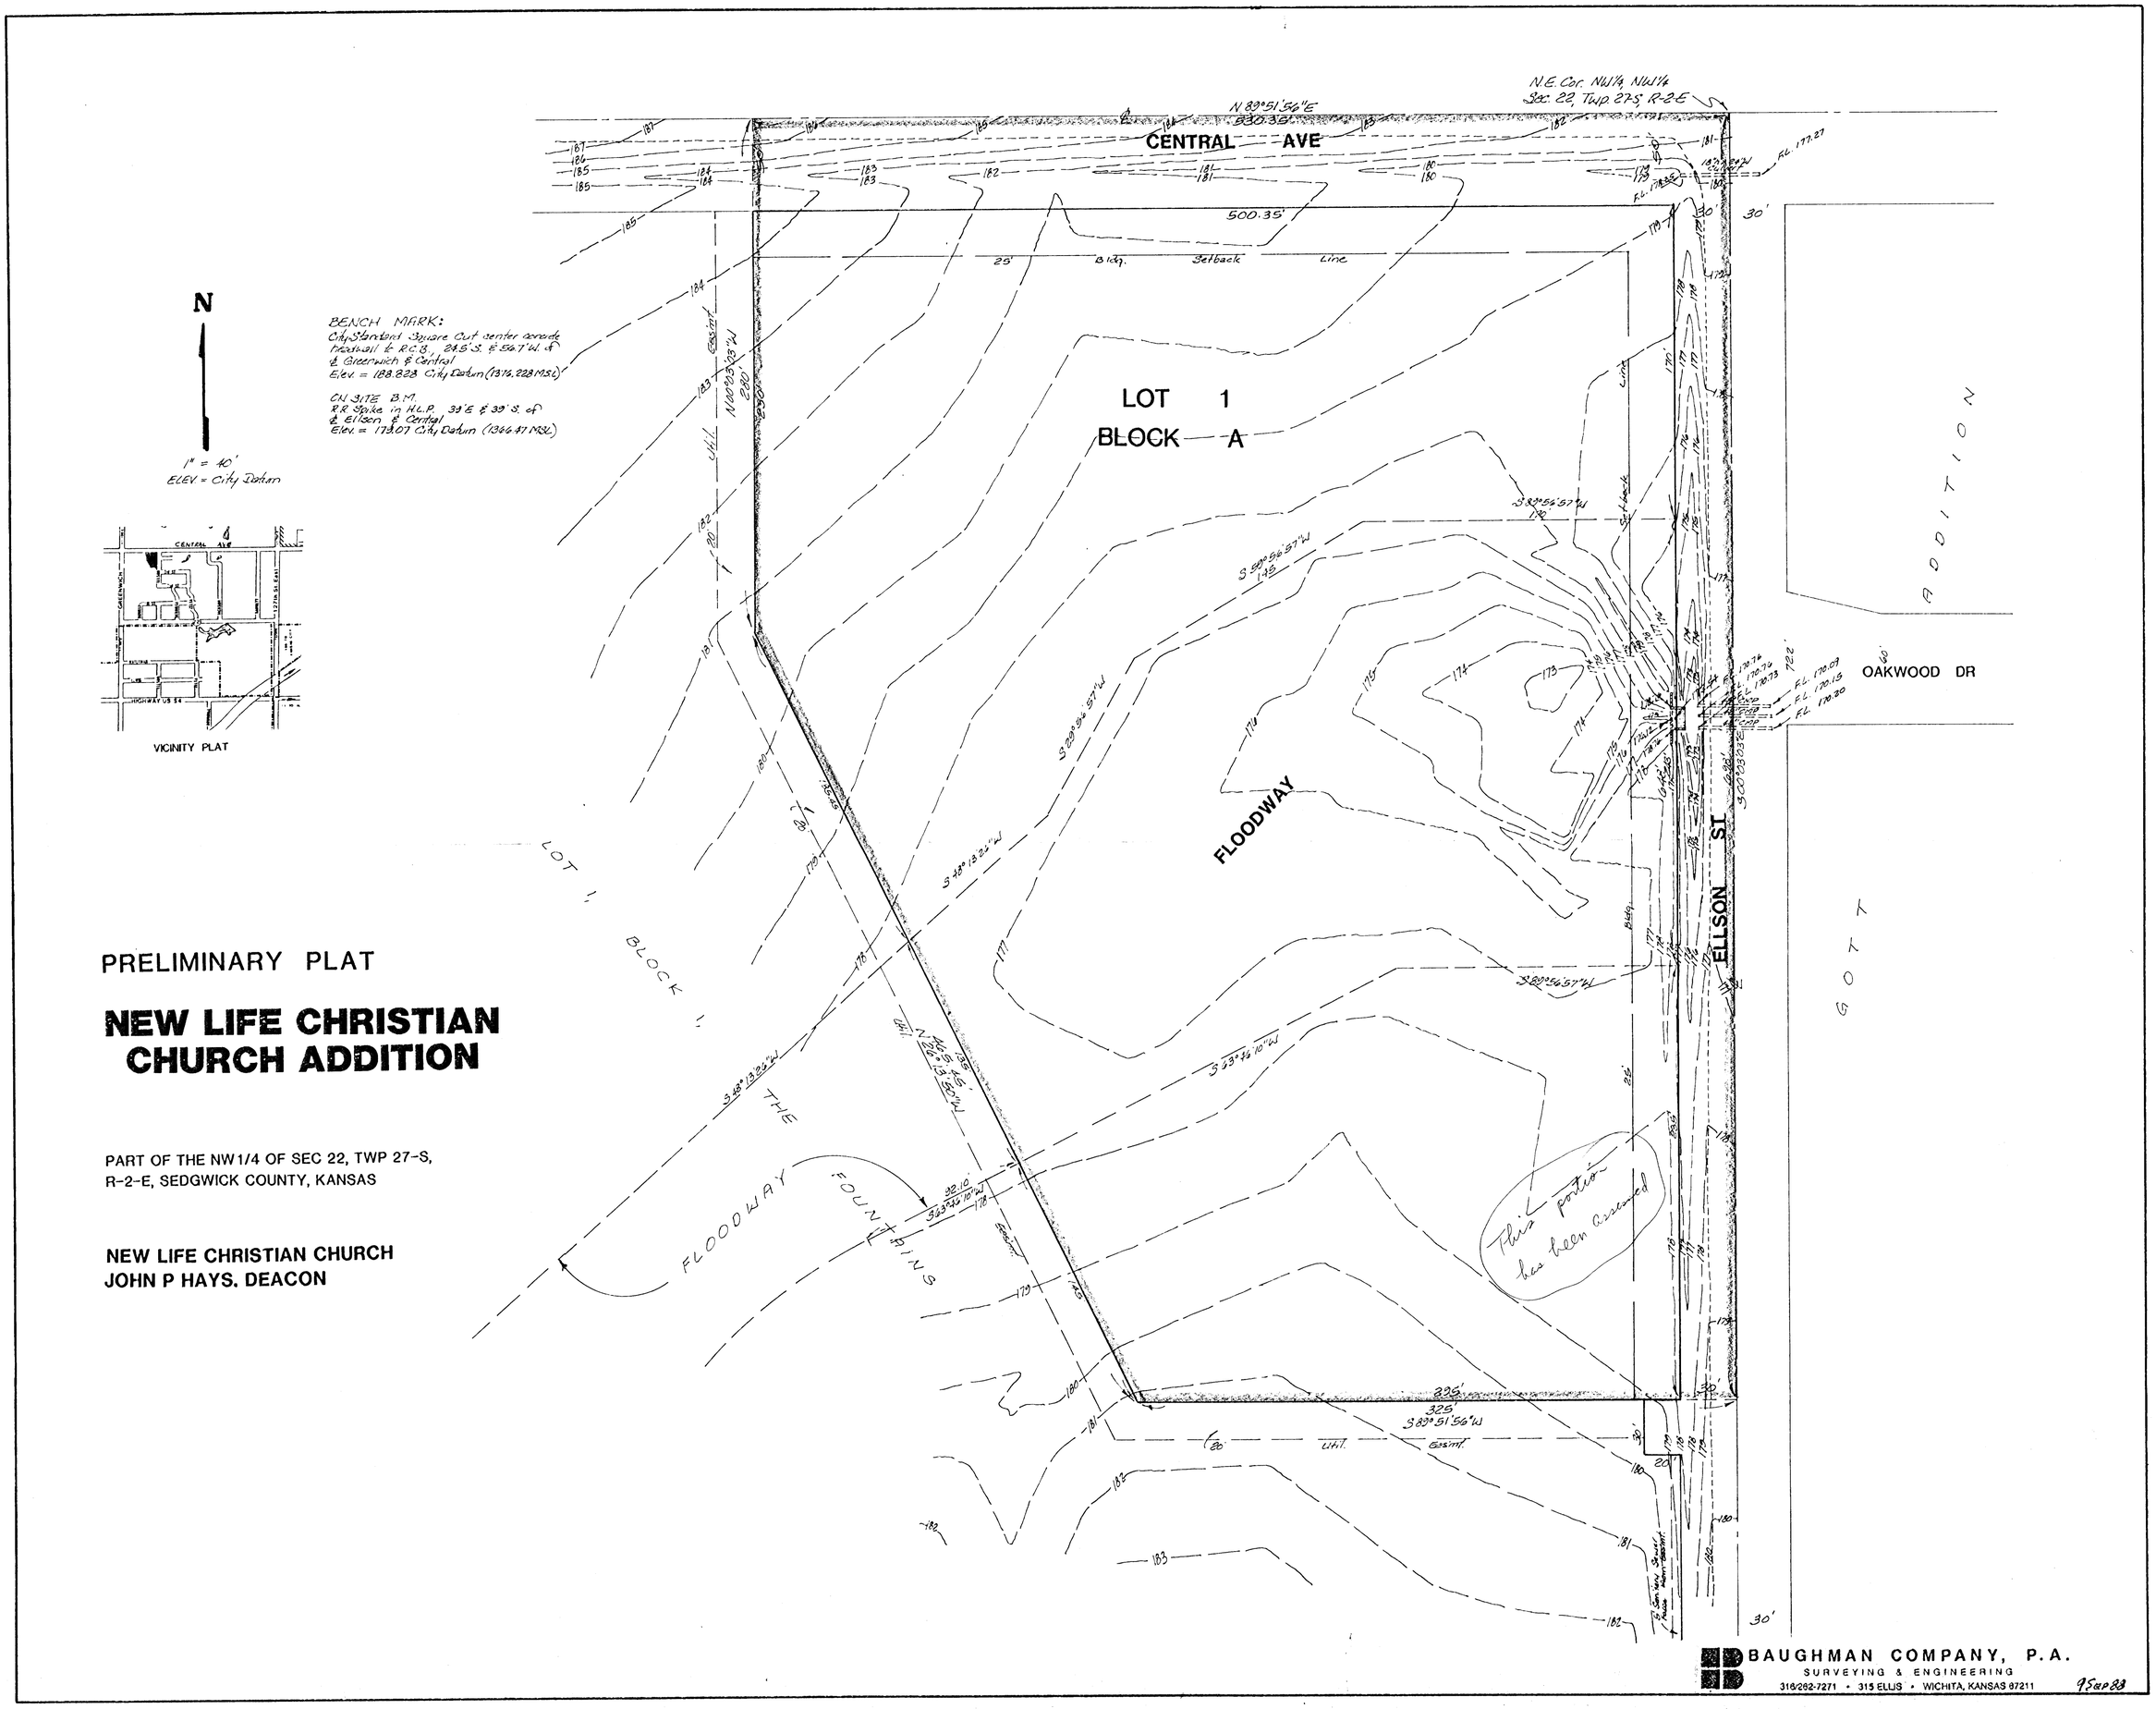

PRELIMINARY PLAT

NEW LIFE CHRISTIAN CHURCH ADDITION

PART OF THE NW1/4 OF SEC 22, TWP 27-S, R-2-E, SEDGWICK COUNTY, KANSAS

NEW LIFE CHRISTIAN CHURCH
JOHN P HAYS, DEACON

BAUGHMAN COMPANY, P.A.
SURVEYING & ENGINEERING
316/262-7271 • 315 ELLIS • WICHITA, KANSAS 67211

9 Sep 88