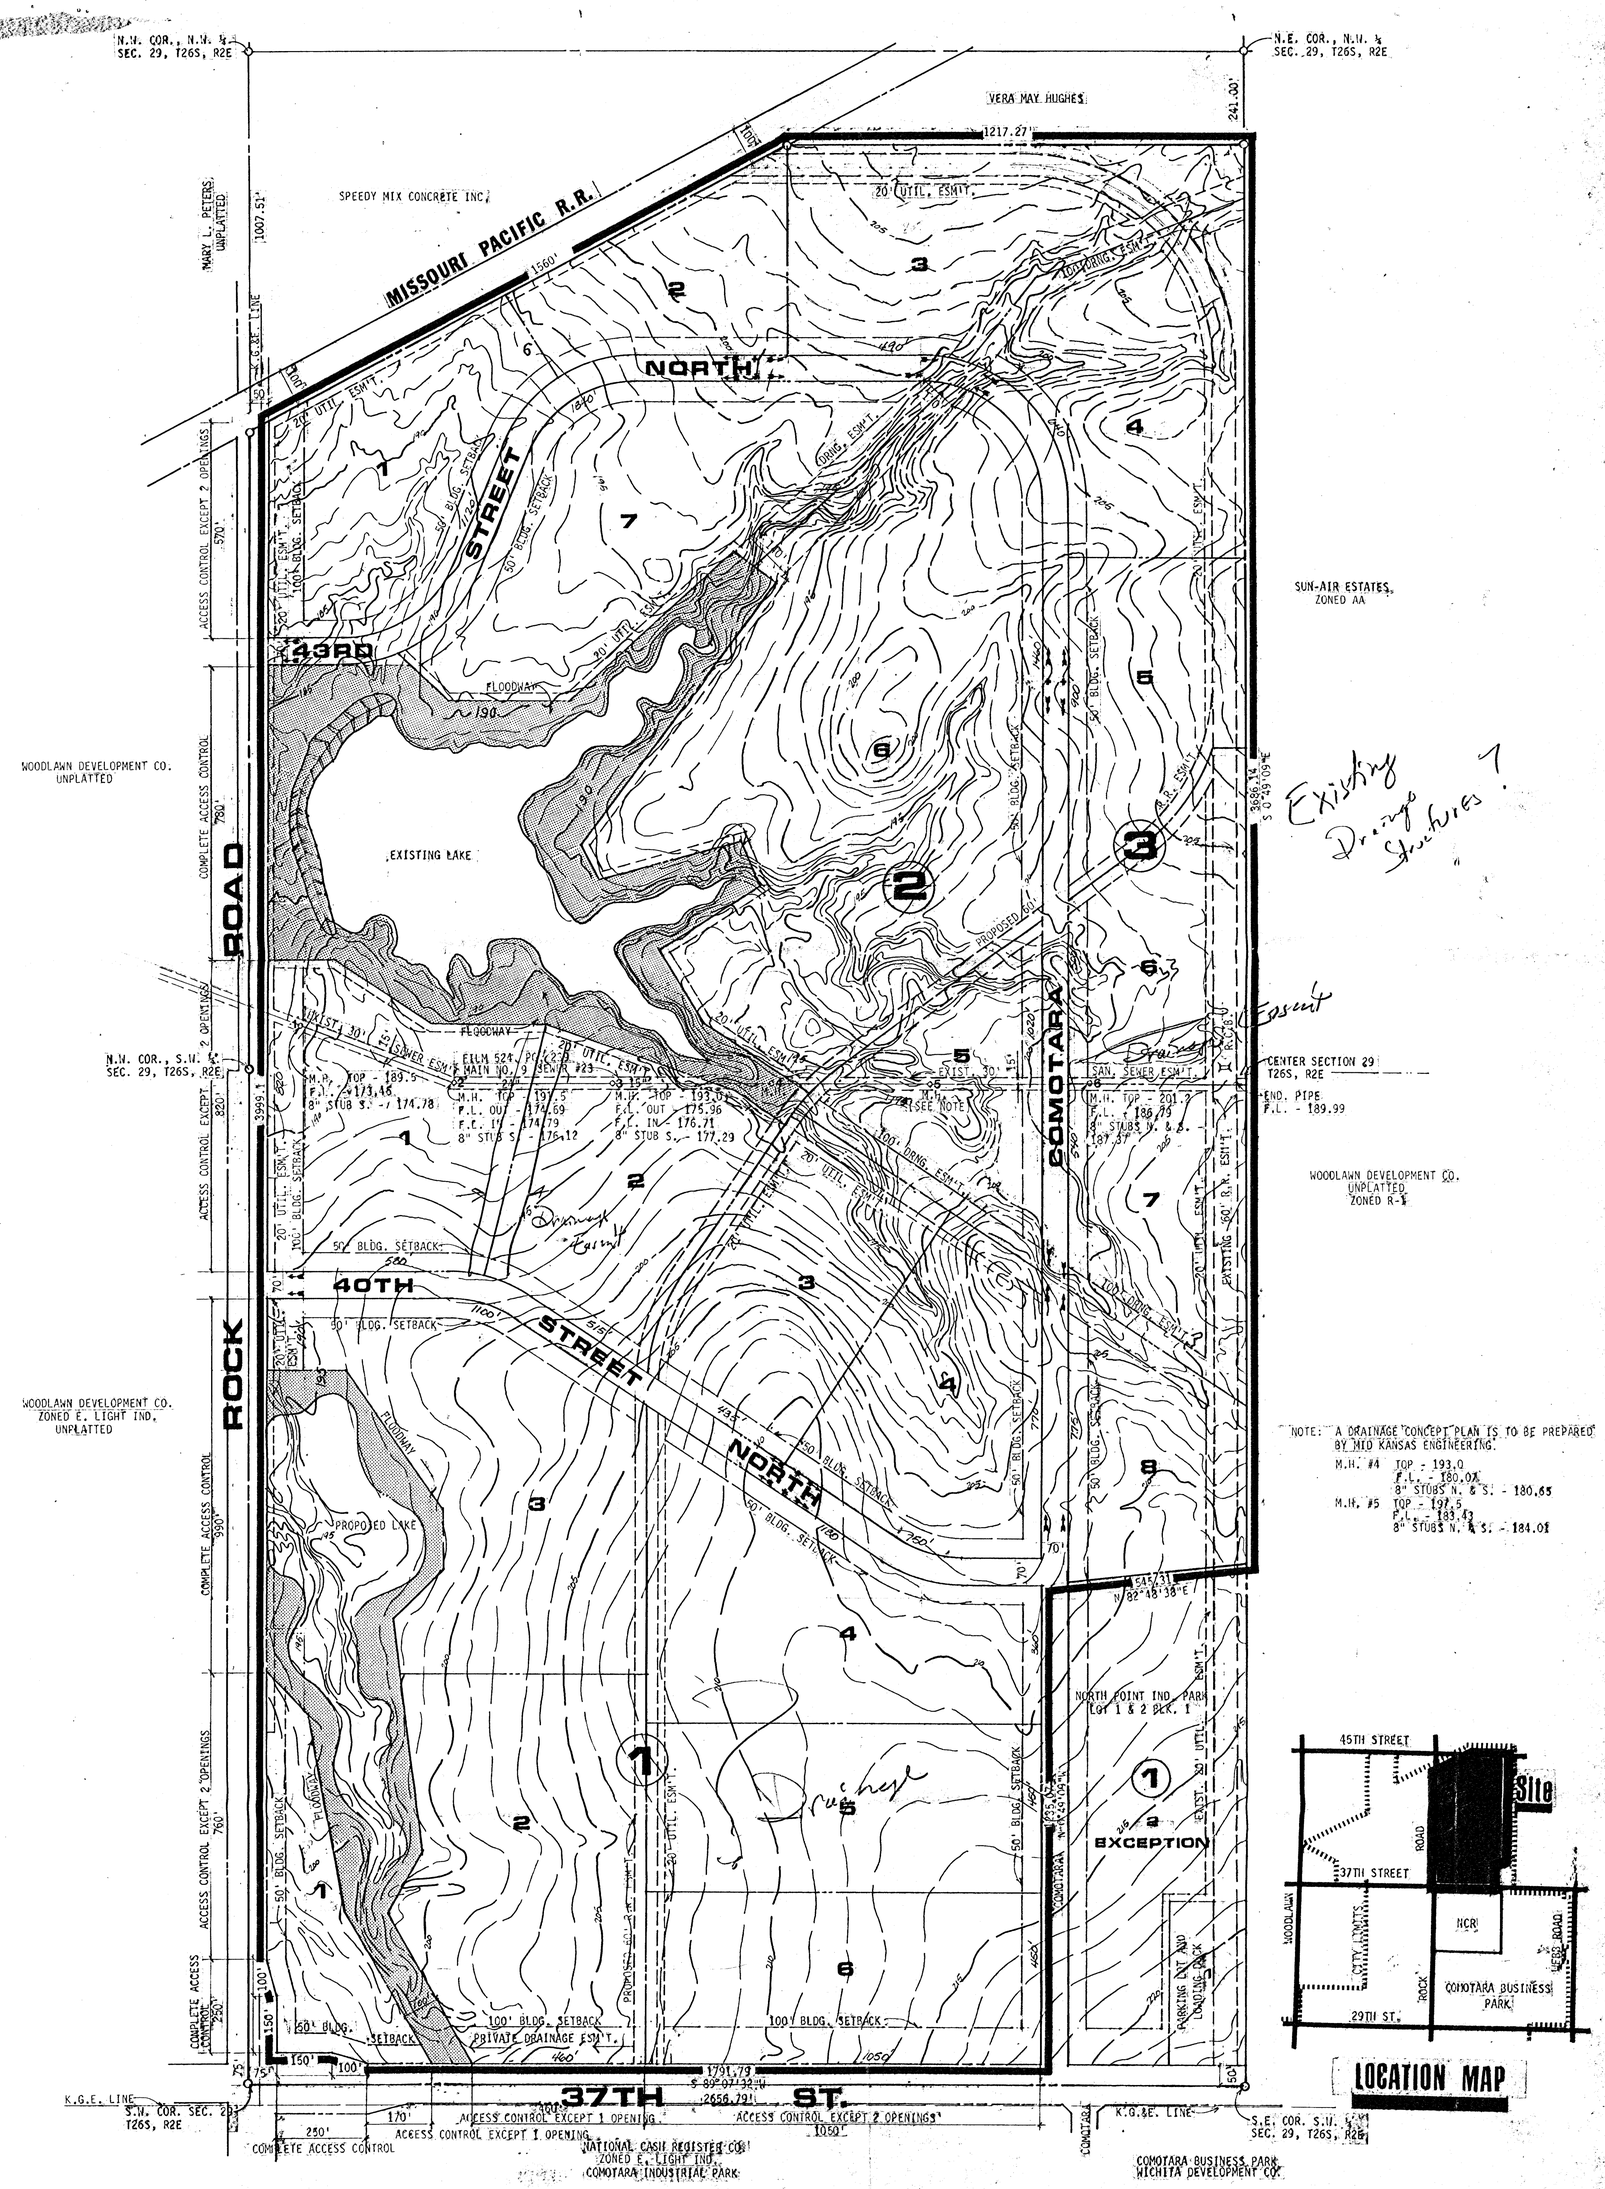

Existing Drainage Structures?

Easement

NORTH POINT INDUSTRIAL PARK 2ND

PRELIMINARY PLAT

COMOTARA

DATE: [illegible] 1982

1" CONTOUR INTERVAL

BILL G. YUNG DESIGN
8225 E. 37TH ST. NORTH WICHITA KS 67226 · 316 683-5567