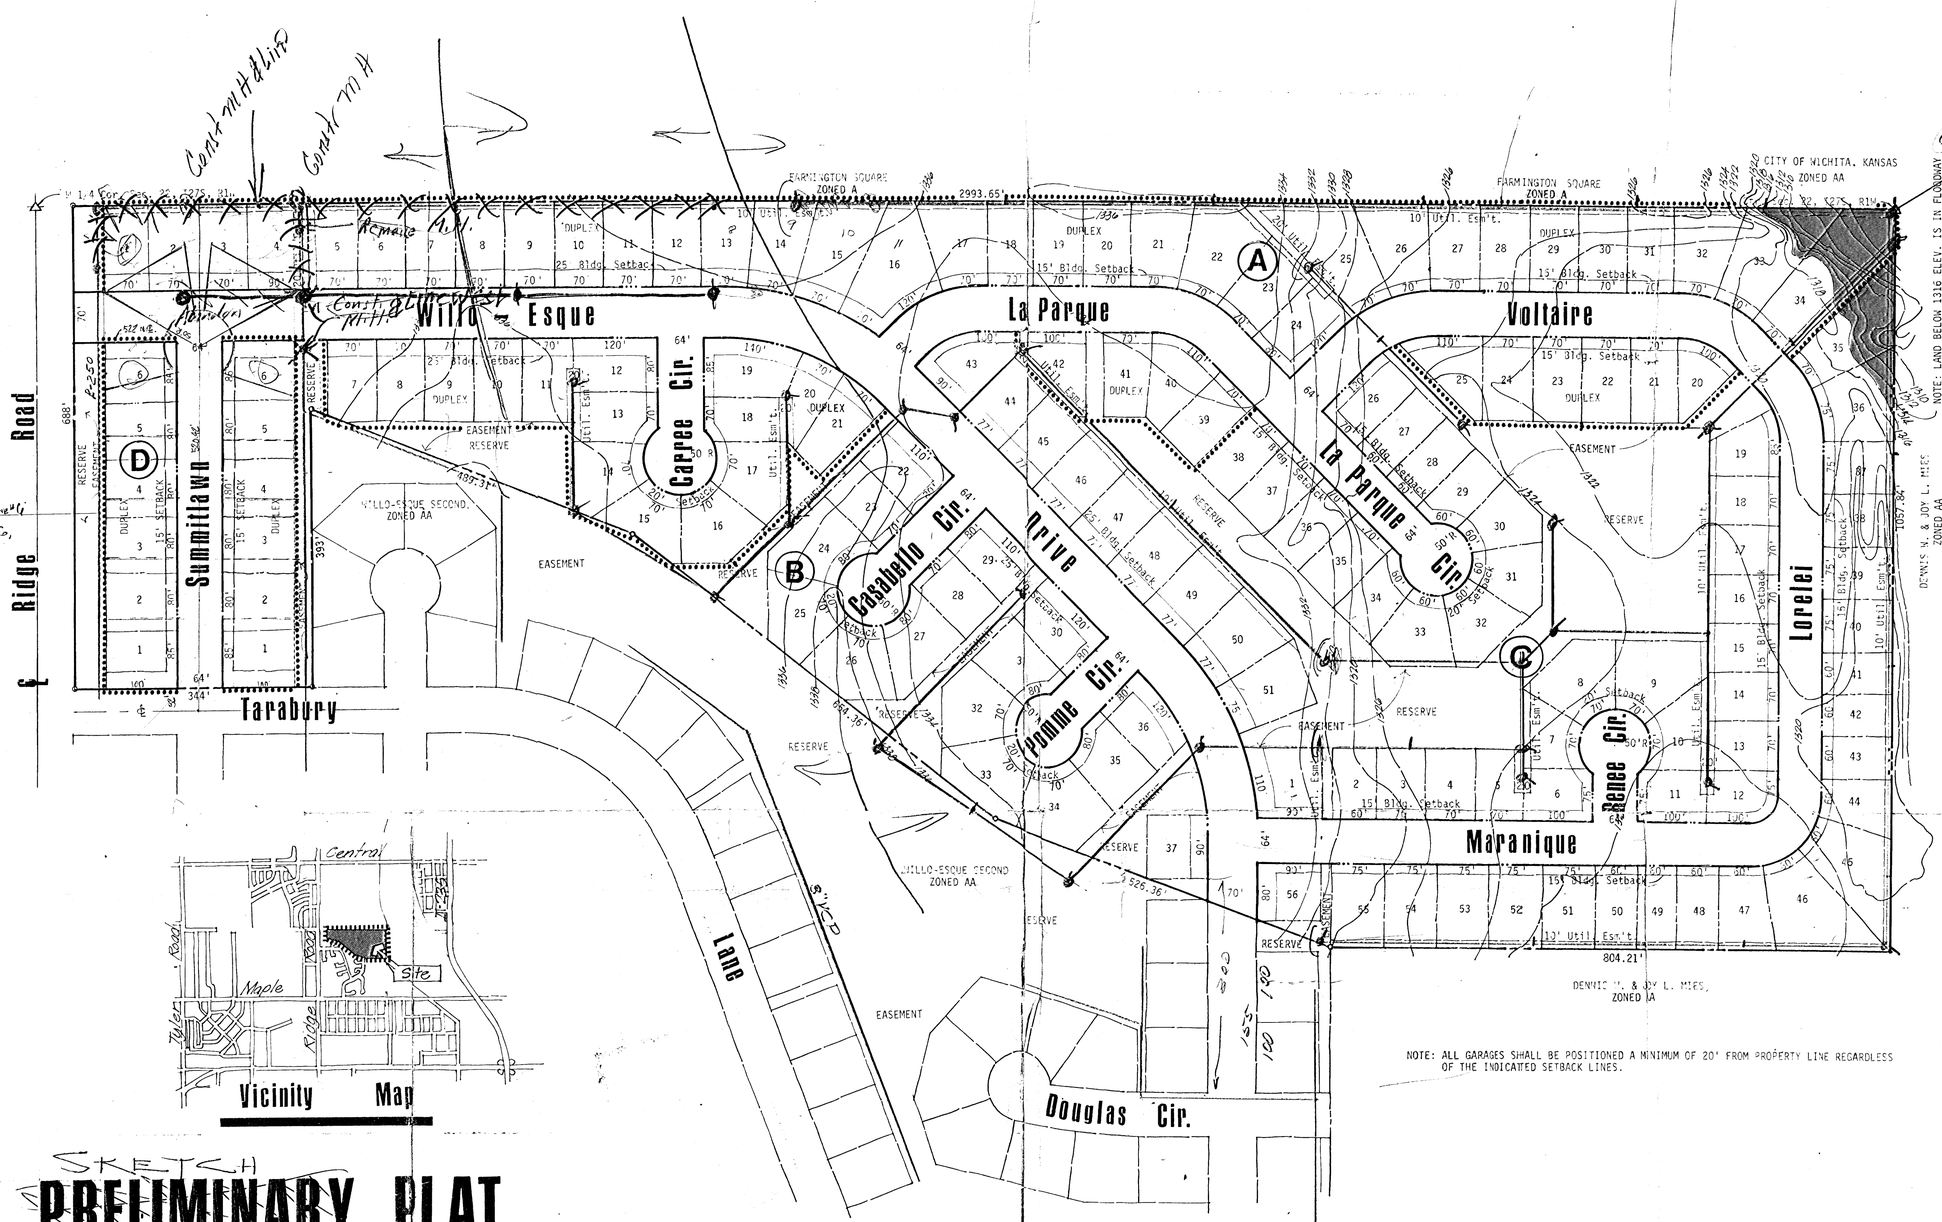

SKETCH

PRELIMINARY PLAT

WILLO-ESQUE THIRD

L.C. INVESTMENT, INC., WICHITA, KANSAS

Delamater · Freund & Scherer, P.A. · Engineers
412 CENTURY PLAZA, WICHITA, KANSAS

Bill G. Yung · Design Consultant
1365 NORTH MACO, WICHITA, KANSAS 316-264-0676