
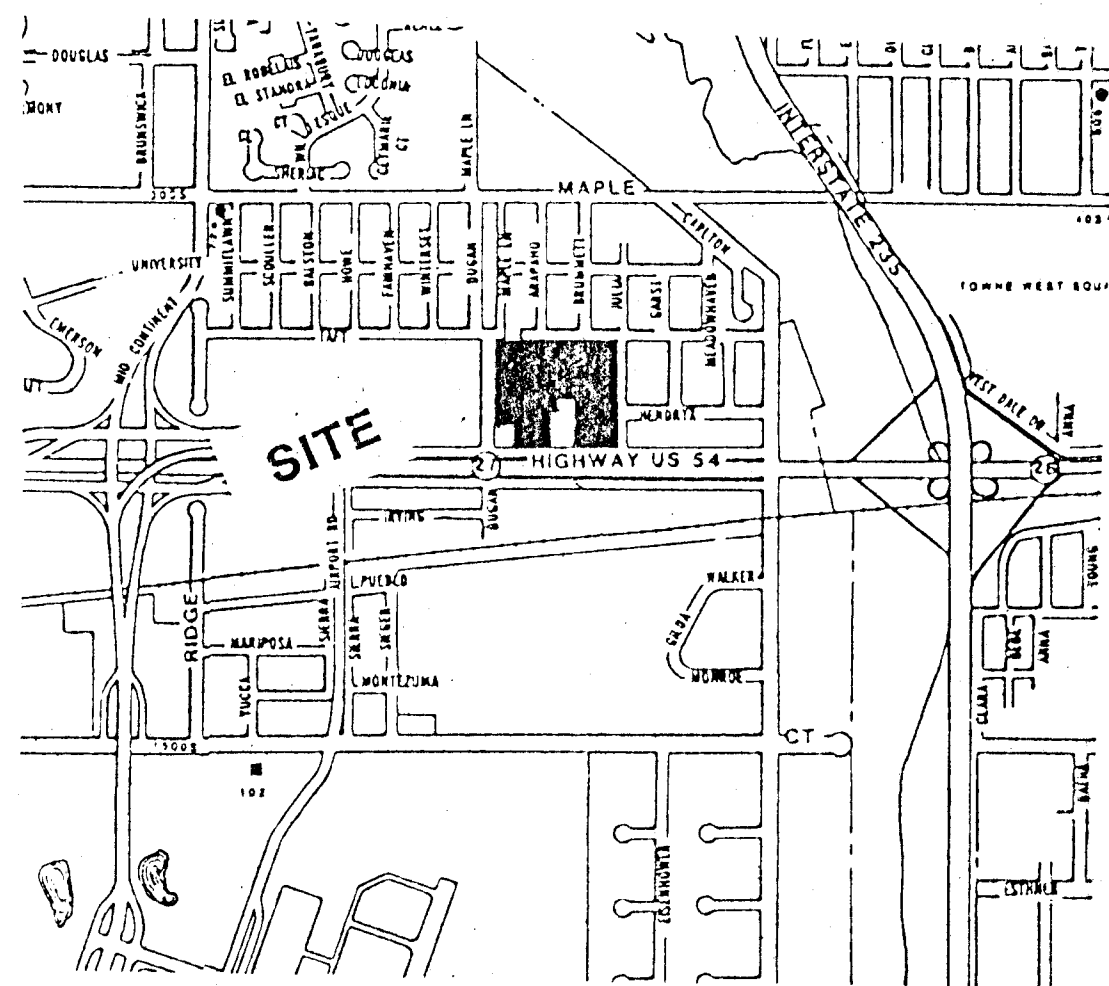


PRELIMINARY PLAT


**THE LANDING
2ND ADDITION**

PART PART OF LOT 1, AIR PARK SECOND
ADDITION AND LOT 1, THE LANDING

ROYAL ASSOCIATES & WAL-MART PROPERTIES, INC

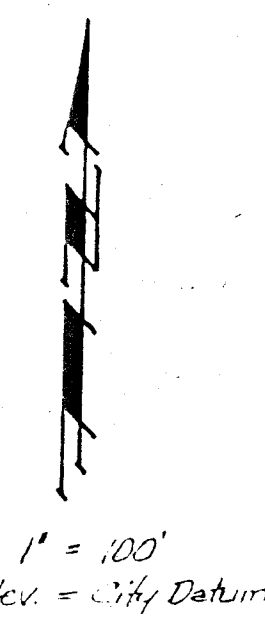

VICINITY PLAT

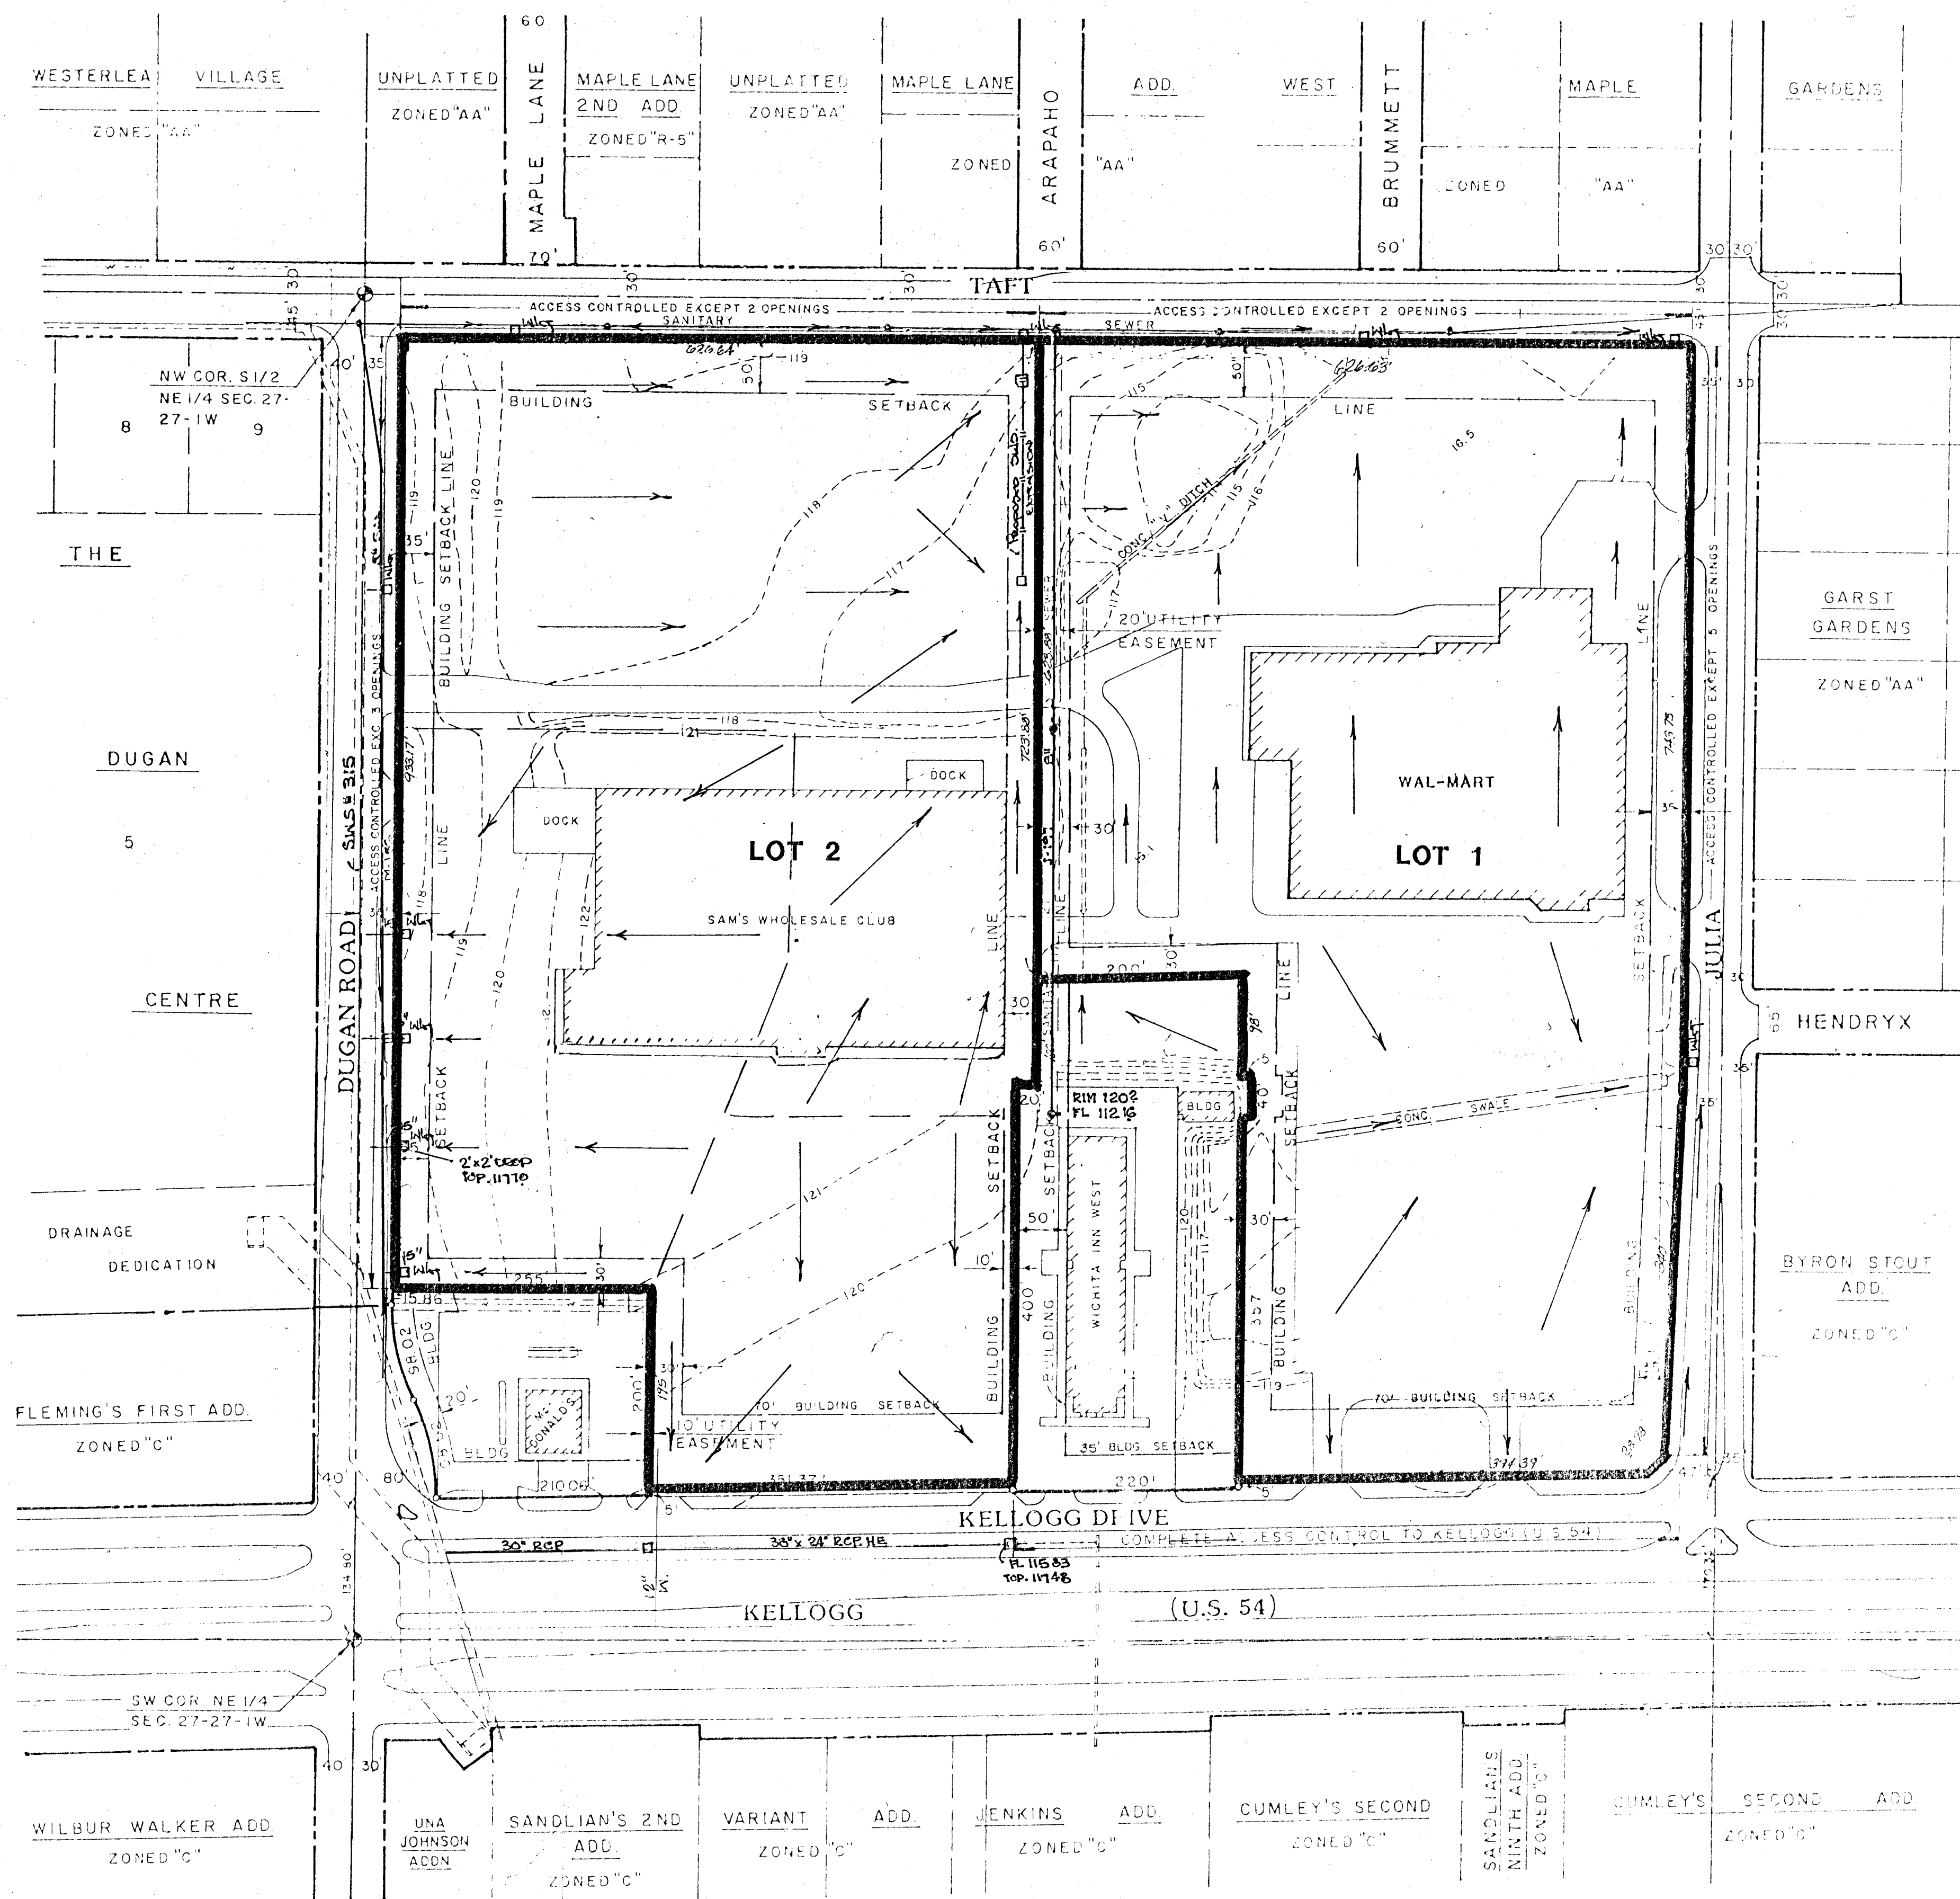

m-156

DRAINAGE CONCEPT

BAUGHMAN COMPANY, P.A.
SURVEYING & ENGINEERING
316262-7271 • 315 ELLIS • WICHITA, KANSAS 67211

22 MAR 11 1970