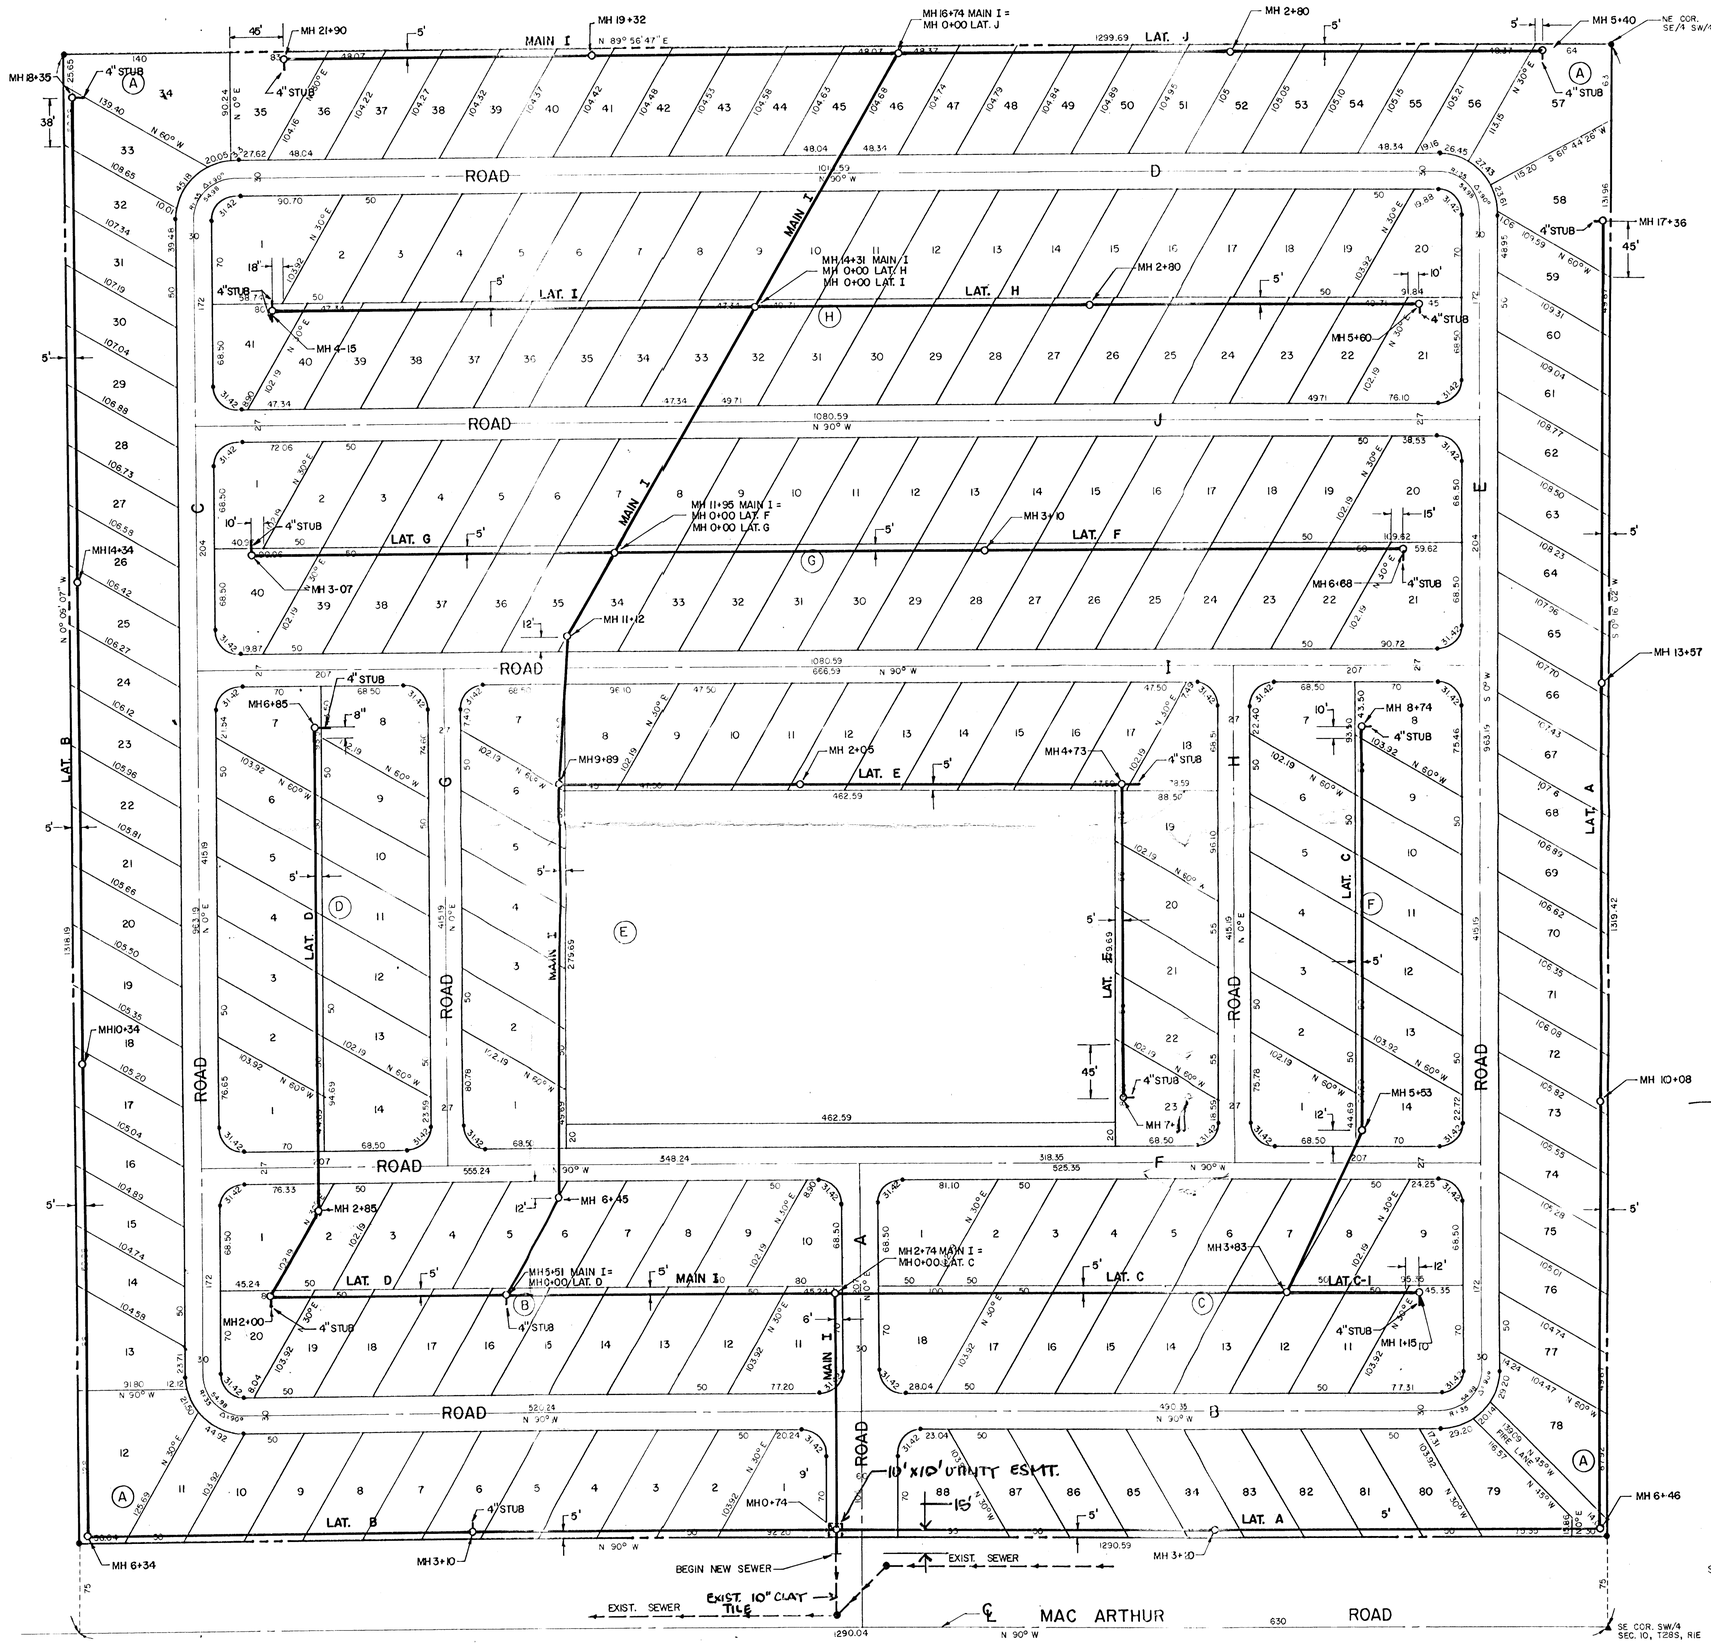

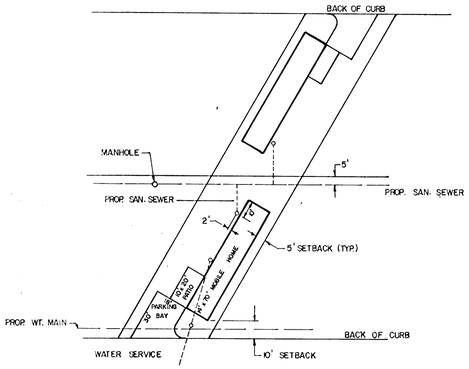

TYPICAL SITE LAYOUT
1" = 40'

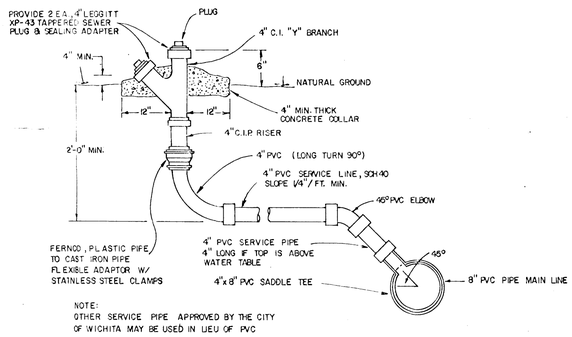

NOTE:
OTHER SERVICE PIPE APPROVED BY THE CITY OF WICHITA MAY BE USED IN LIEU OF PVC

TYPICAL SEWER CONNECTION

GUARANTEE FOR S.S. EXTENSION : FOR REF. PURPOSES

QUANTITIES

15 L.F. 10" CLAY TILE PIPE @
7.4 L.F. MANHOLE

20' pipe @ $30 = 600
1 MH @ $2500 = 2500
3100
+ 30% 900
4000

SEWER SYSTEM

LAMPLIGHTER MOBILE HOME PARK

WICHITA, SEDGWICK COUNTY, KANSAS

N

SCALE: 1" = 60'

REISS & GOODNESS ENGINEERS
2160 WEST 21st STREET
WICHITA, KANSAS 67204
(316) 832-0213