


Ex 2-58'x36'x36' CMP

Ex 2-58'x36'x36' CMP

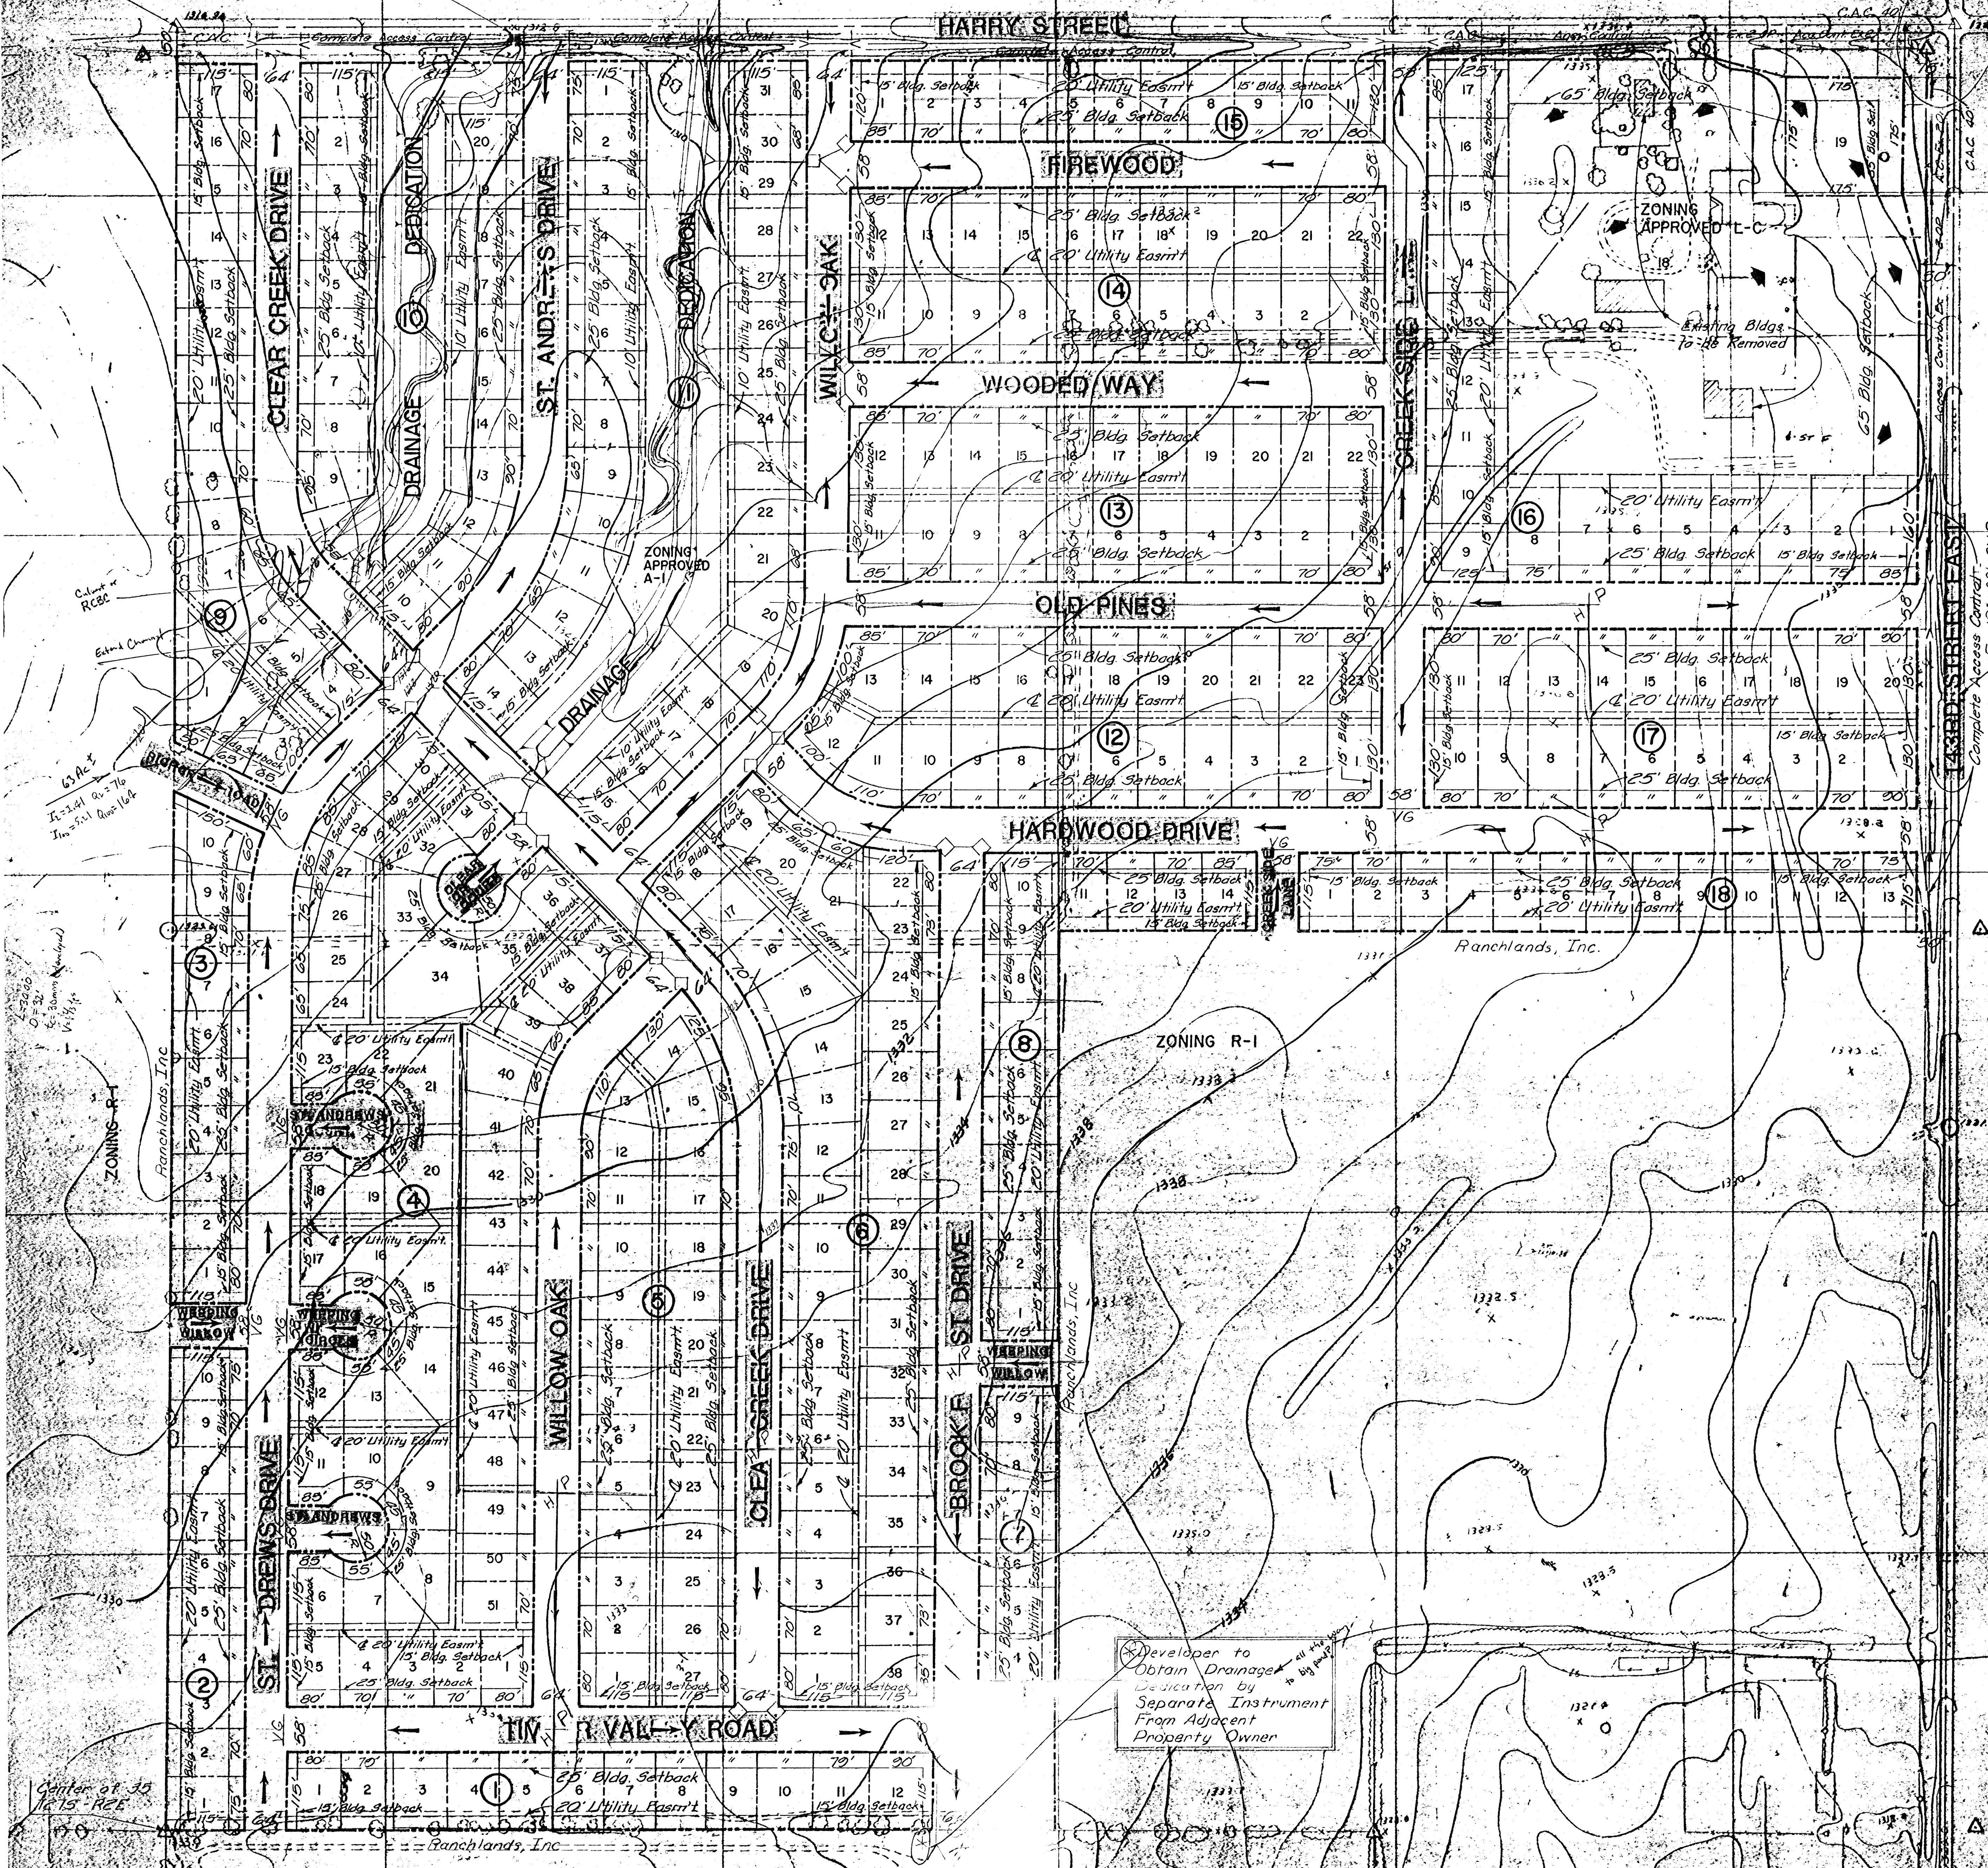


Developer to  
Obtain Drainage  
Dedication by  
Separate Instrument  
From Adjacent  
Property Owner

**TIMBER VALLEY**

OWNER: TIMBER VALLEY, INC.  
DEVELOPER: DERBY LAND COMPANY, INC.  
ENGINEER: PROFESSIONAL ENGINEERING CONSULTANTS, P.A.

Preliminary Drainage Concept 8/7/79  
Revision Requested for extra Ditch

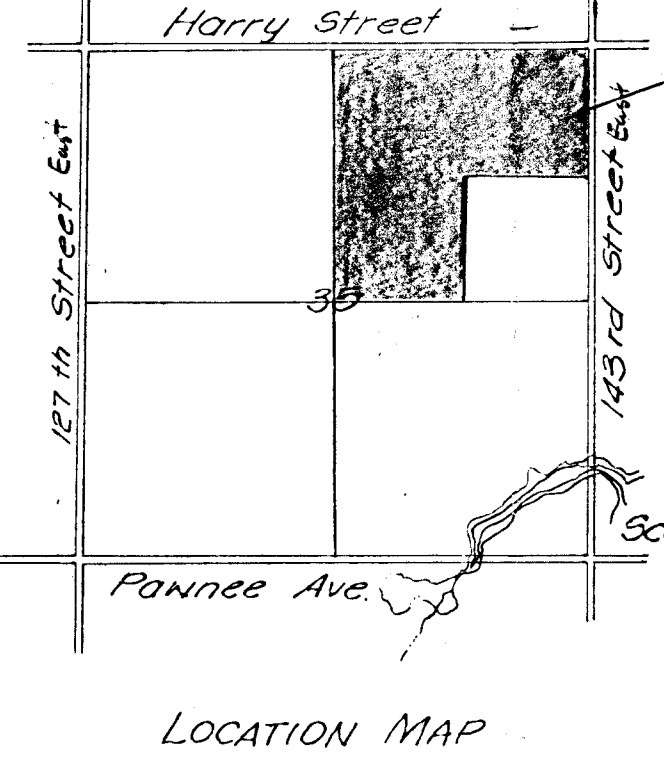

LOCATION MAP

APR 28 1980  
101 NE 3/4 Sec 25, T29  
R2E, N4W 122.25 (M3L)