


2.25 PM 7/25/61
P.M. 7/25/61
C.M. Baughman

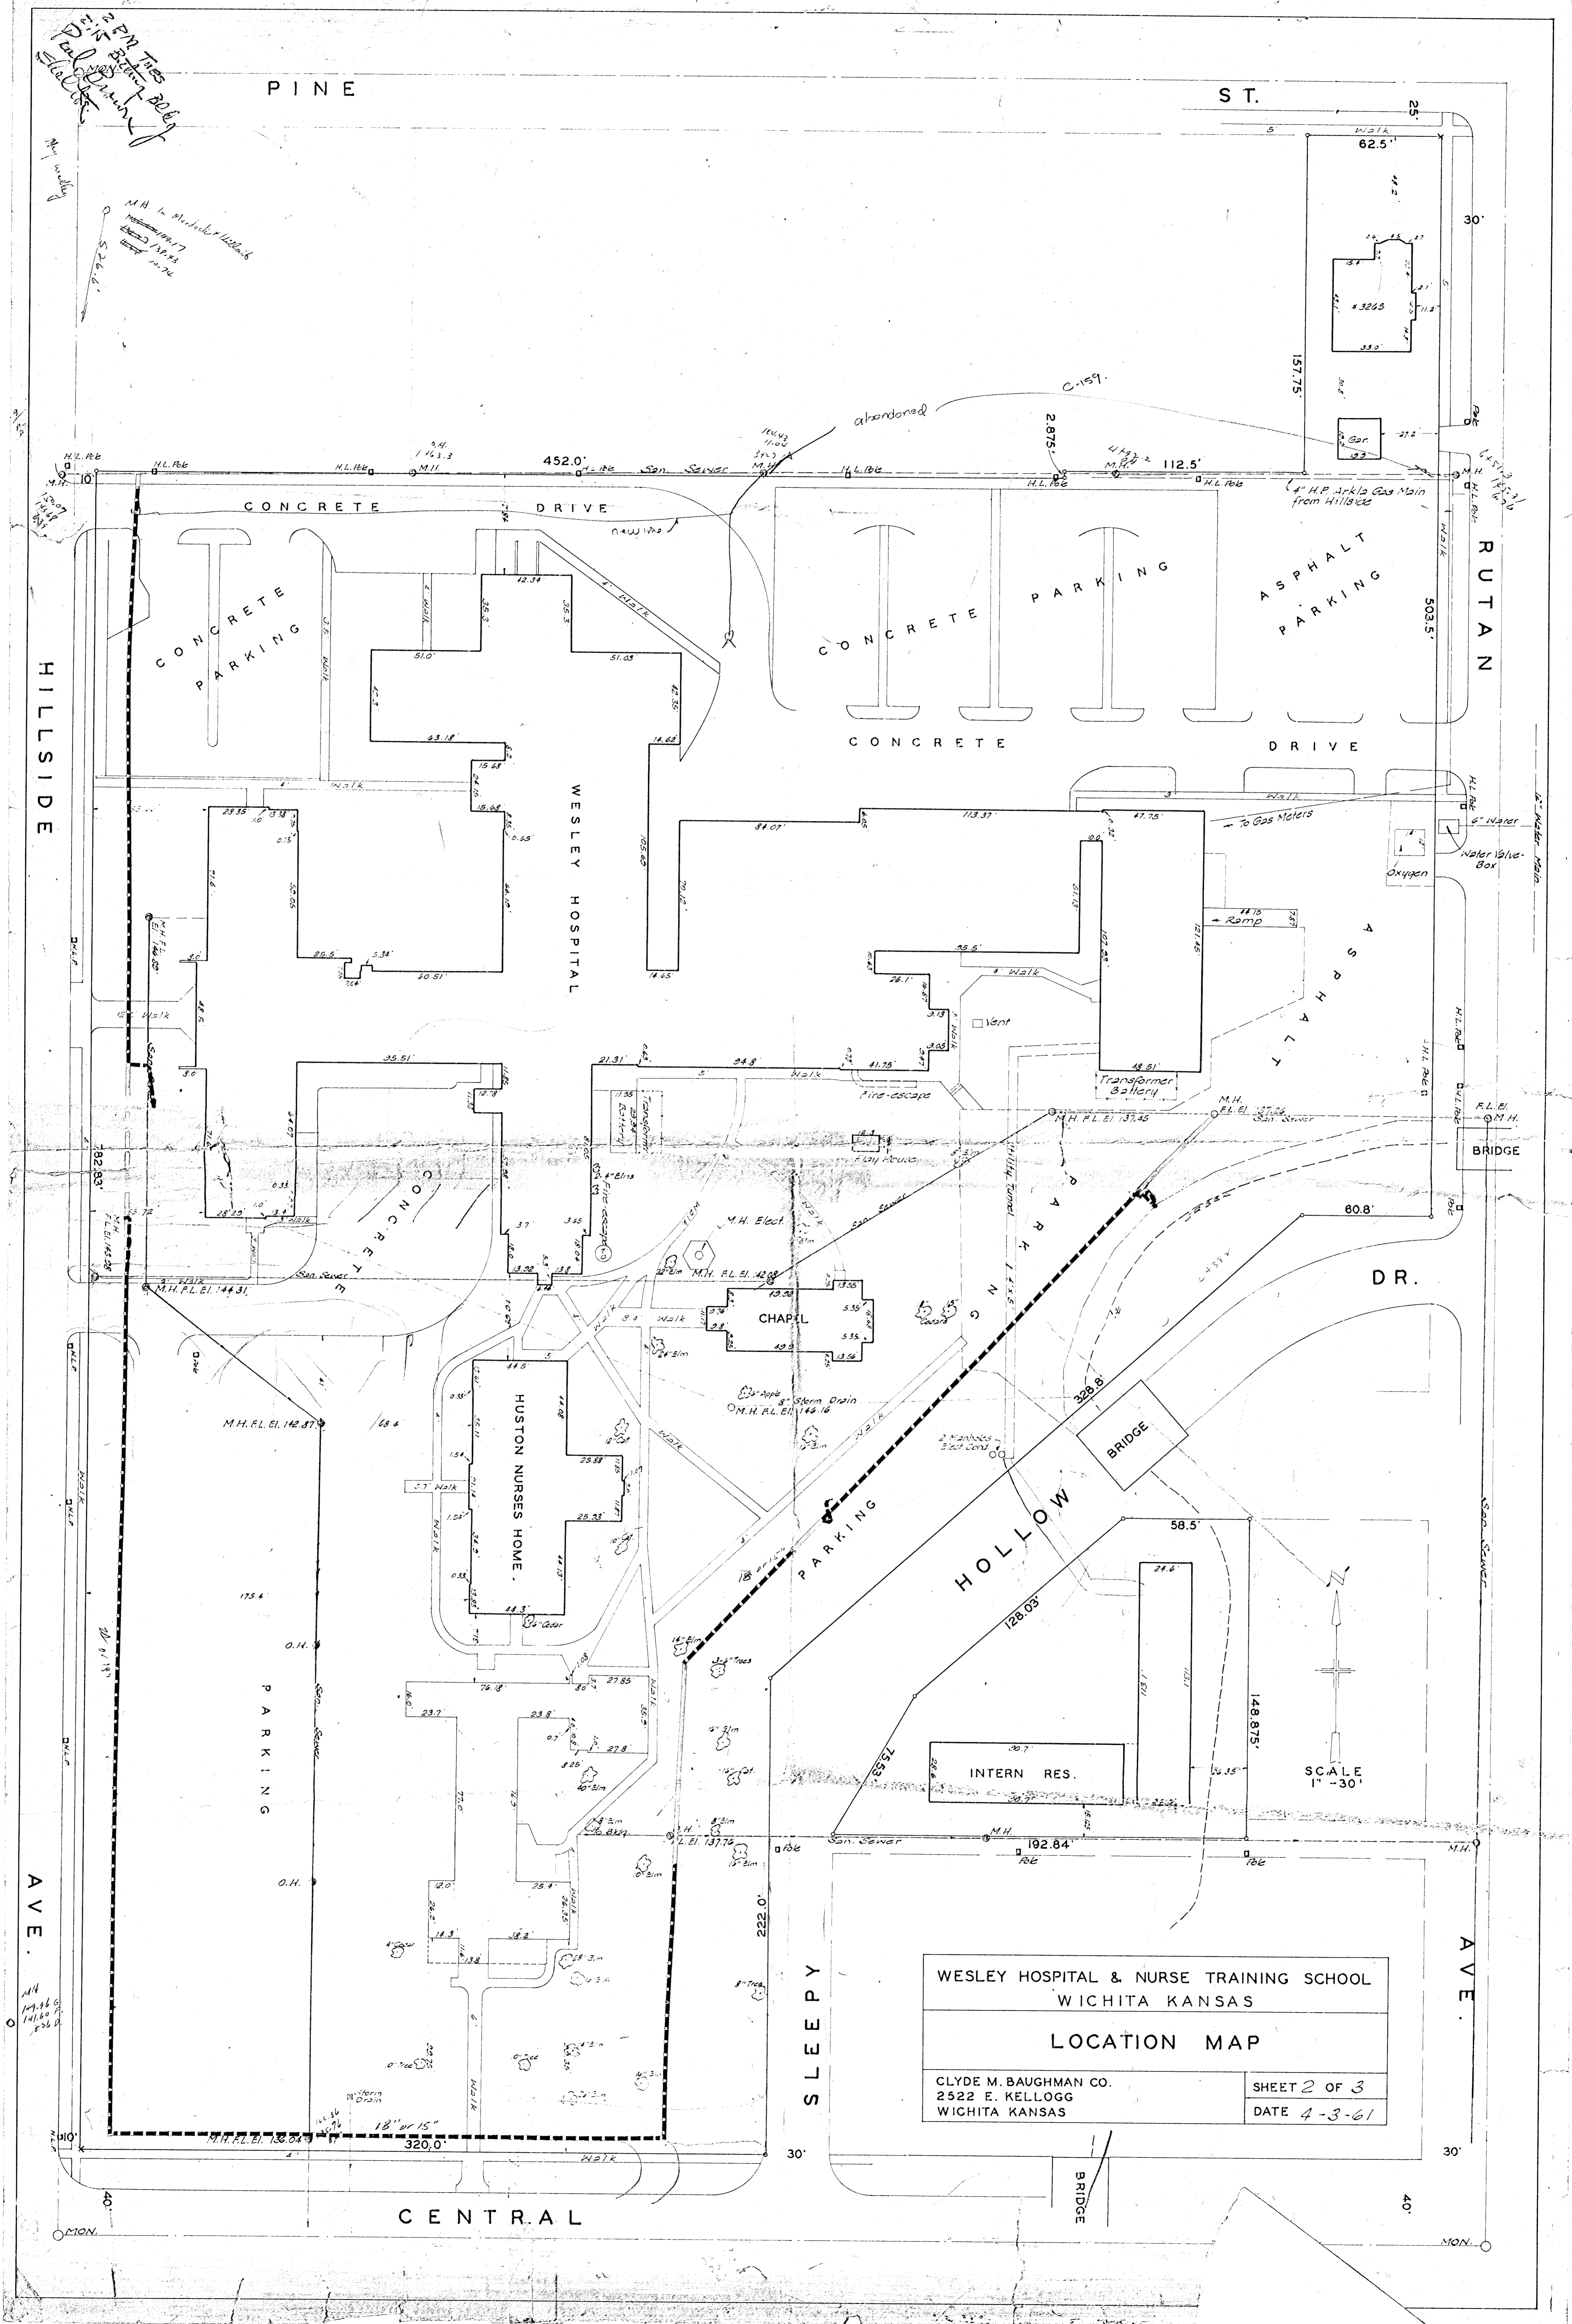

WESLEY HOSPITAL & NURSE TRAINING SCHOOL
WICHITA KANSAS

LOCATION MAP

CLYDE M. BAUGHMAN CO.
2522 E. KELLOGG
WICHITA KANSAS

SHEET 2 OF 3
DATE 4-3-61