


Off site drainage easement?  
 Detention Pond  
 P & F JANSEN ESTATES FARM INC.  
 ZONED R-1  
 N.E. COR. S.W. 1/4,  
 SEC. 4, T27S, R2E

HARRY B. BROWN JR. & DIANA KITCH  
 ZONED R-1

- LEGEND**
- Drainage Direction - Minor Storm
  - Drainage Direction - Major Storm
  - Proposed Storm Water Sewer & Inlet
  - Proposed Valley Gutter

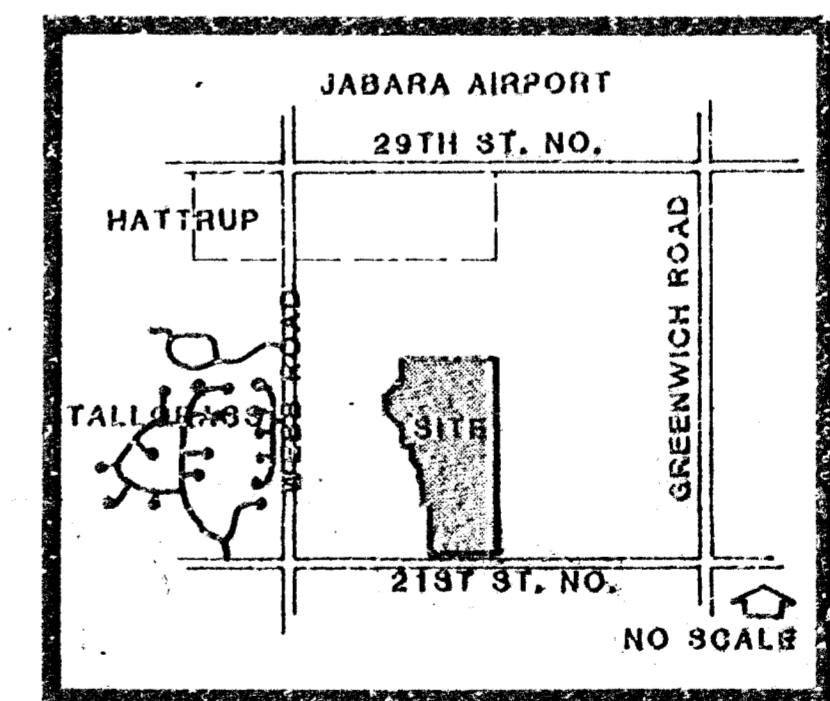

LOCATION MAP



SCALE: 1" = 100'

DRAINAGE CONCEPT 6-2-89

PROFESSIONAL ENGINEERING CONSULTANTS, P.A.  
 ENGINEERS  
 WICHITA, KANSAS

# TALLGRASS EAST 3RD ADD

RITCHIE'S DEVELOPMENT CORP., 8100 E. 22ND ST. NORTH, WICHITA, KS 67229