


TALLGRASS EAST
TO WICHITA, SEDGWICK COUNTY, KANSAS

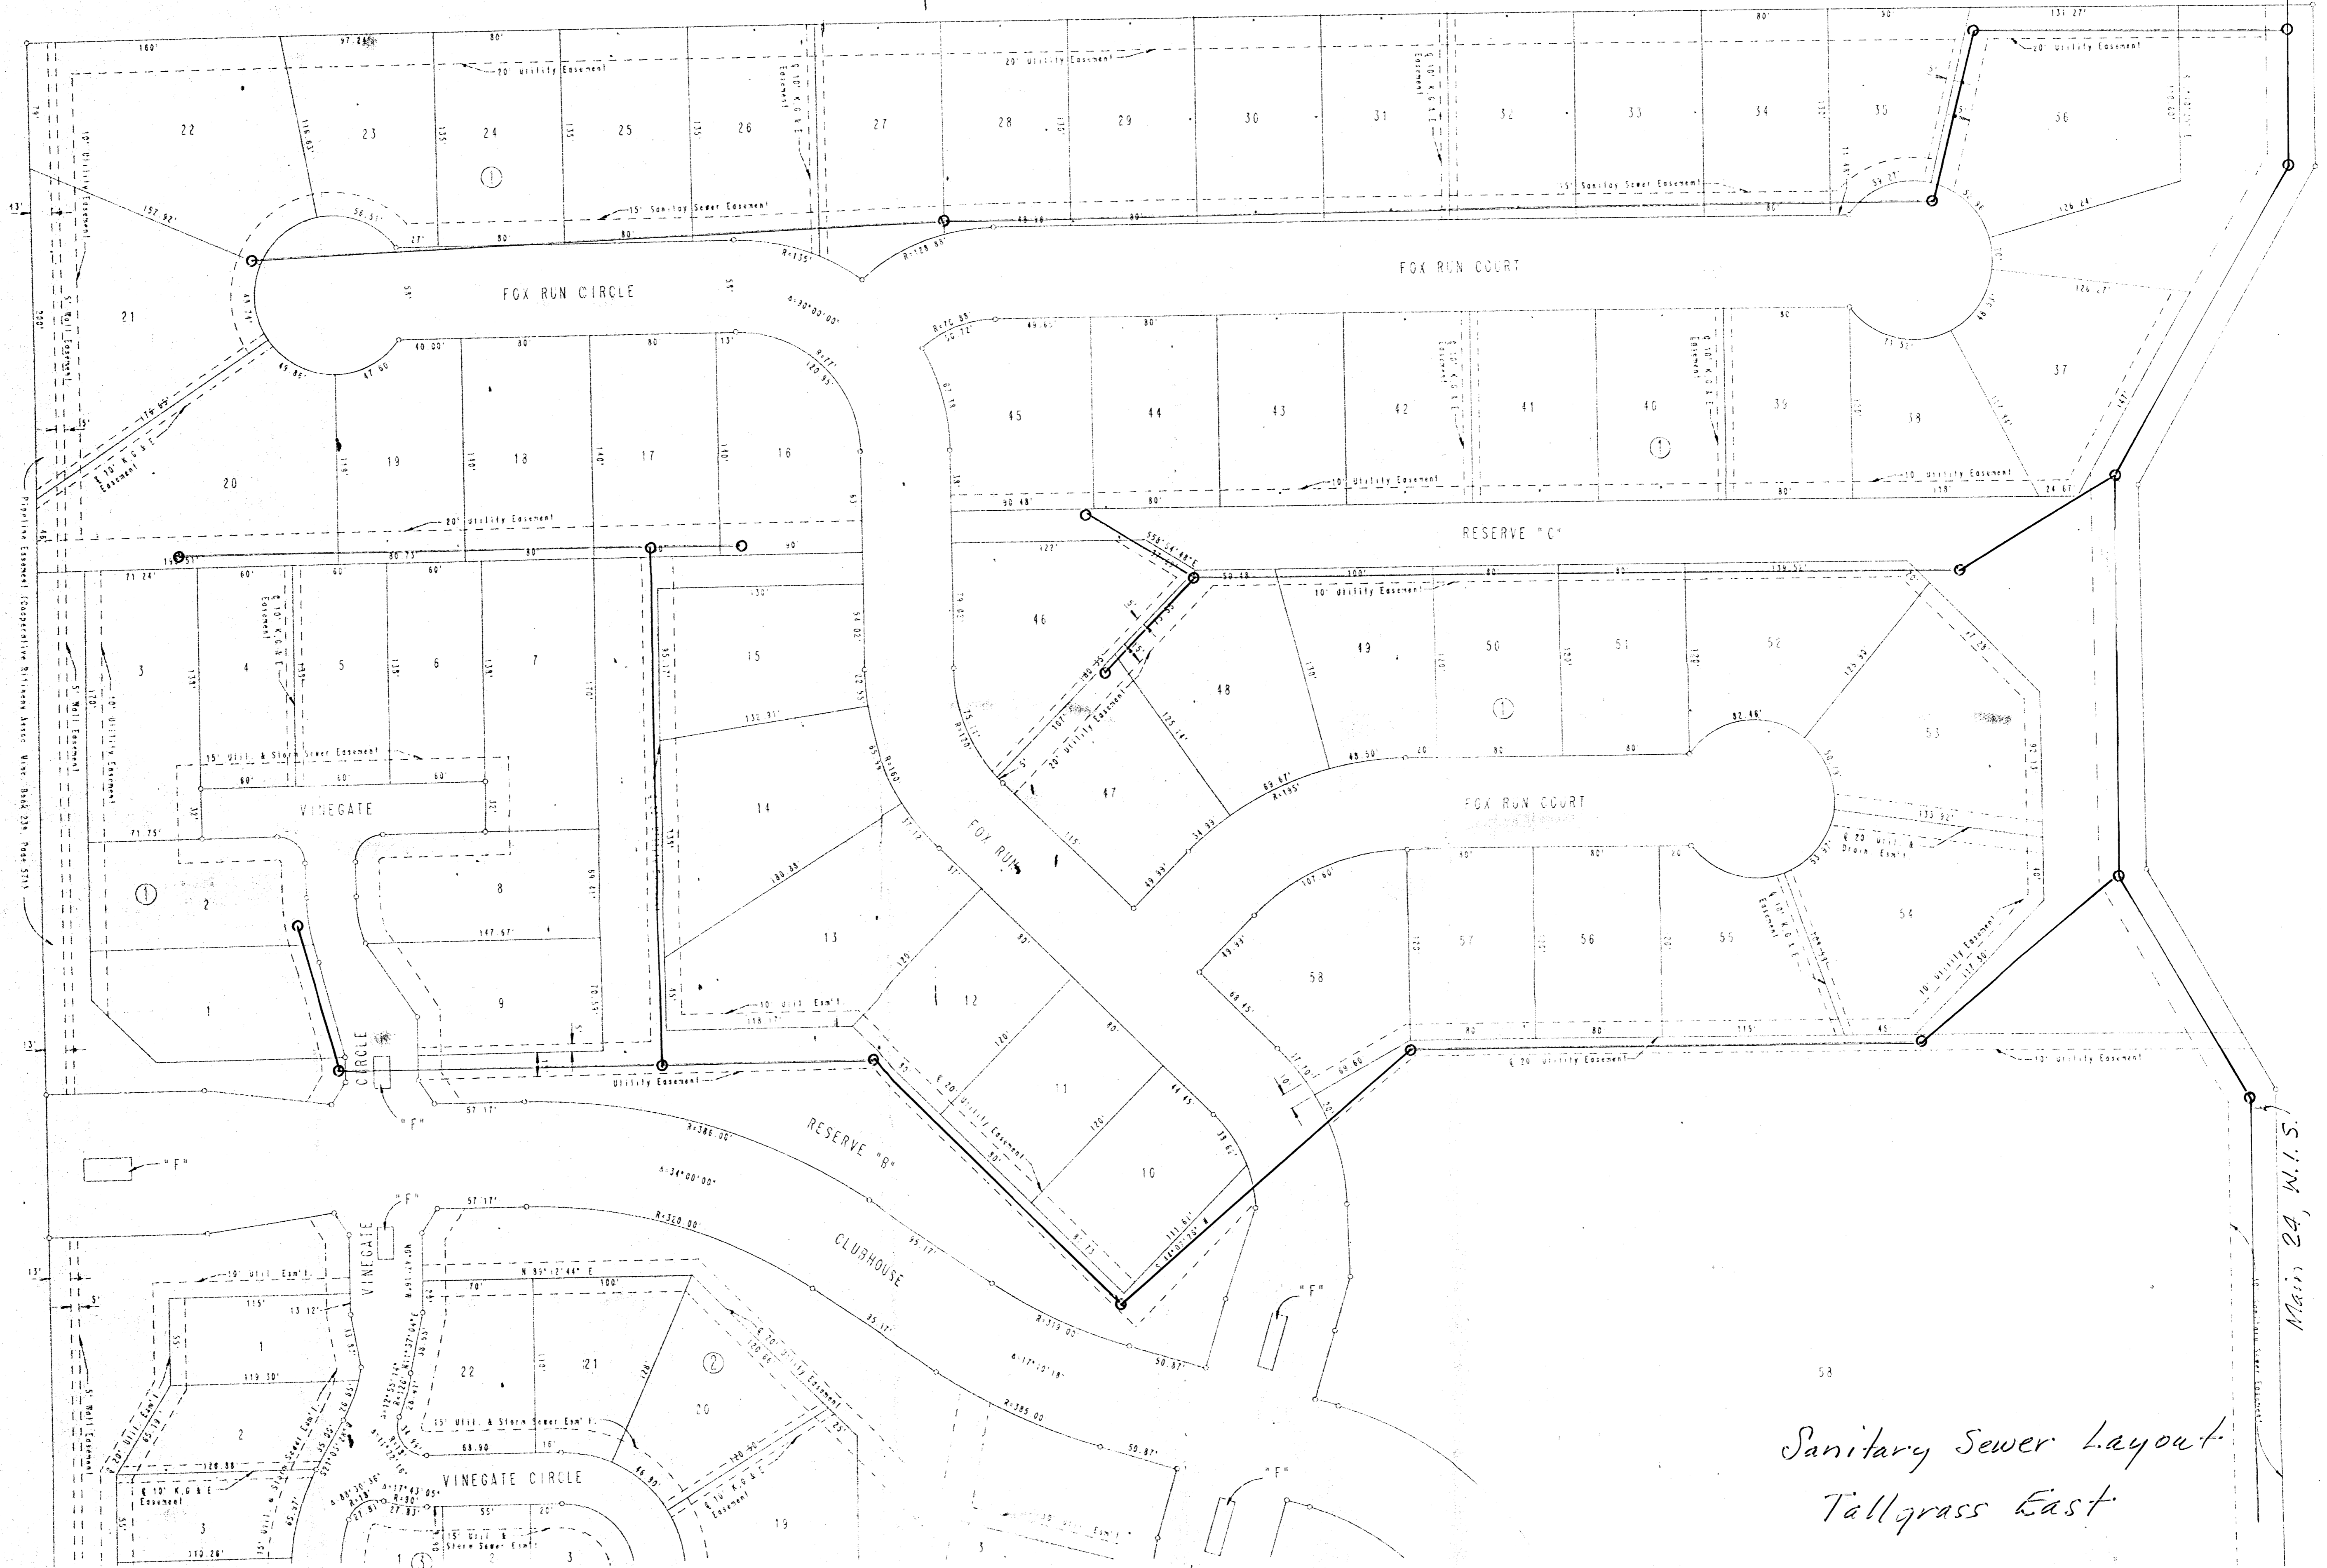

Sanitary Sewer Layout
Tallgrass East

Main 24, W.I.S.