


Note: All meters will be used.
 Additional meter will be required for lots 3 & 7, BIK. 1
 and Lots 3, 6, 10, & 13 BIK. 2.

EXISTING WATER METER LOCATIONS
CRESTVIEW COUNTRY CLUB ESTATES
SOUTHCREST SECOND ADDITION

TO
 SEDGWICK COUNTY, KANSAS

1985

REISS AND GOODNESS ENGINEERS
 2160 W 21st ST. WICHITA, KANSAS 67205

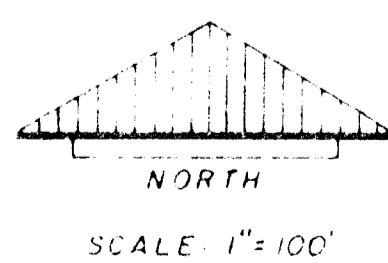

LEGEND

• 3/4" ROD OR
 5/8" REBAR

▲ DIRECTION OF SERVICE

—●— EXIST. METER BOX

★ LOT REQUIRING ADDITIONAL SERVICE

554 ADDRESS