
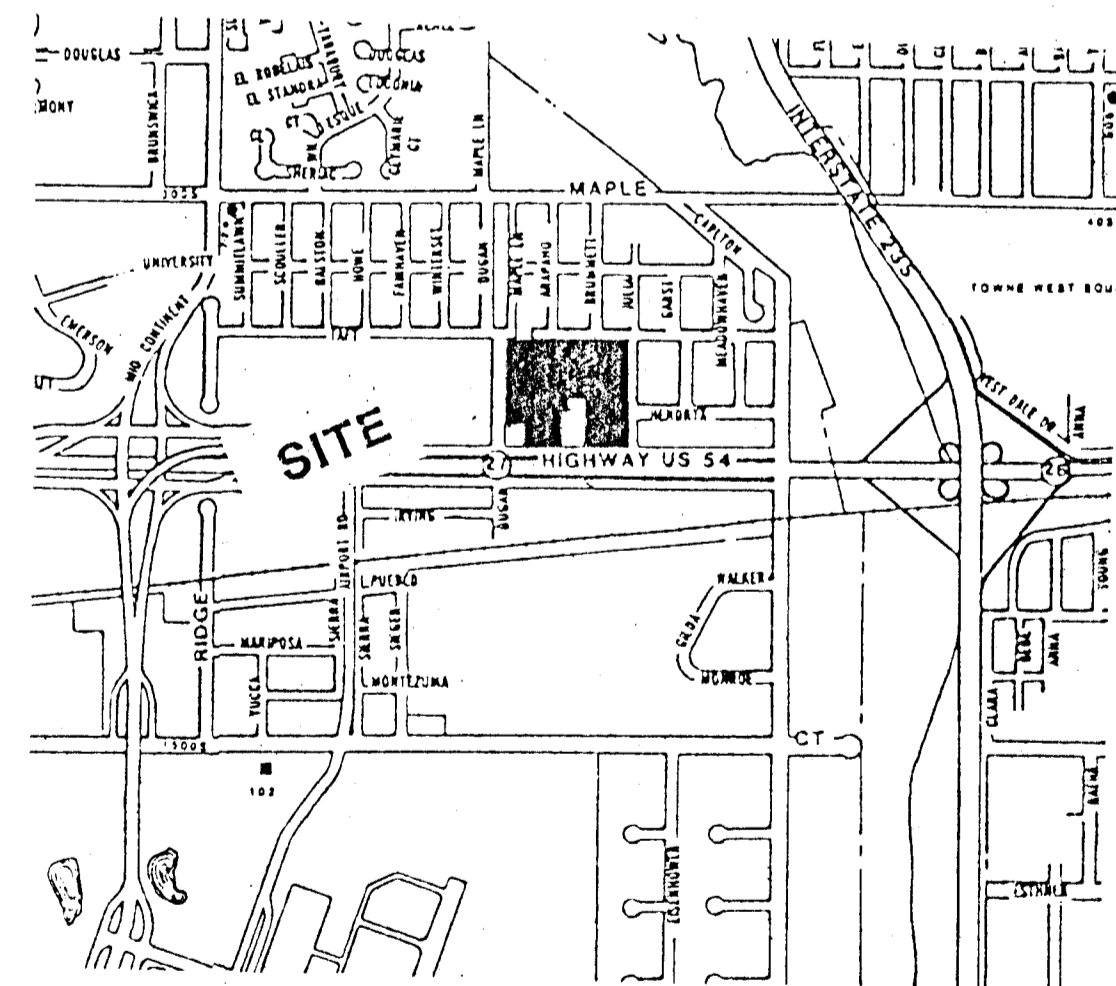


PRELIMINARY PLAT


THE LANDING 2ND ADDITION

PART PART OF LOT 1, AIR PARK SECOND
ADDITION AND LOT 1, THE LANDING

ROYAL ASSOCIATES & WAL-MART PROPERTIES, INC

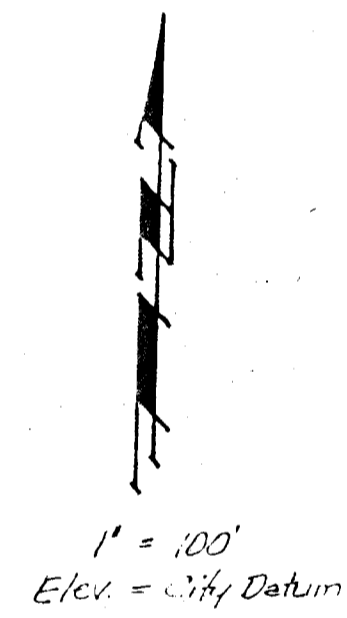

VICINITY PLAT

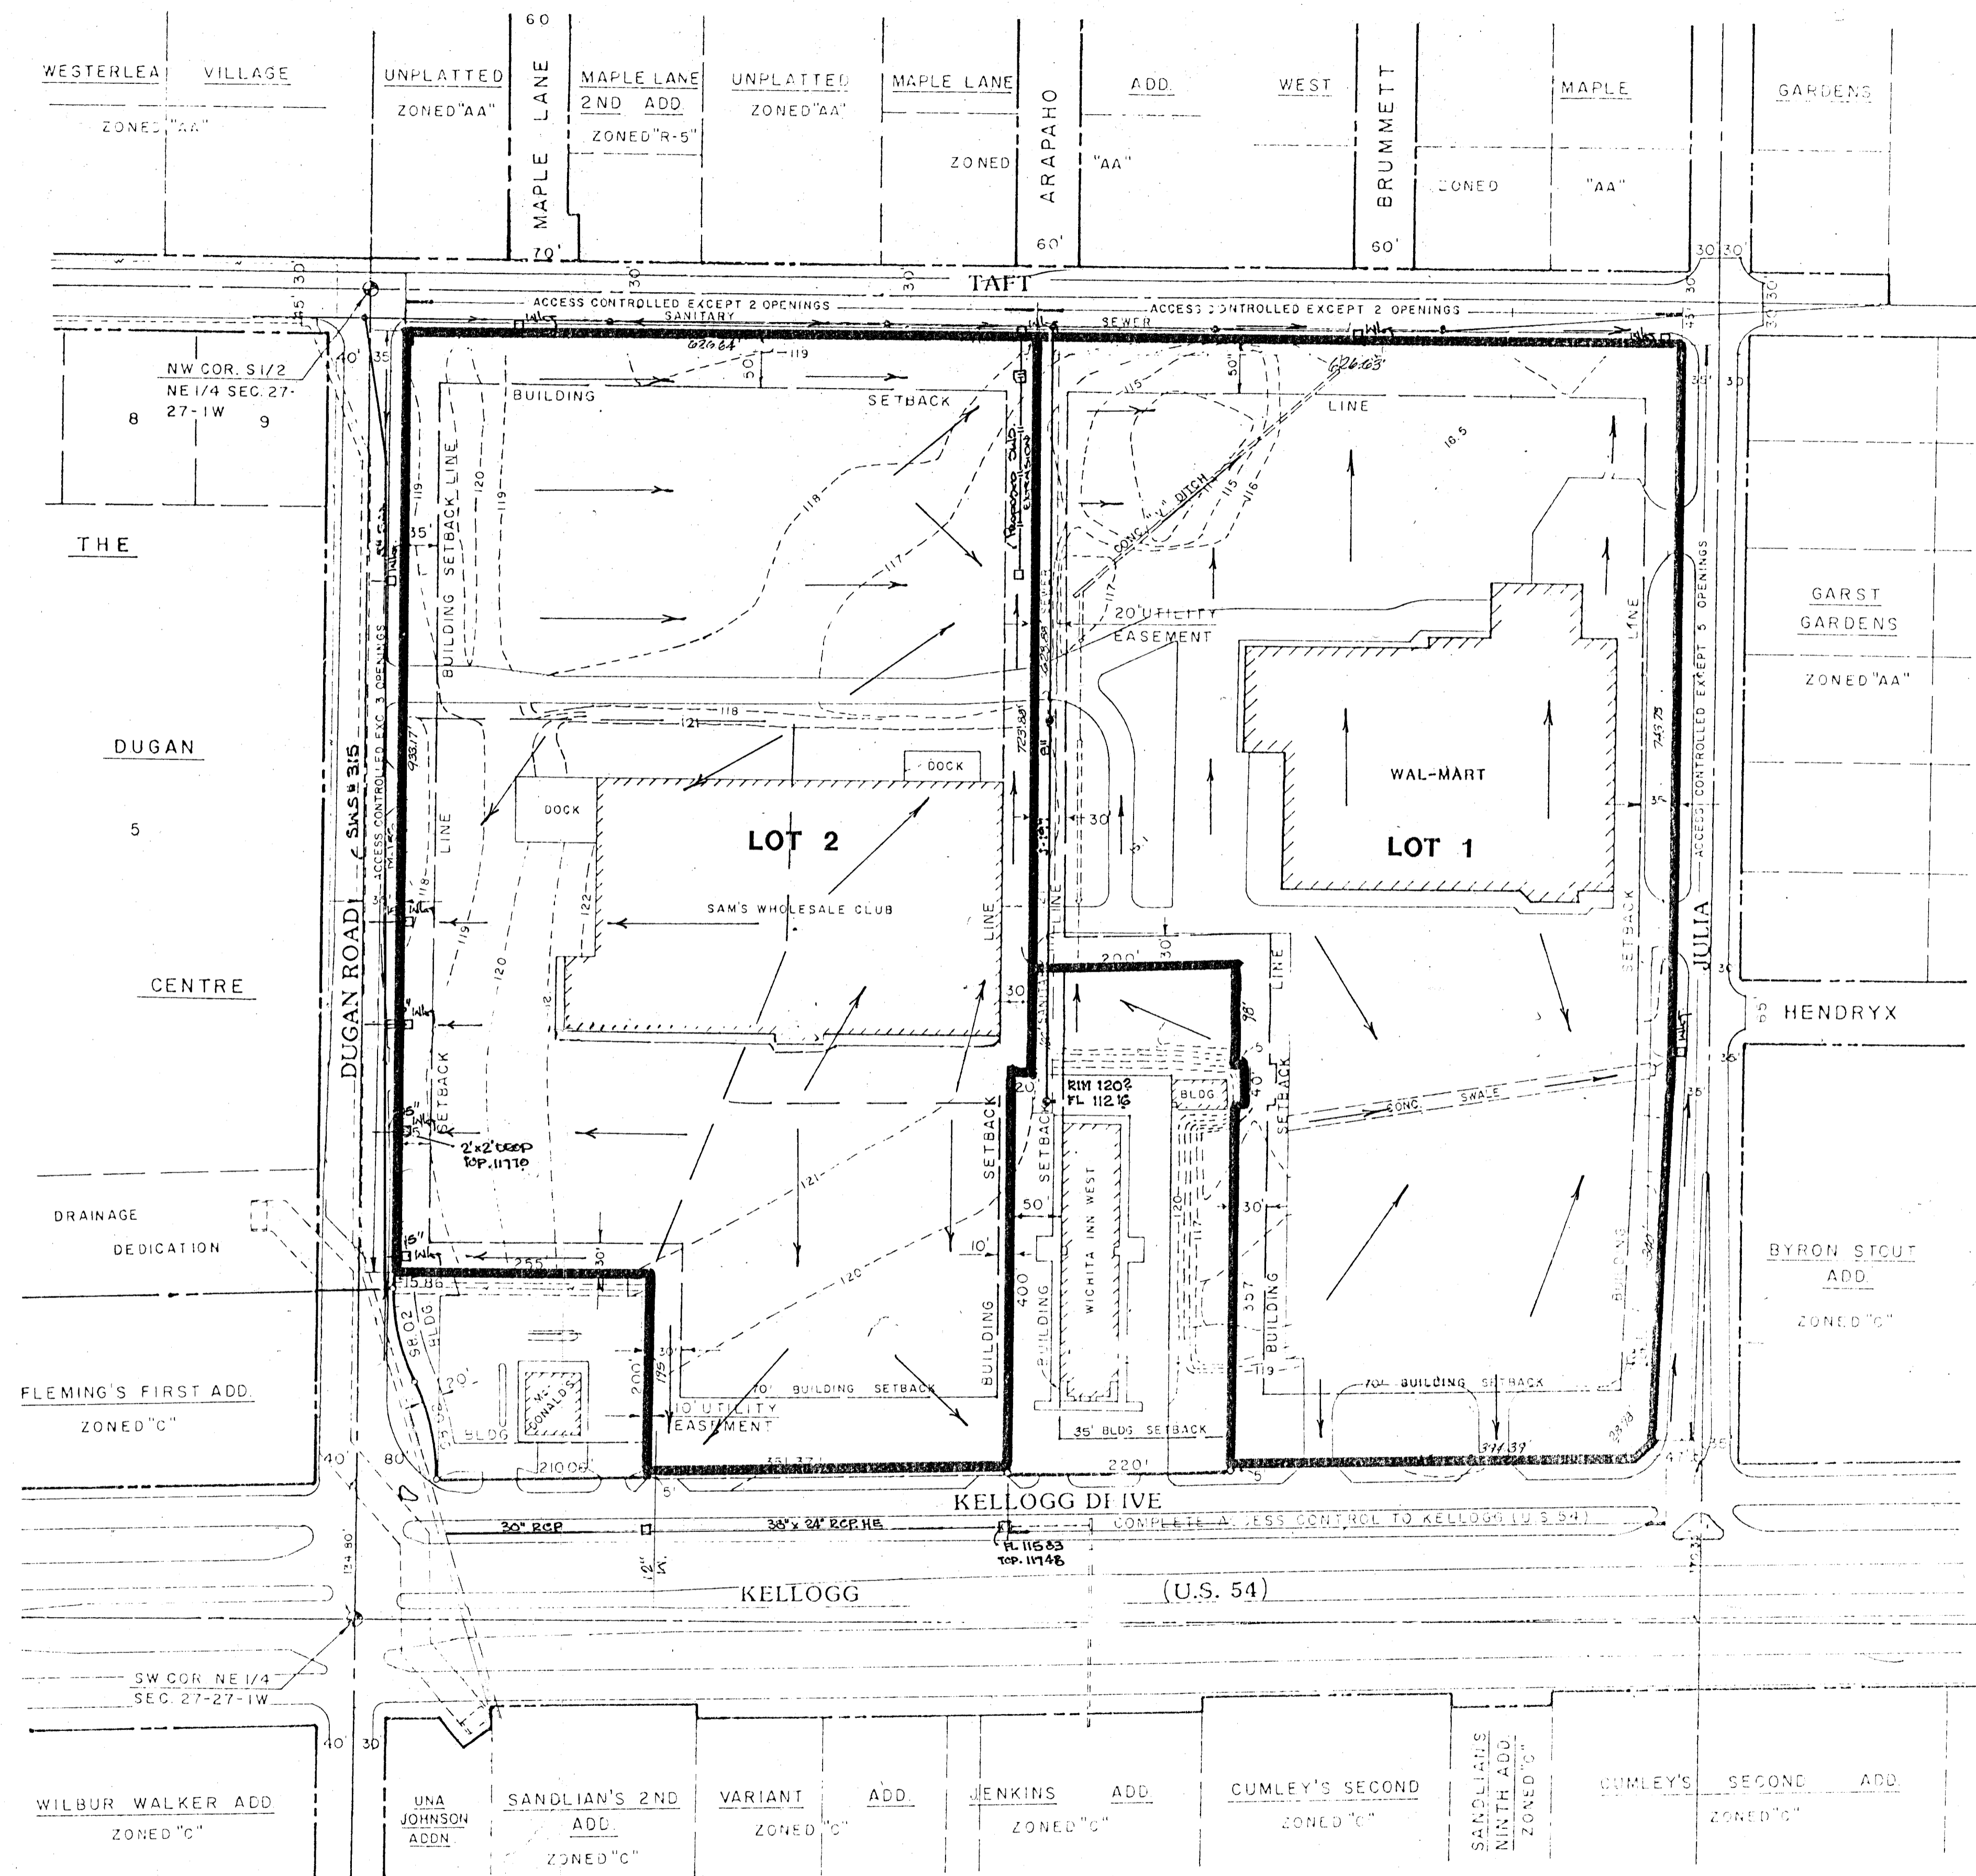

DRAINAGE CONCEPT

BAUGHMAN COMPANY, P.A.
SURVEYING & ENGINEERING
316-282-7271 • 315 ELLIS • WICHITA, KANSAS 67211

22 MARCH 1970