


HORSESHOE BAY

AN ADDITION TO WICHITA, SEDGWICK COUNTY, KANSAS

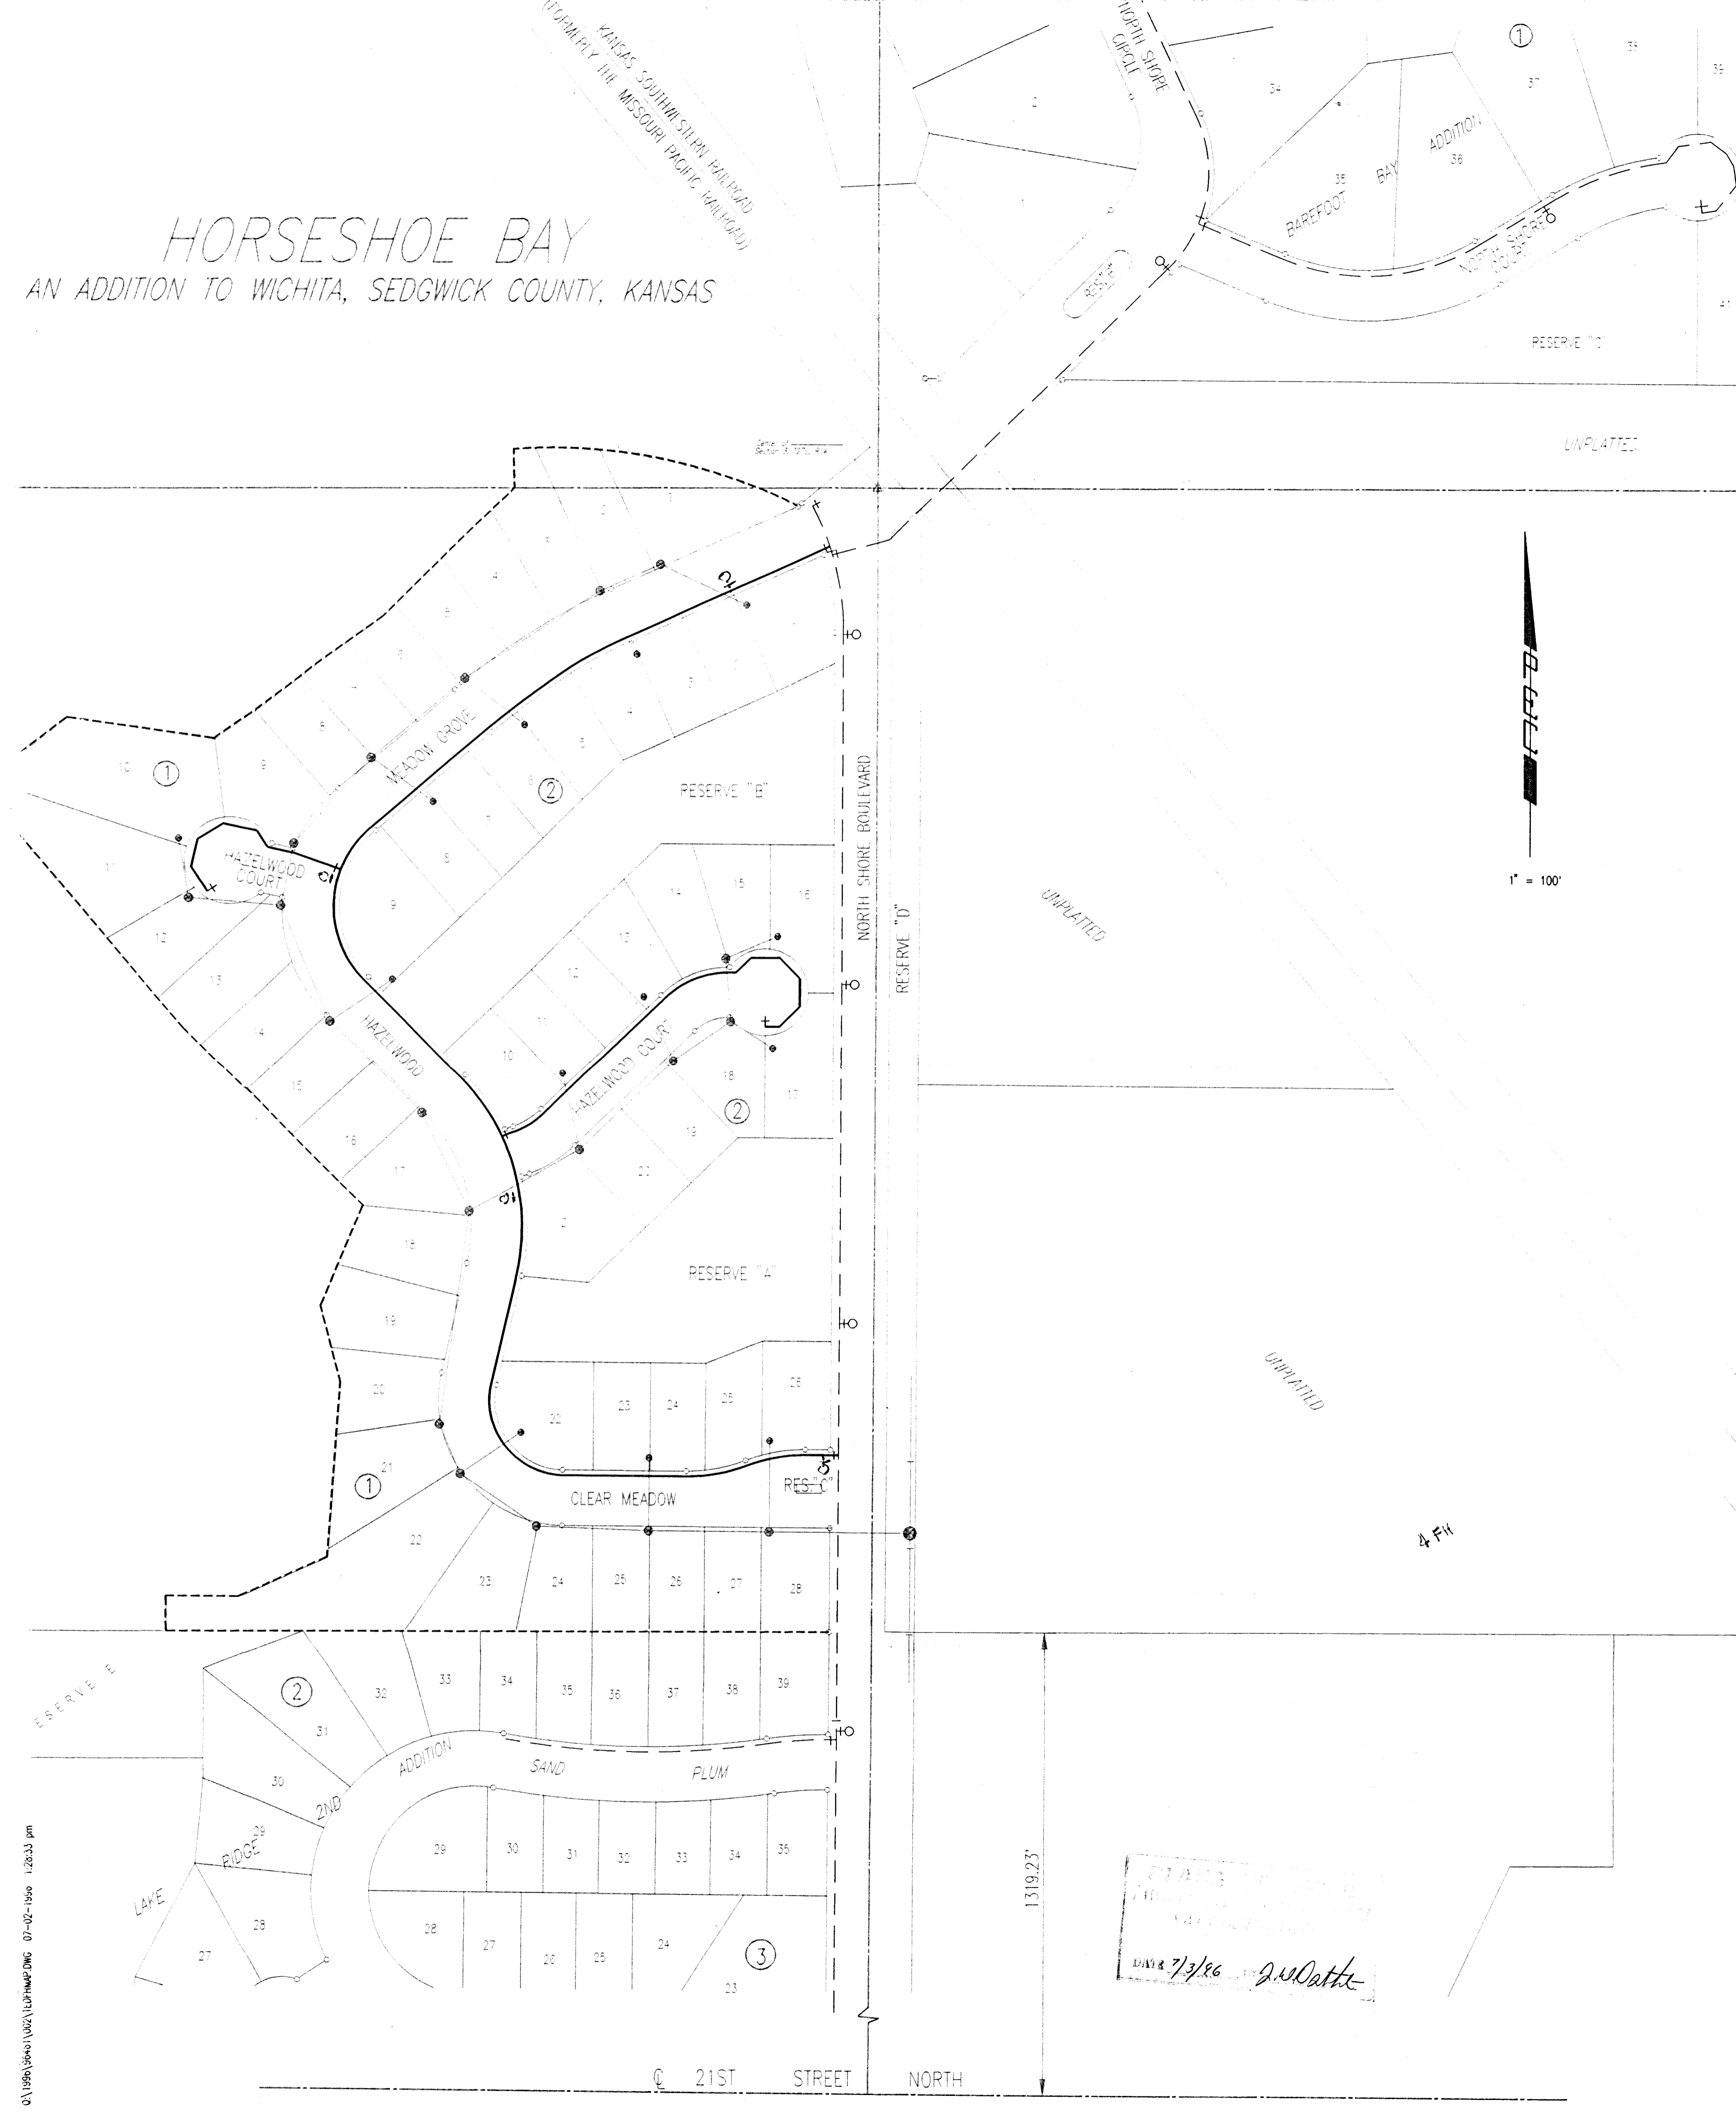

C:\1990\Gens\1002\1002\HWP.DWG 07-02-1990 1:28:33 pm

DATE 7/3/86
 D. W. Datta