M-156
M-153
D-140 CARLOS OKEBUL

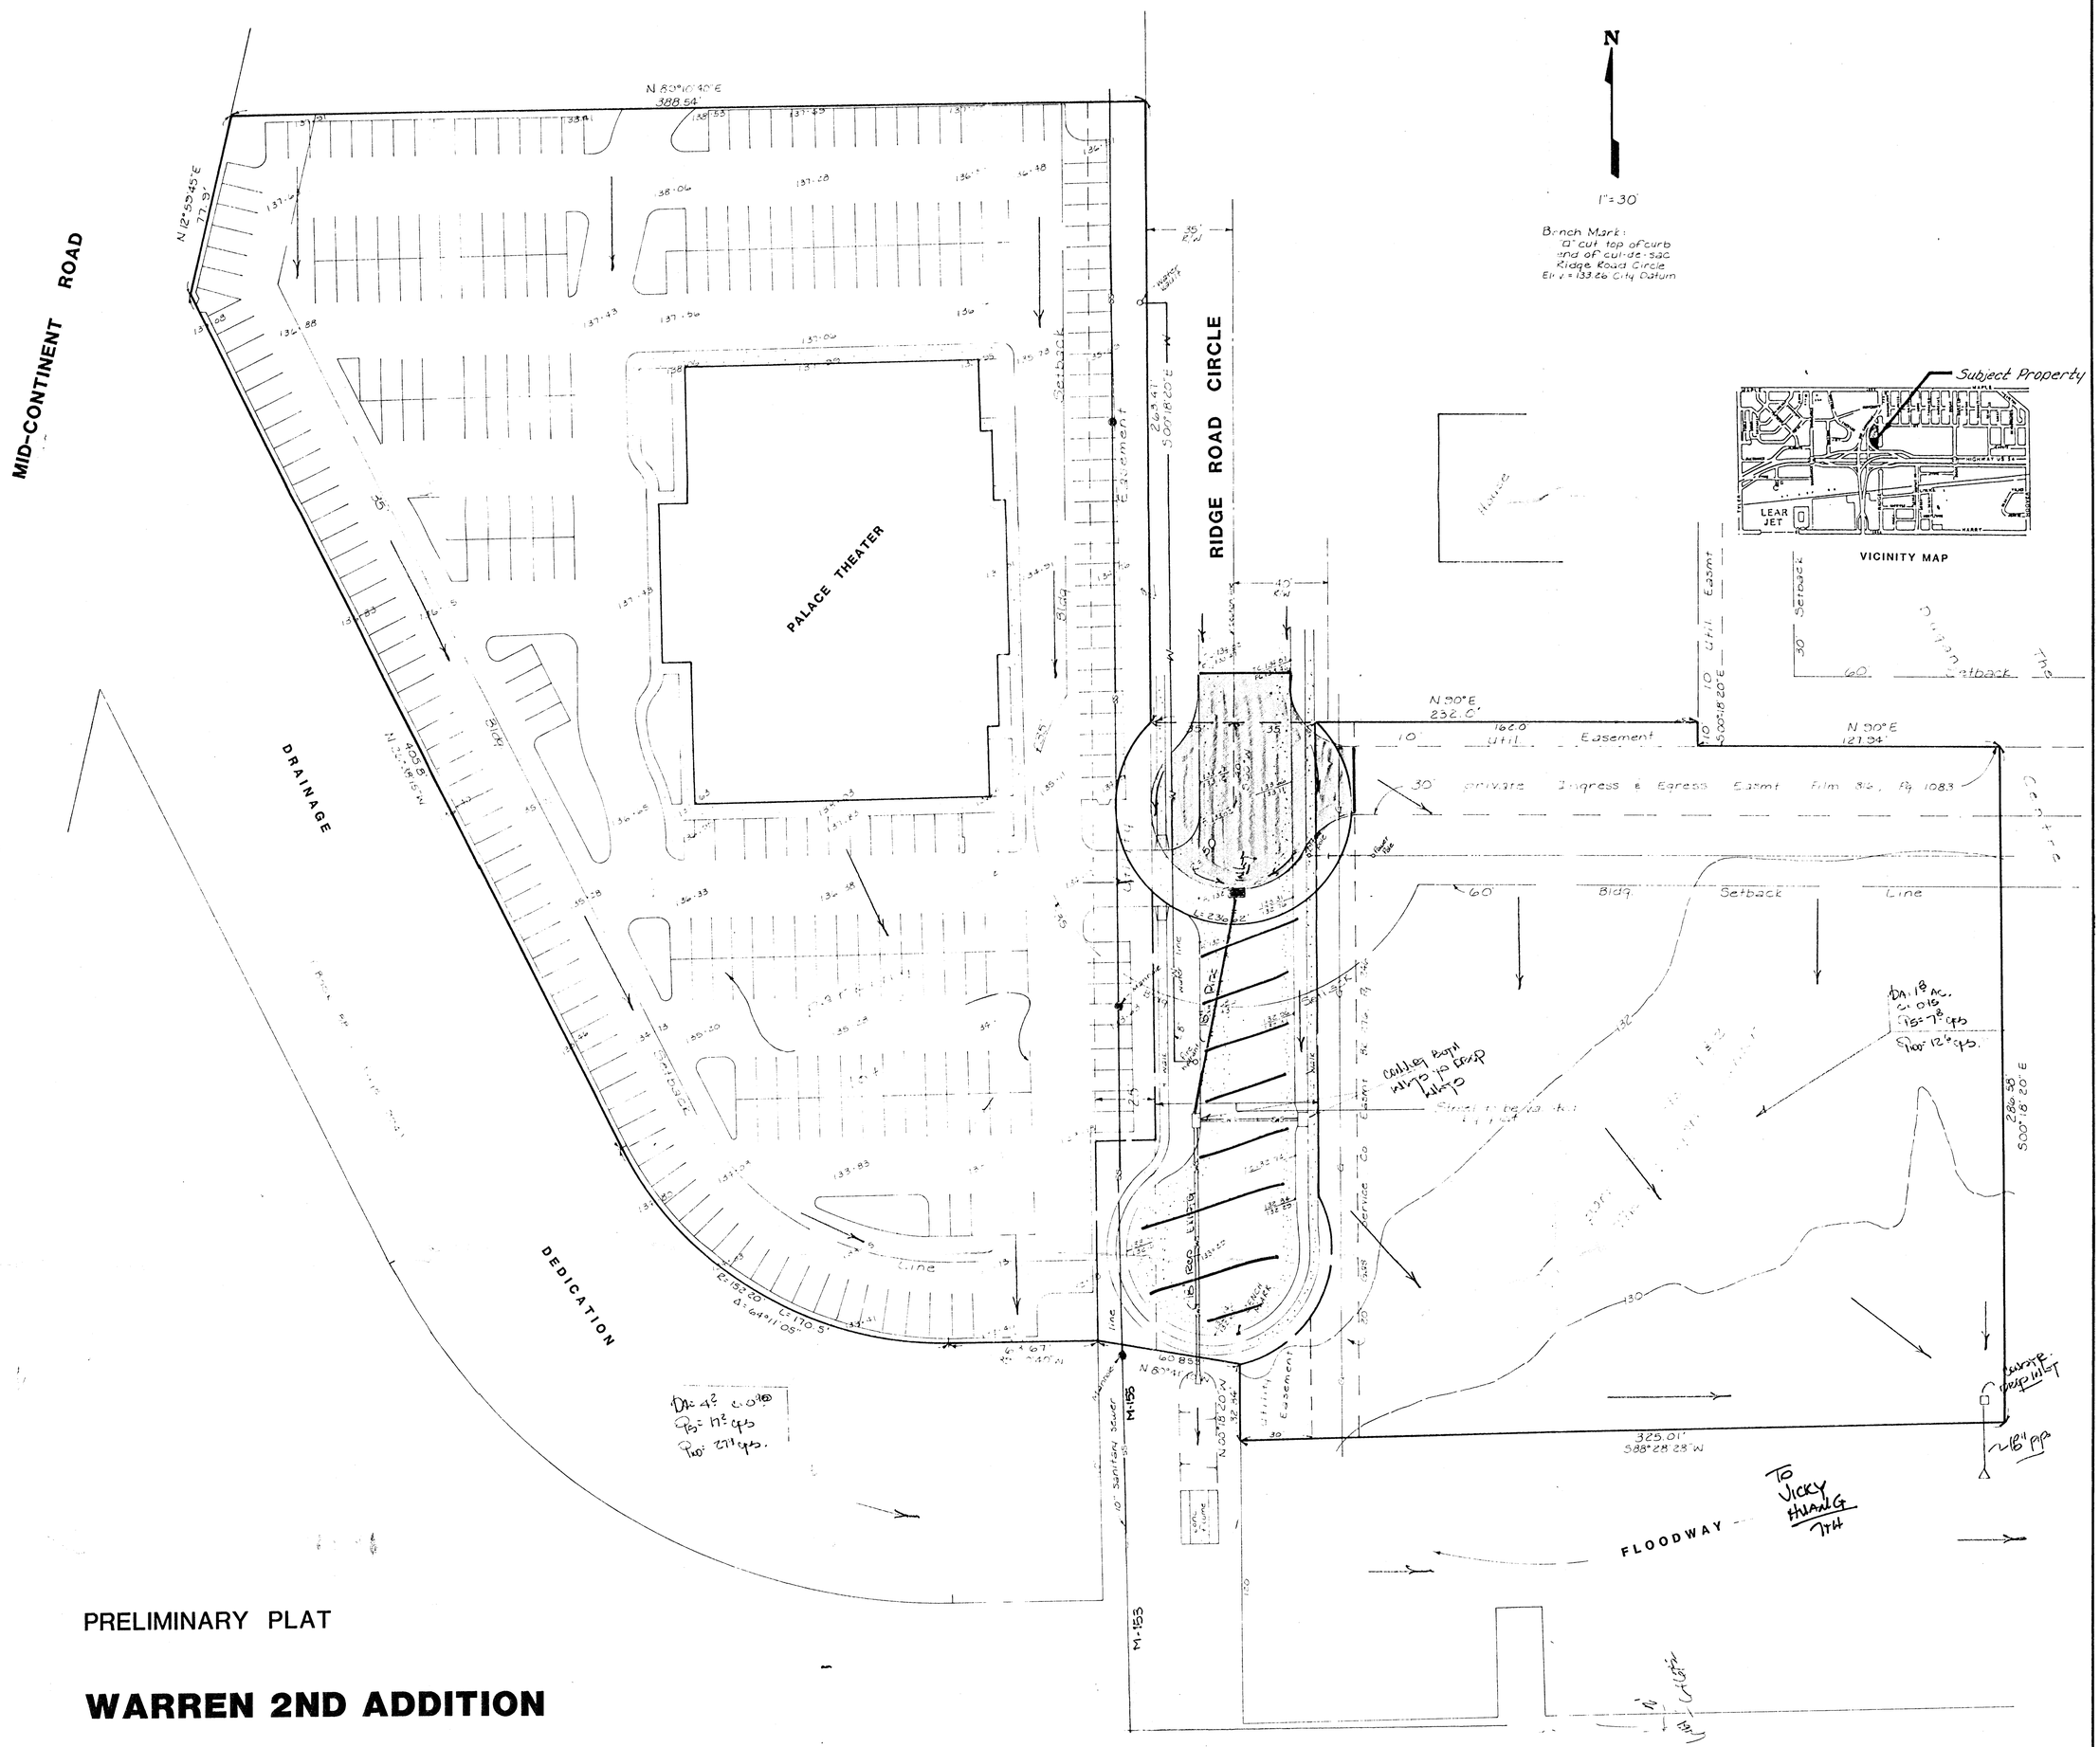

PRELIMINARY PLAT

WARREN 2ND ADDITION

A REPLAT OF LOTS 3 AND 4, RIDGE PLAZA 10TH ADDITION, WICHITA, KANSAS

AND PART OF LOTS 1 AND 2, THE DUGAN CENTRE

OWNER: CINEMA ASSOCIATES

KELLOGG US 54

DRAINAGE CONCEPT

BAUGHMAN COMPANY, P.A.
SURVEYING & ENGINEERING
316-262-7271 • 315 ELLIS • WICHITA, KANSAS 67211

Jan 12, 1990