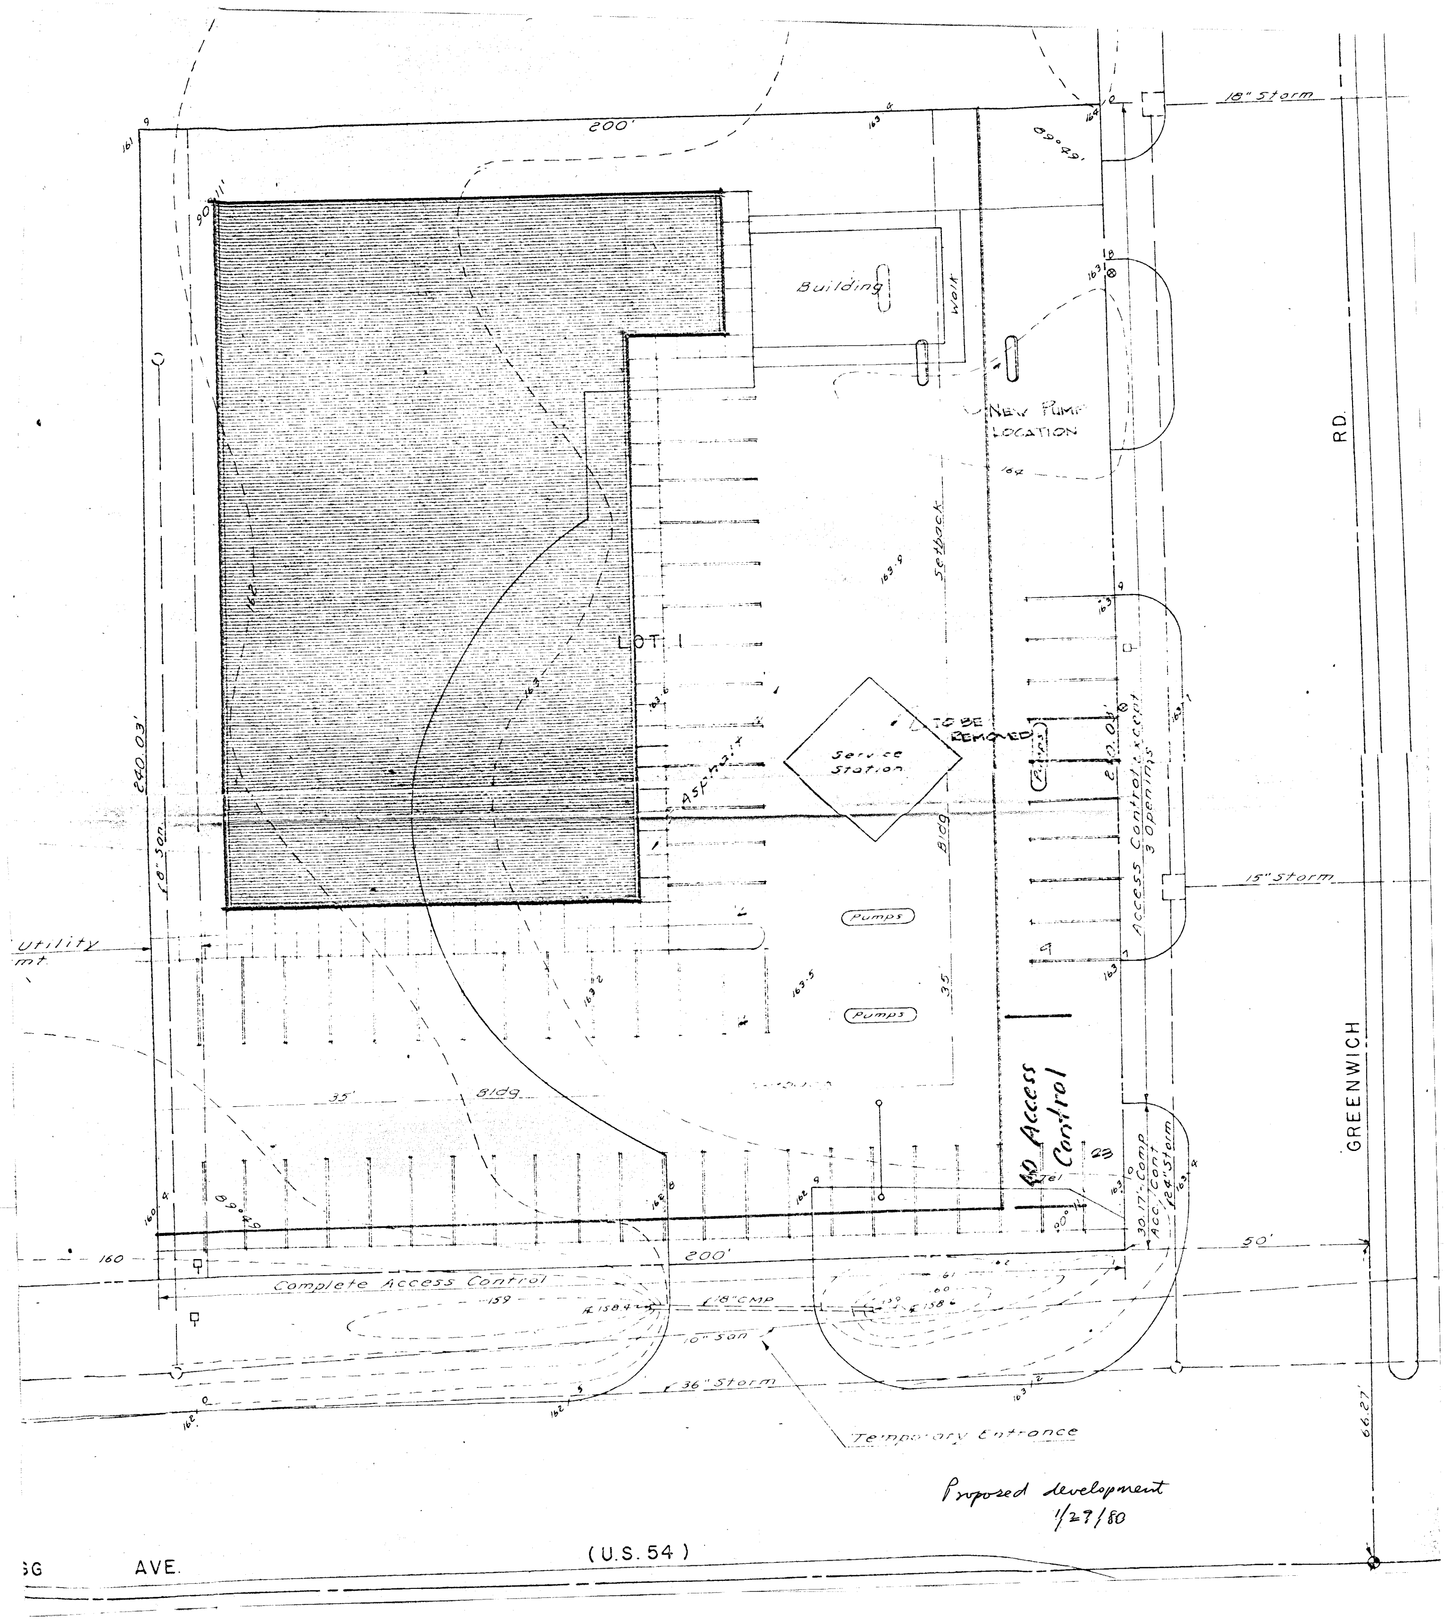
200'
18" Storm
Building
Walk
New Pump Location
Setback
LOT 1
To be Removed
Service Station
Asphalt
Bldg
Pumps
Pumps
35'
Bldg
35'
Utility mt
240.03'
18" San
Access Control Except 3 Openings
15" Storm
RD.
GREENWICH
No Access Control
30.17' Comp Acc. Cont. Except Storm
50'
160
200'
Complete Access Control
18" CMP
18" San
36" Storm
Temporary Entrance
66.27'
Proposed development
1/27/80
(U.S. 54)
AVE.