

LOT 14  
WALNUT GROVE


LOT 15  
WALNUT GROVE

LOT 16  
WALNUT GROVE



LOT 17  
WALNUT GROVE

LOT 18  
WALNUT GROVE

LOT 21  
WALNUT GROVE

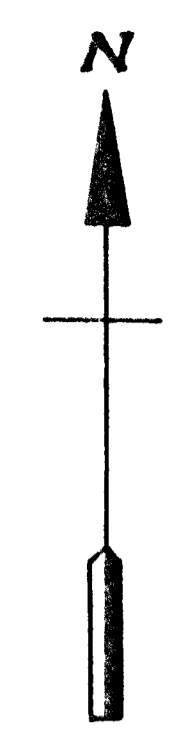

SCALE: 1" = 50'  
ELEV. = CITY DATUM

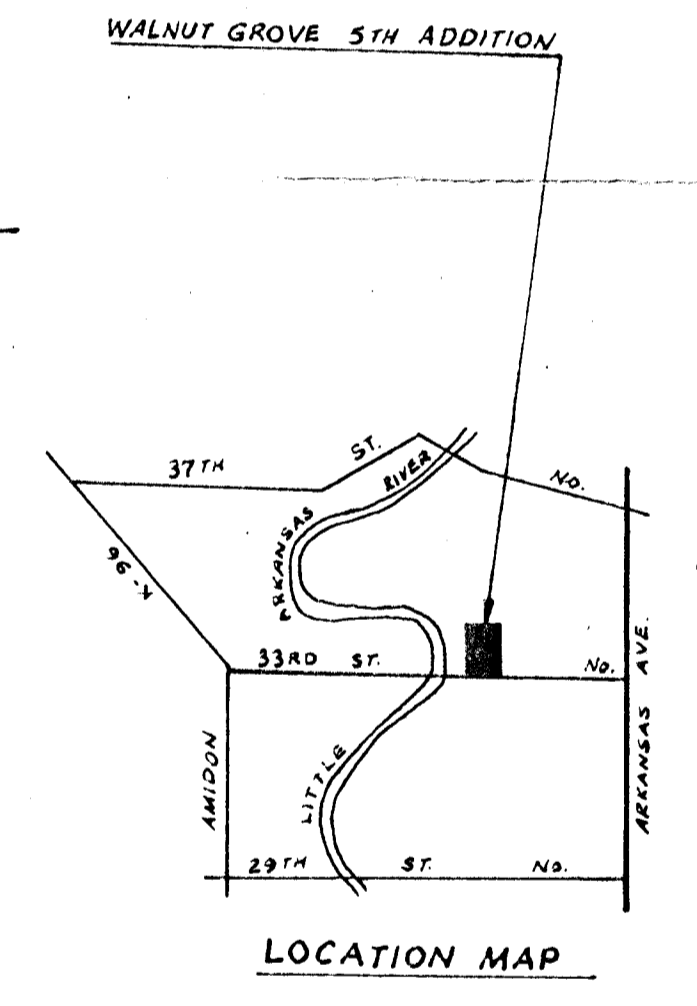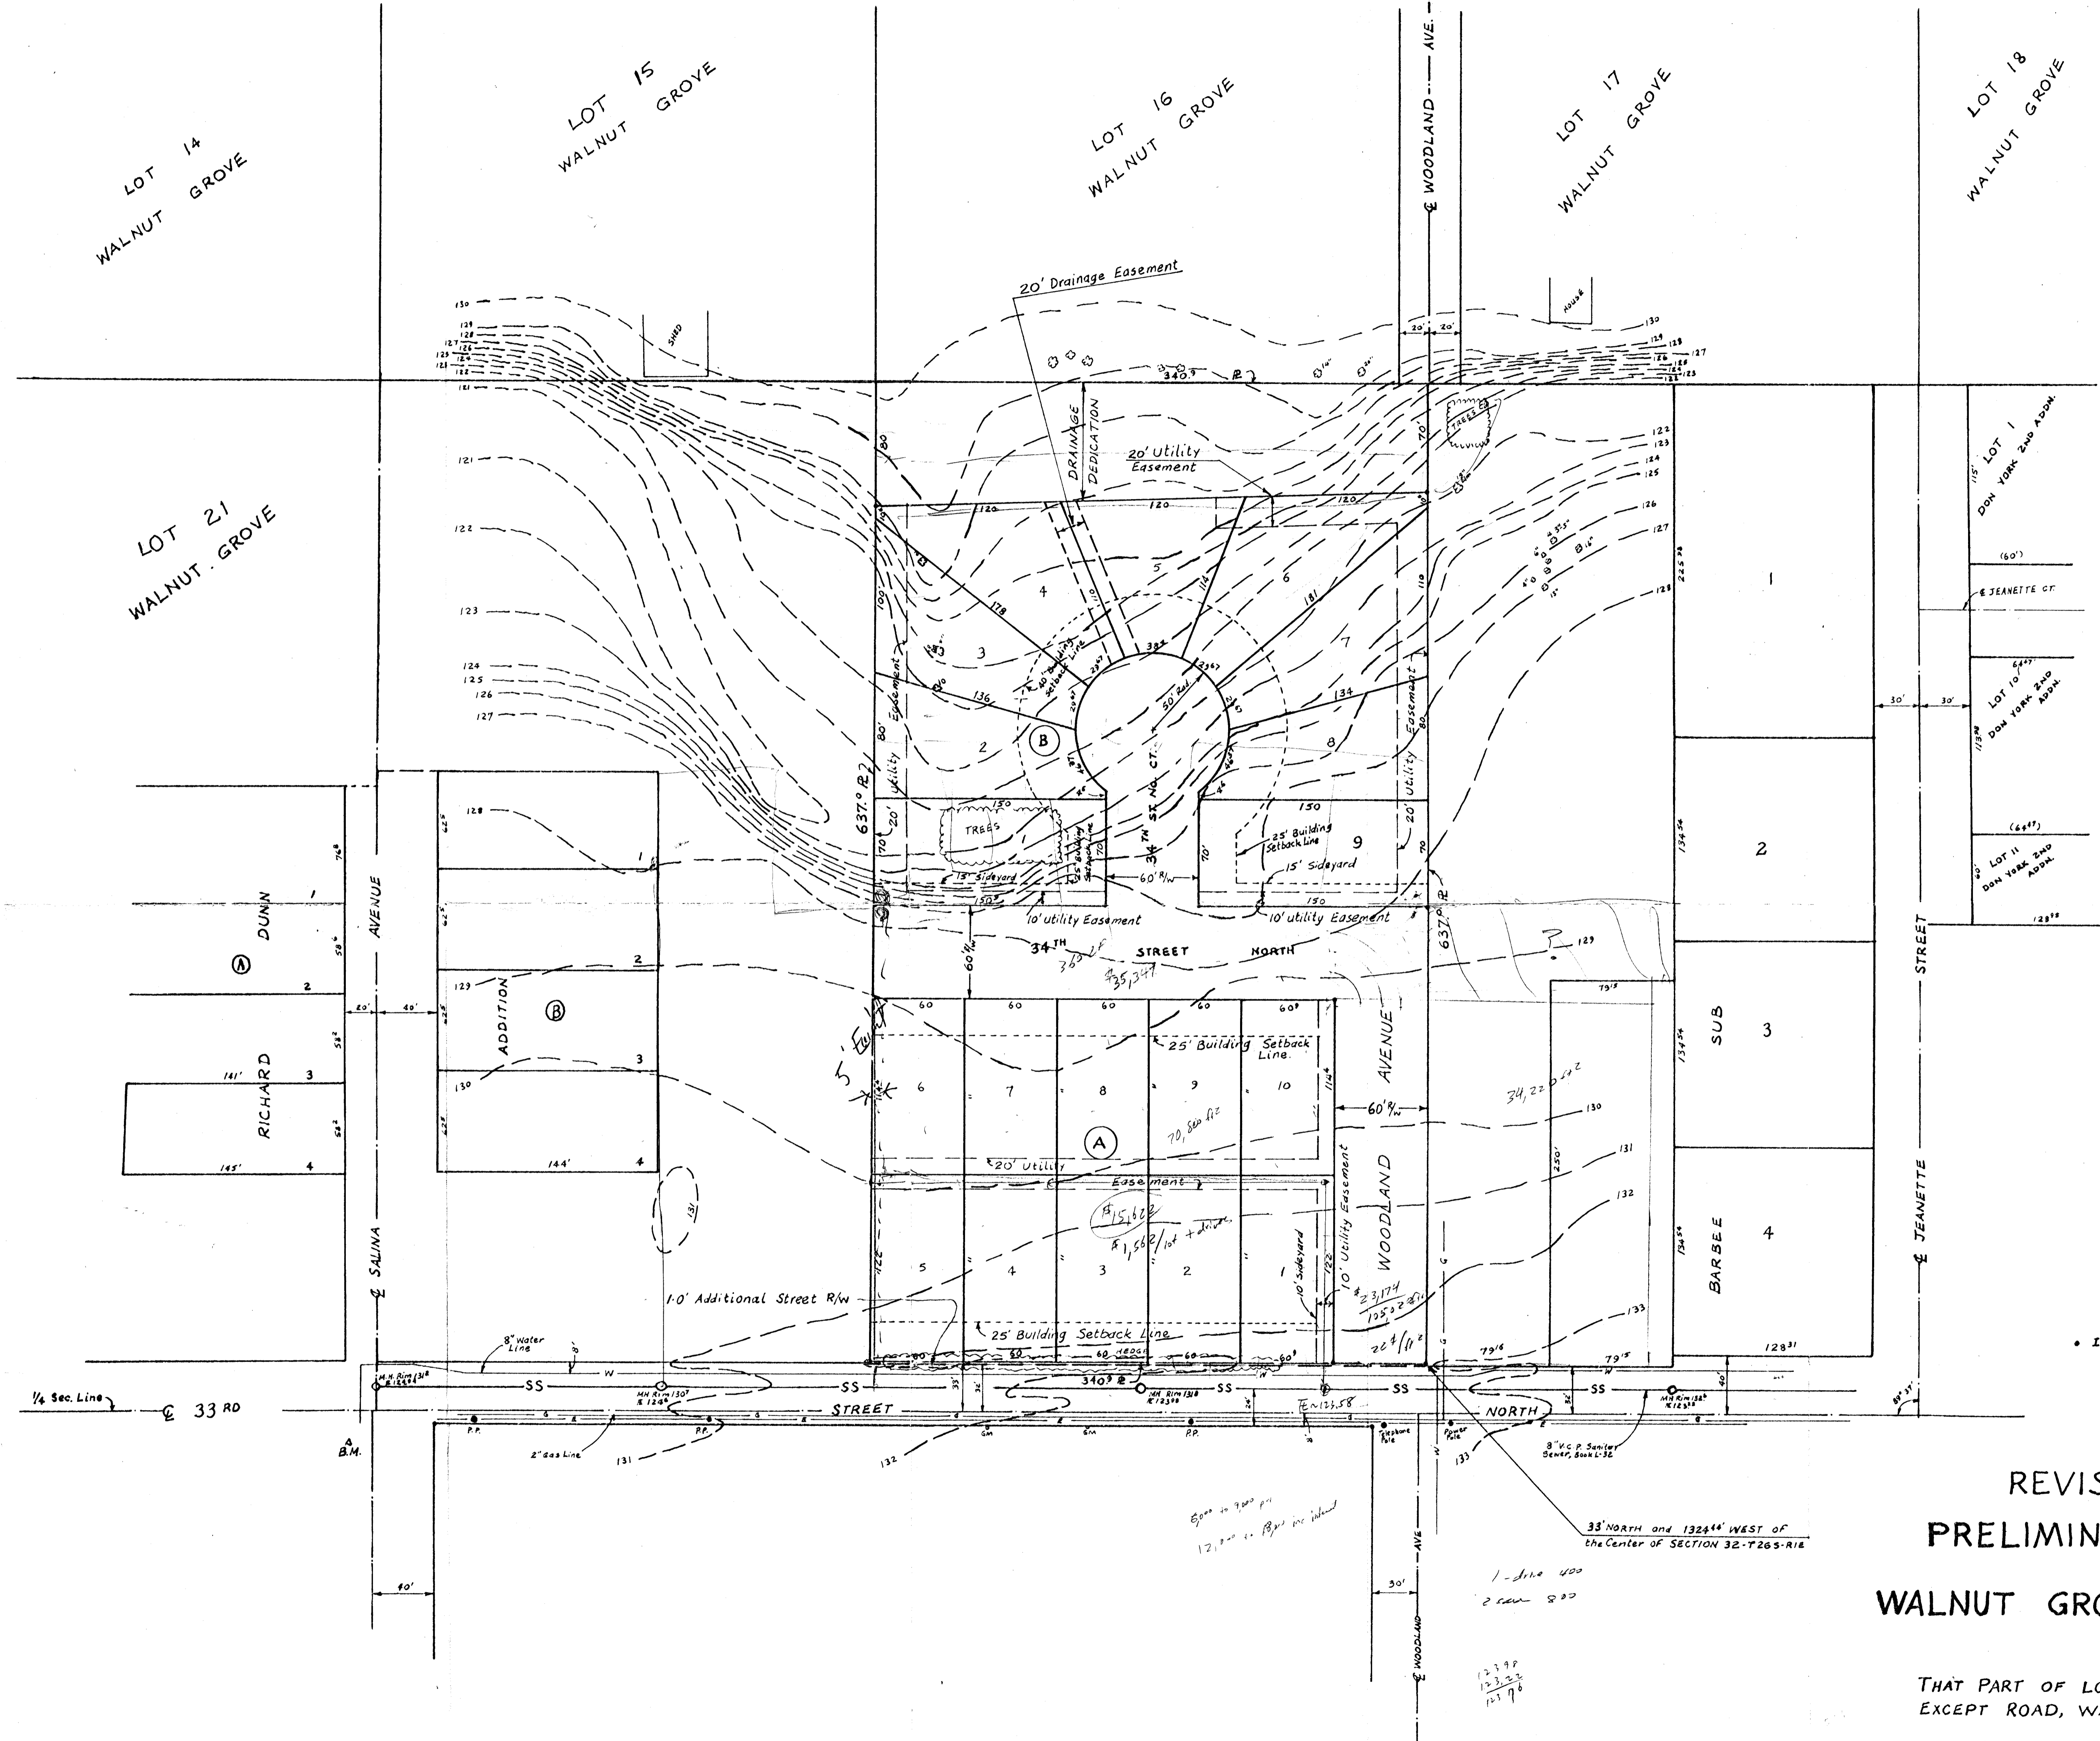

REVISED  
PRELIMINARY PLAT  
WALNUT GROVE 5TH ADDITION

THAT PART OF LOT 21 LYING SOUTH OF LOT 16  
EXCEPT ROAD, WALNUT GROVE, WICHITA, KANSAS

ENGINEER: YASH D. DESAI, P.E. DEC. 1983  
FIRESIDE ENGINEERING COMPANY  
(316) 744 0307 6359 EAST PARKVIEW ST, WICHITA

B.M. - CITY Disc 15' West of Center Line of  
Salina Ave. & 20' South of 1/4 Section  
Corner. ELEV. 130.26

1 - line 400  
2 - line 500  
12 3 9 9  
12 3 2 2  
12 1 7 0