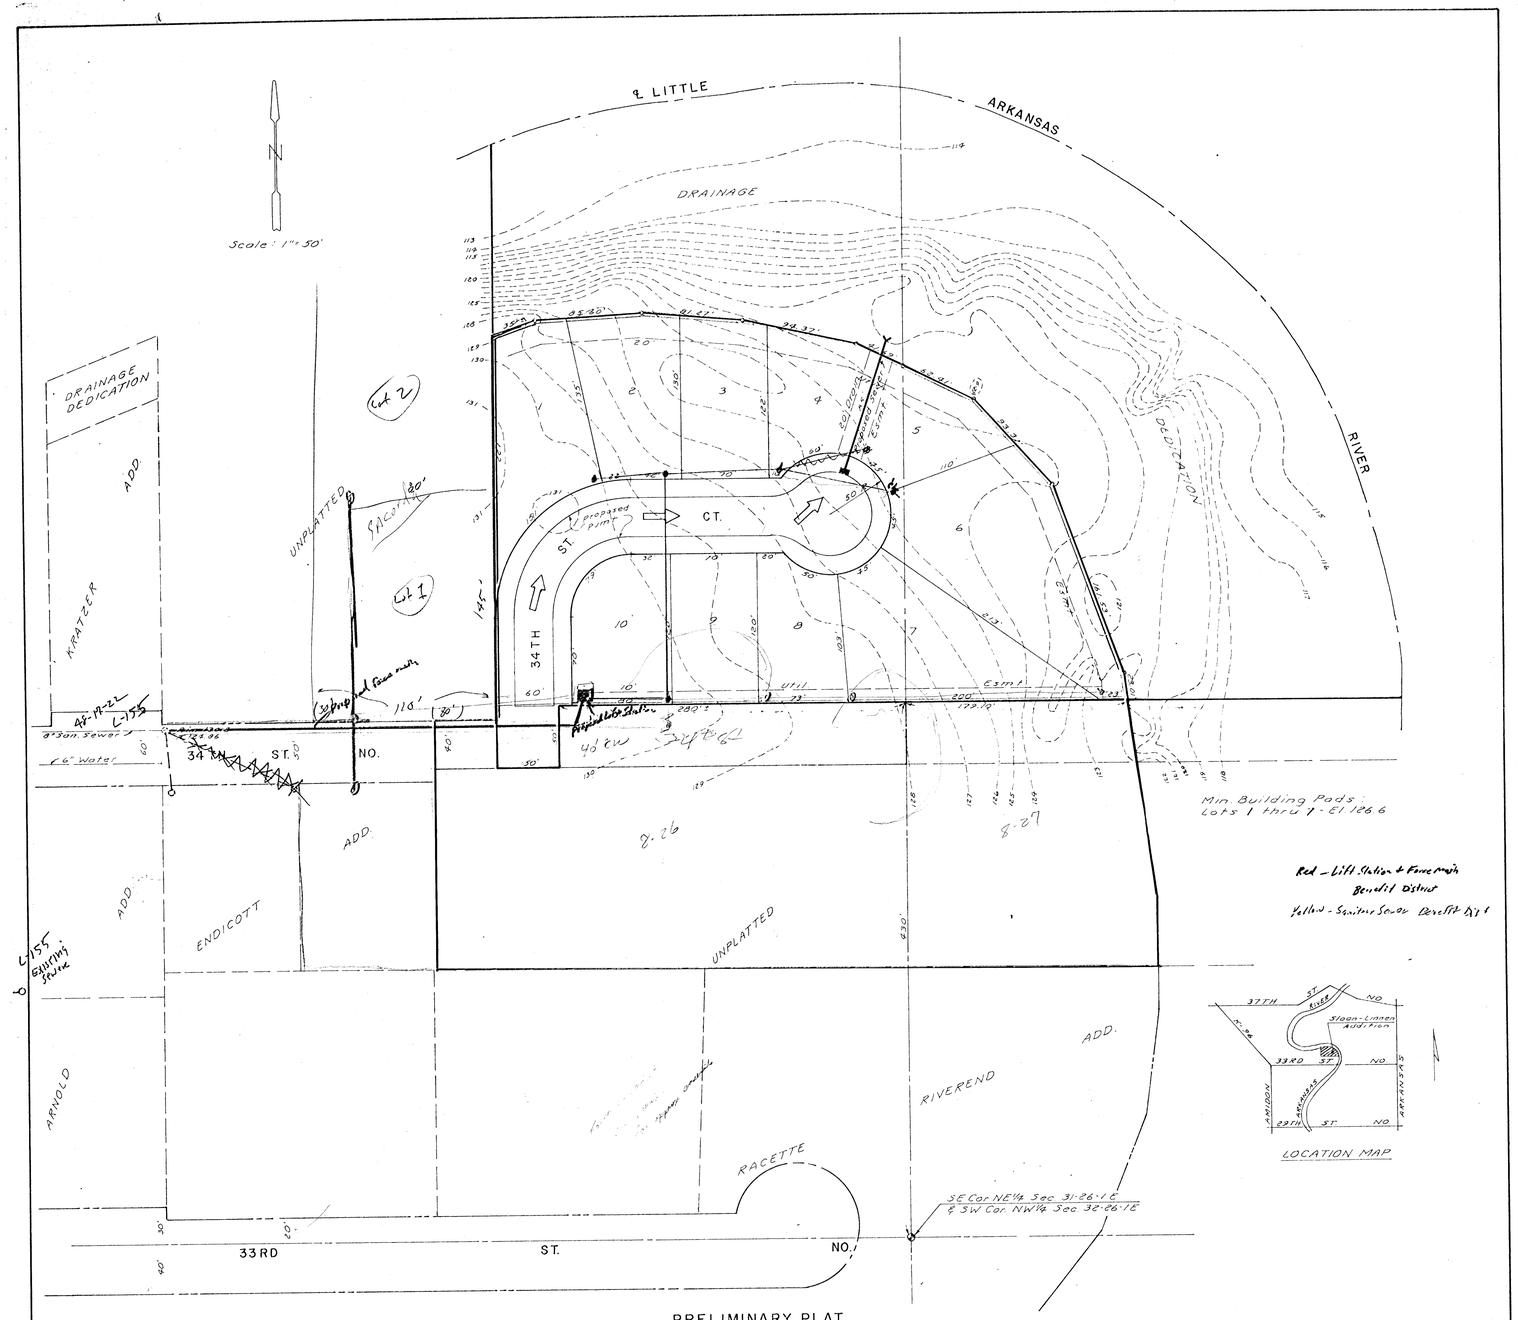

REVISED COPY

PRELIMINARY PLAT

SLOAN-LINNEN ADDITION

Owners - Homer Sloan & Ray Linnen