

3mg AA  
 Scale: 1" = 50'

DRAINAGE DEDICATION  
 ADD.  
 KRATZER


UNPLATTED

34TH ST. NO.


ADD.  
 ENDICOTT

ADD.  
 ARNOLD

33RD ST. NO.

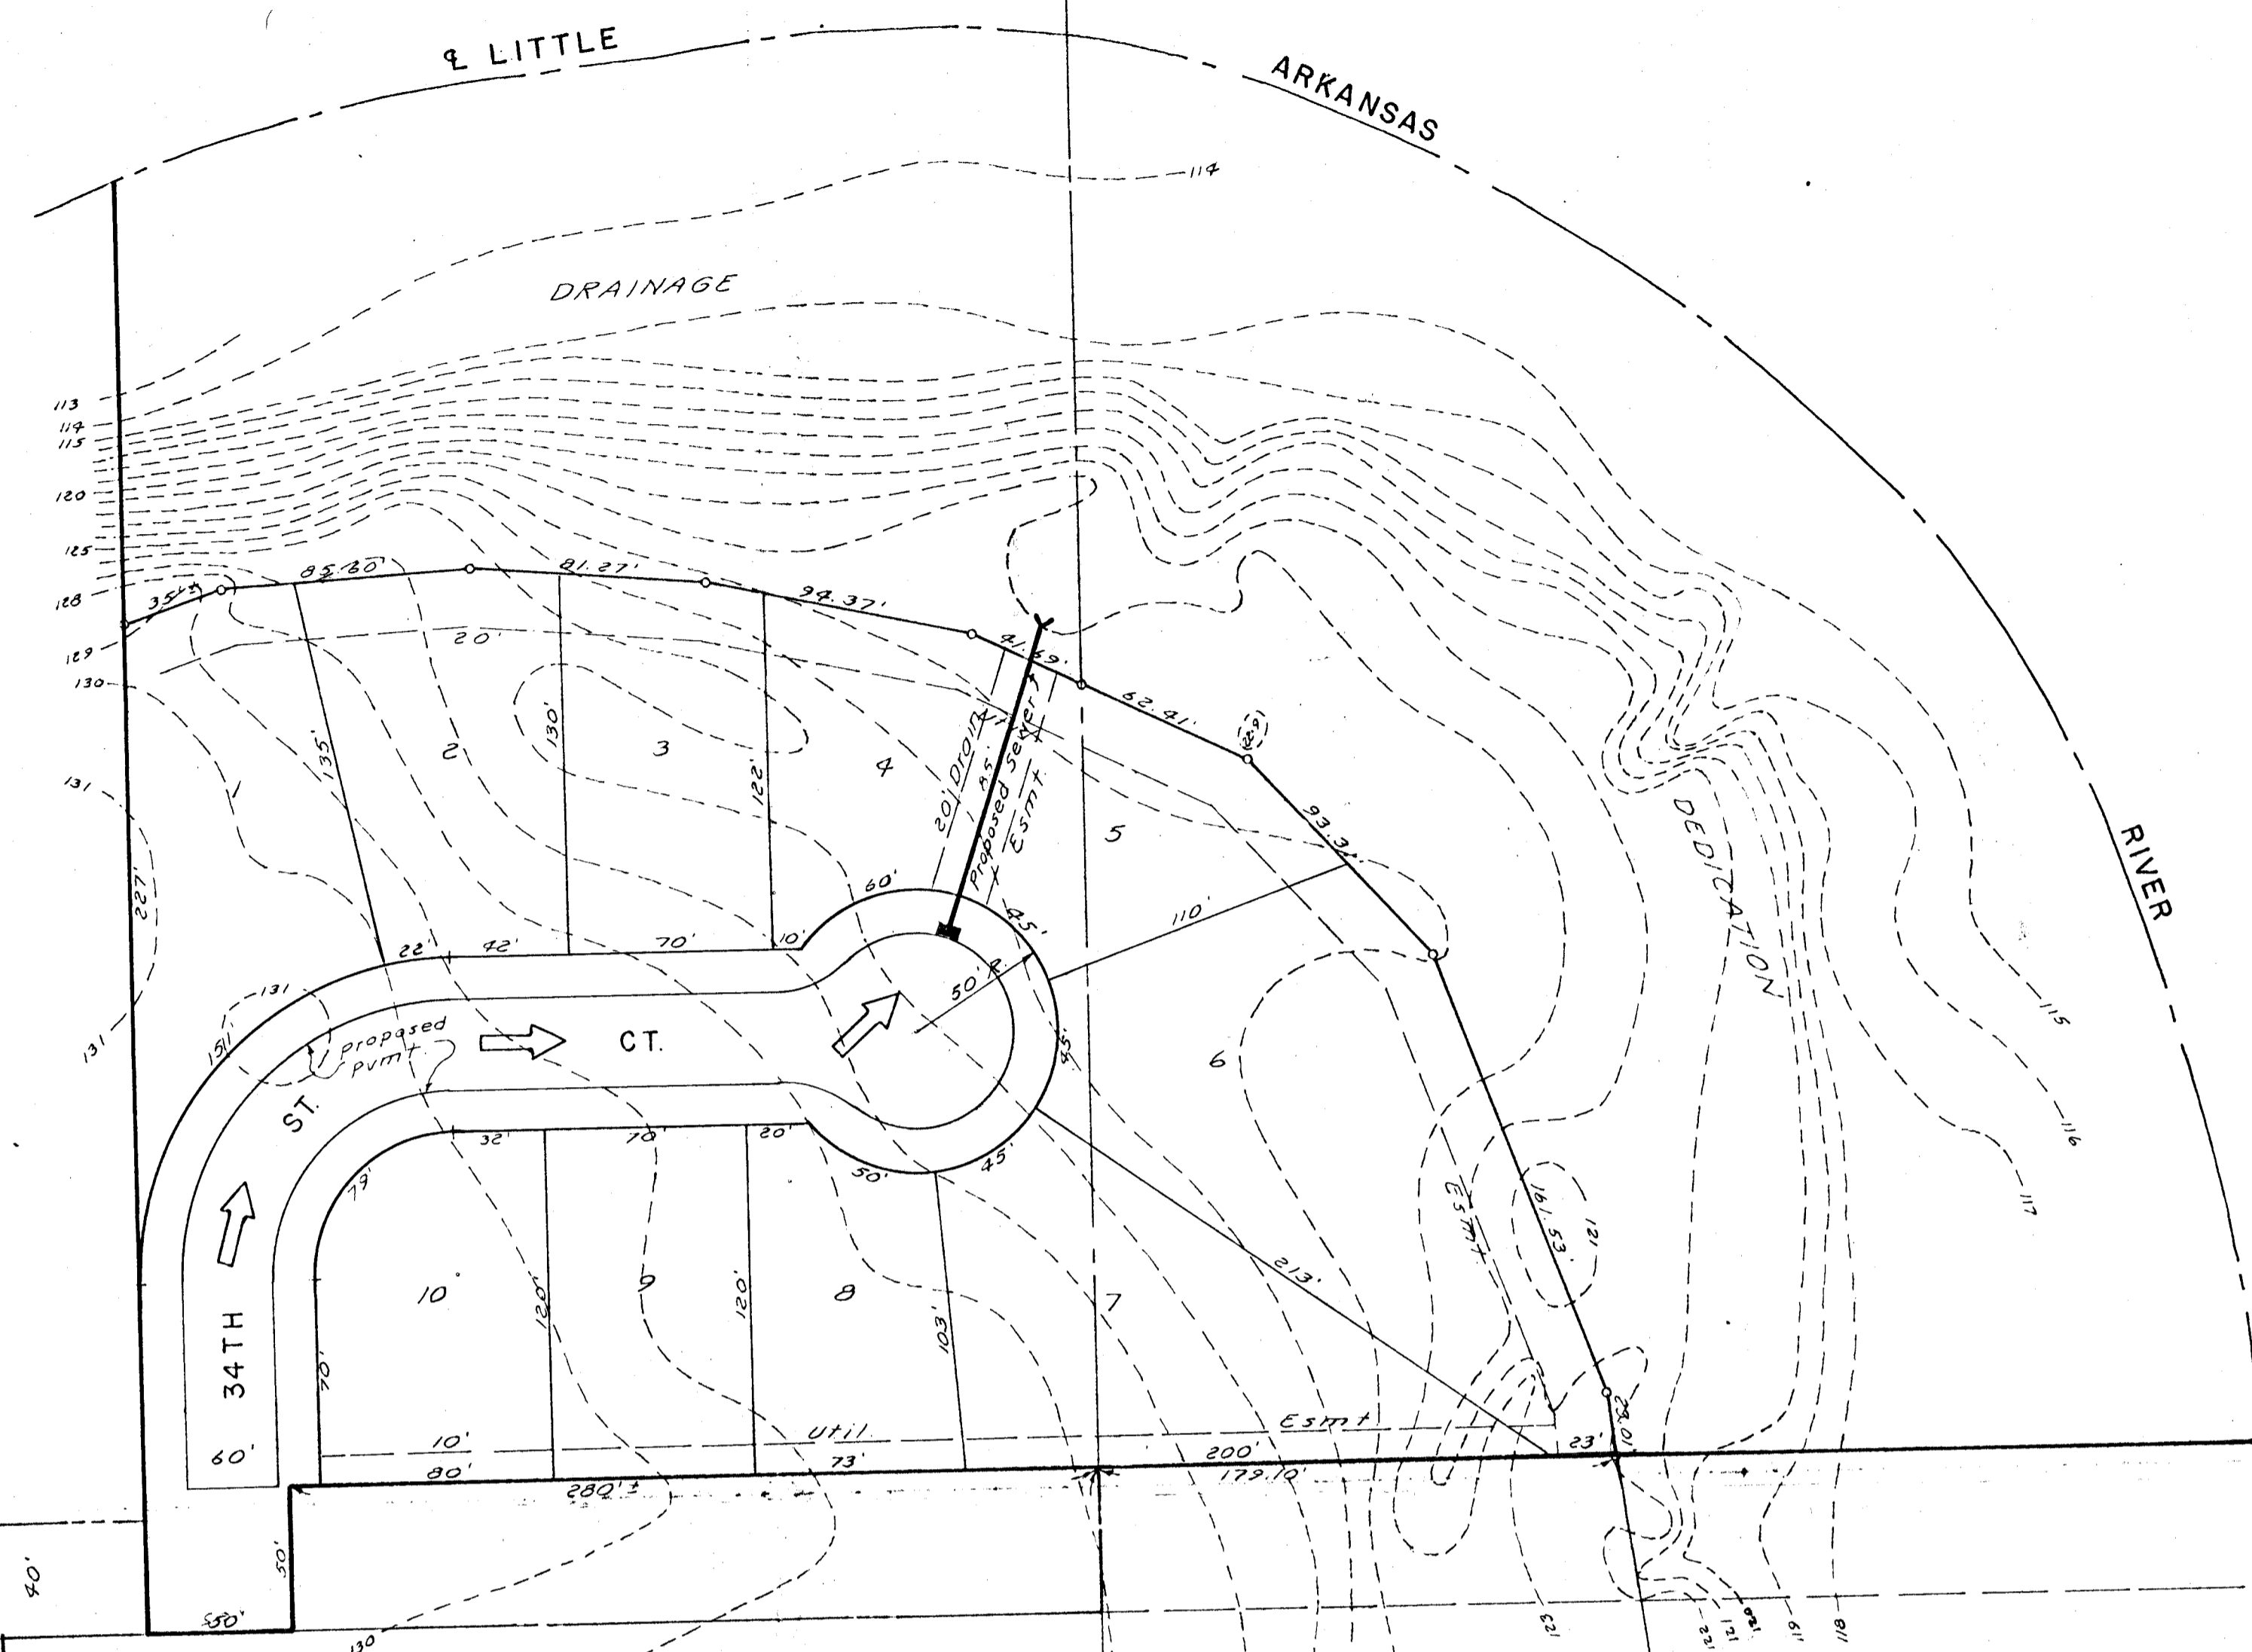

Min. Building Pads:  
 Lots 1 thru 7 - E1 126.6  
 Checked with Flood Control  
 DWS = 131 - 123.6 City Data

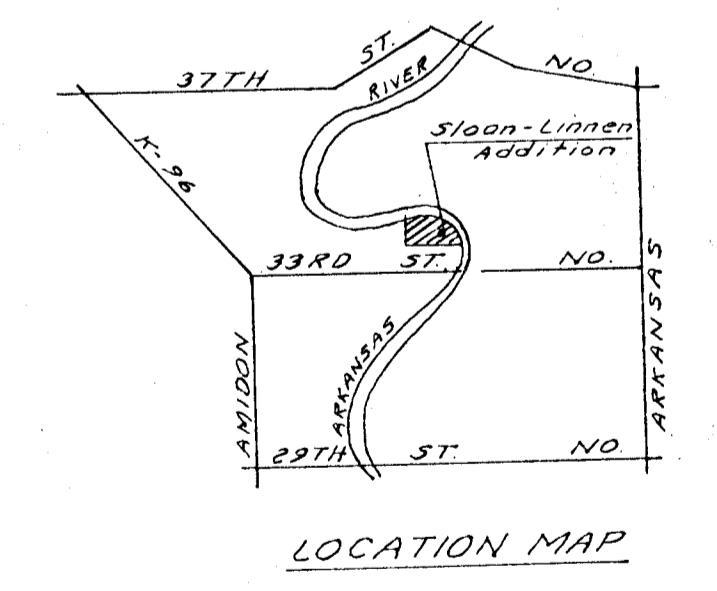

SE Cor. NE 1/4 Sec. 31-26-16  
 & SW Cor. NW 1/4 Sec. 32-26-16

PRELIMINARY PLAT  
**SLOAN - LINNEN ADDITION**

Drainage Plan  
 1/16/80  
 Sloan - Linnen Addition

Owners - Homer Sloan & Ray Linnen

B.M. City Disc. 42'E & 34' N. E  
 33rd & Amidon - E1. 131.36

BAUGHMAN CO., P.A. 10-26-72