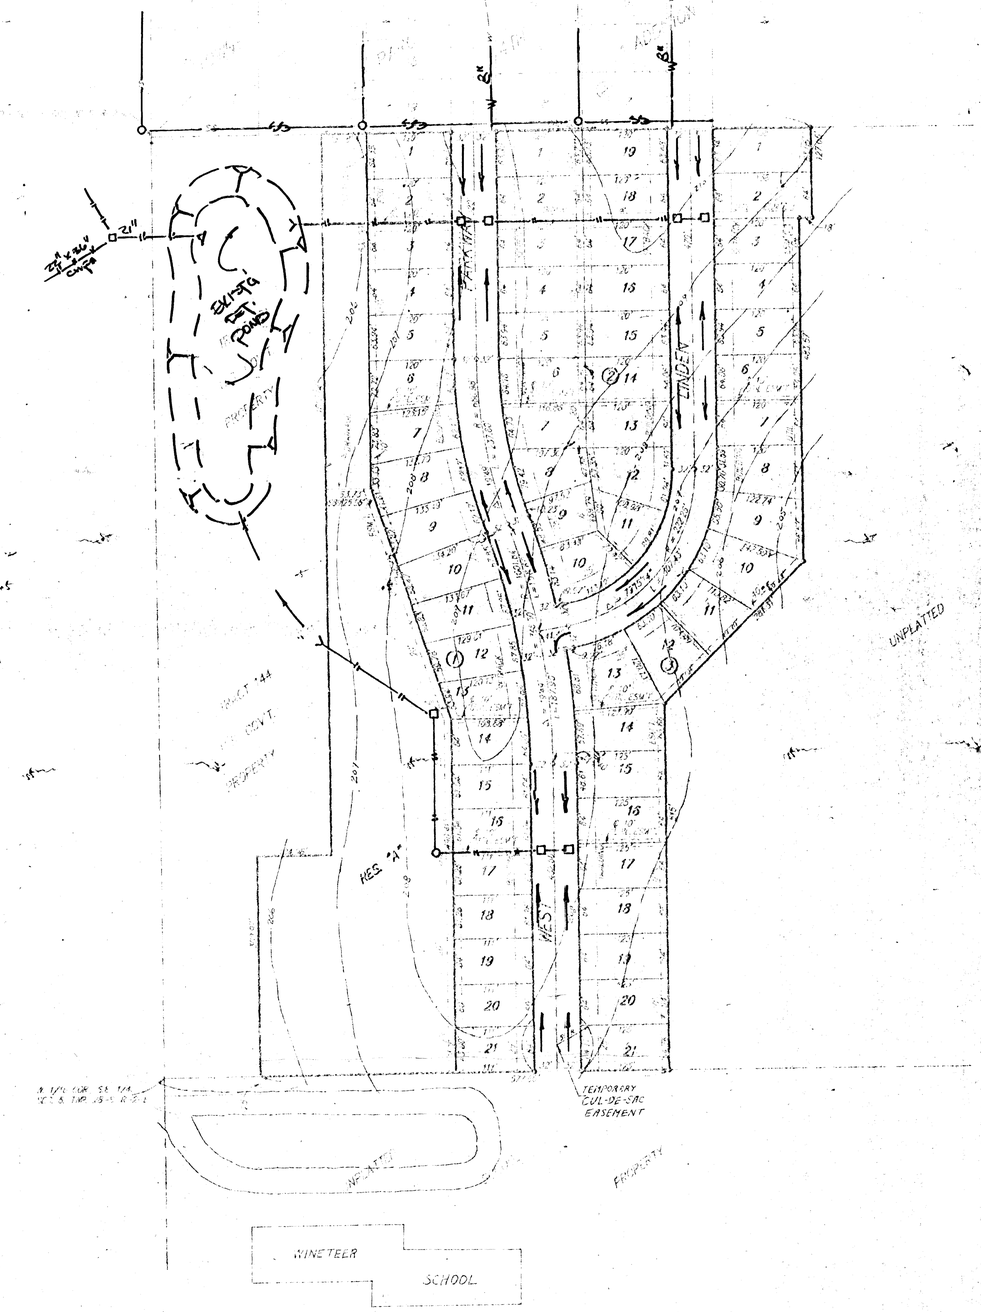

PRELIMINARY PLAT
TOWNE PARC 5TH ADDITION

WICHITA, SEDGWICK COUNTY, KANSAS

OWNER: INVESTMENTS, INC.
ROY H. JACOBY, PRESIDENT

LEGAL: UNPLATTED TRACT IN THE S.E. 1/4, SEC. 3, TWP. 28-S, R-2-E

BENCH MARK: CITY STANDARD DISC 48' S. & 2' E. OF THE N.W. COR. N.E. 1/4, SEC. 3, TWP. 28-S, R-2-E
ELEV. = 192.205 (CITY DATUM)

1" = 100'

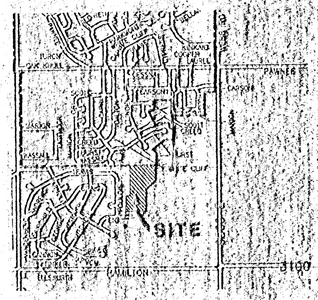

VICINITY MAP

BAUGHMAN COMPANY, P. A.
SURVEYING & ENGINEERING

DRAINAGE CONCEPT