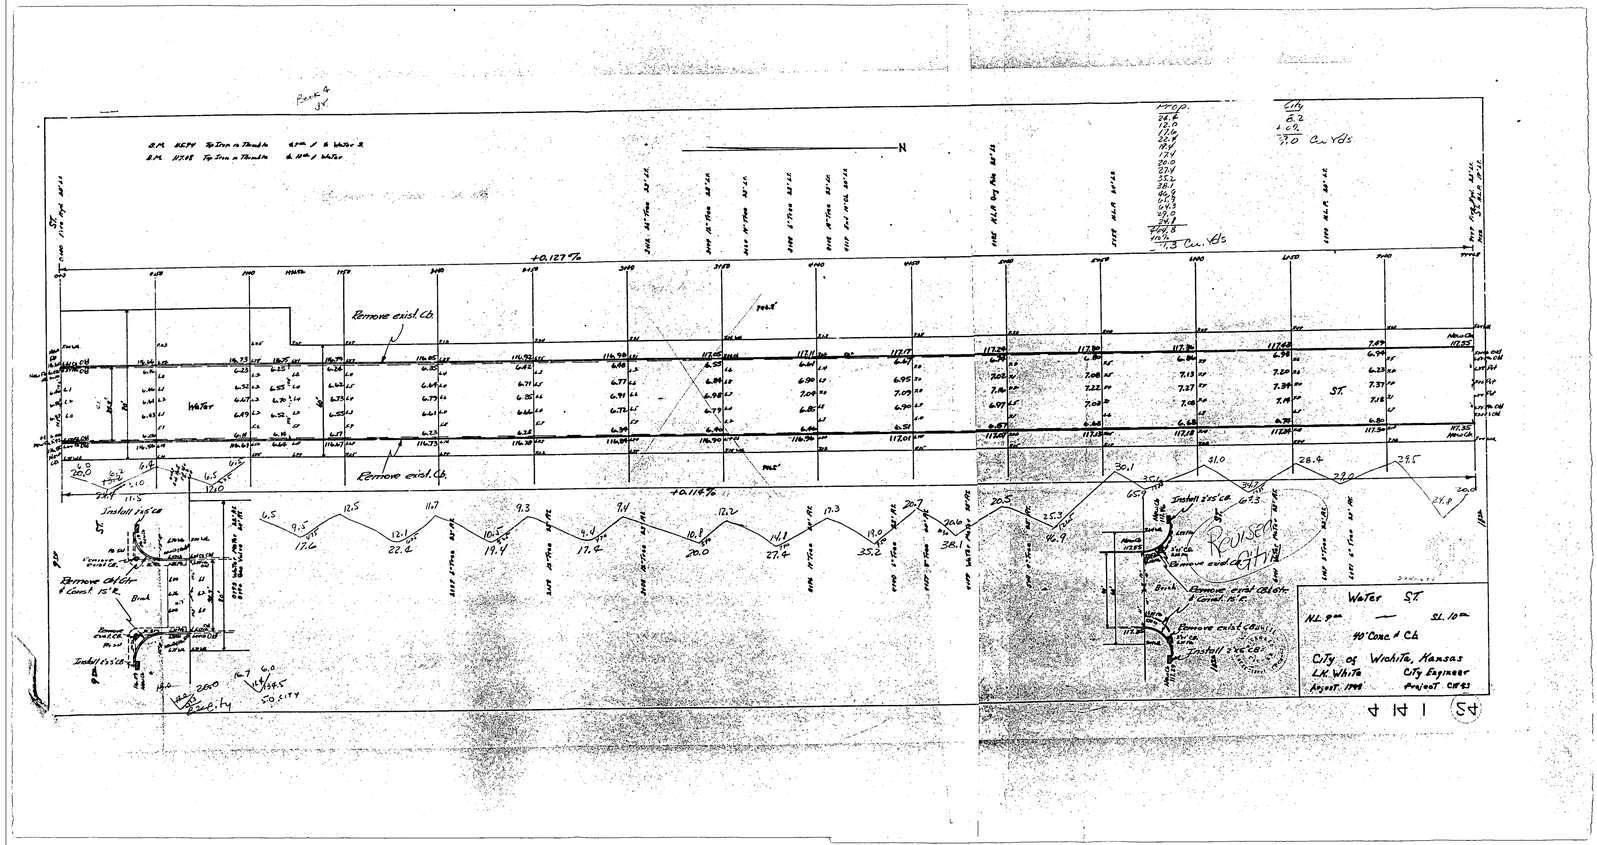
Water ST
N.L. 9.0
S.L. 10.0
40' Conc. & Ch
City of Wichita, Kansas
L.H. White City Engineer
Remove exist. Ch.
Install 2'x5' Ch.
Remove exist. Ch.
Remove exist. Ch.
Install 2'x5' Ch.
Remove exist. Ch.
Remove exist. Ch.
Install 2'x5' Ch.
Remove exist. Ch.
Remove exist. Ch.
Install 2'x5' Ch.
Water
ST
+0.127%
+0.116%
N
Prop.
City
7.0 Cu. Yds
7.3 Cu. Yds
Bank 4
JV