


FIRE HYDRANT LAYOUT TOWNE PARC 2ND ADDITION

BAUGHMAN COMPANY P. A.
SURVEYING & ENGINEERING
316/262-7271 • 315 ELLIS • WICHITA, KANSAS 67211

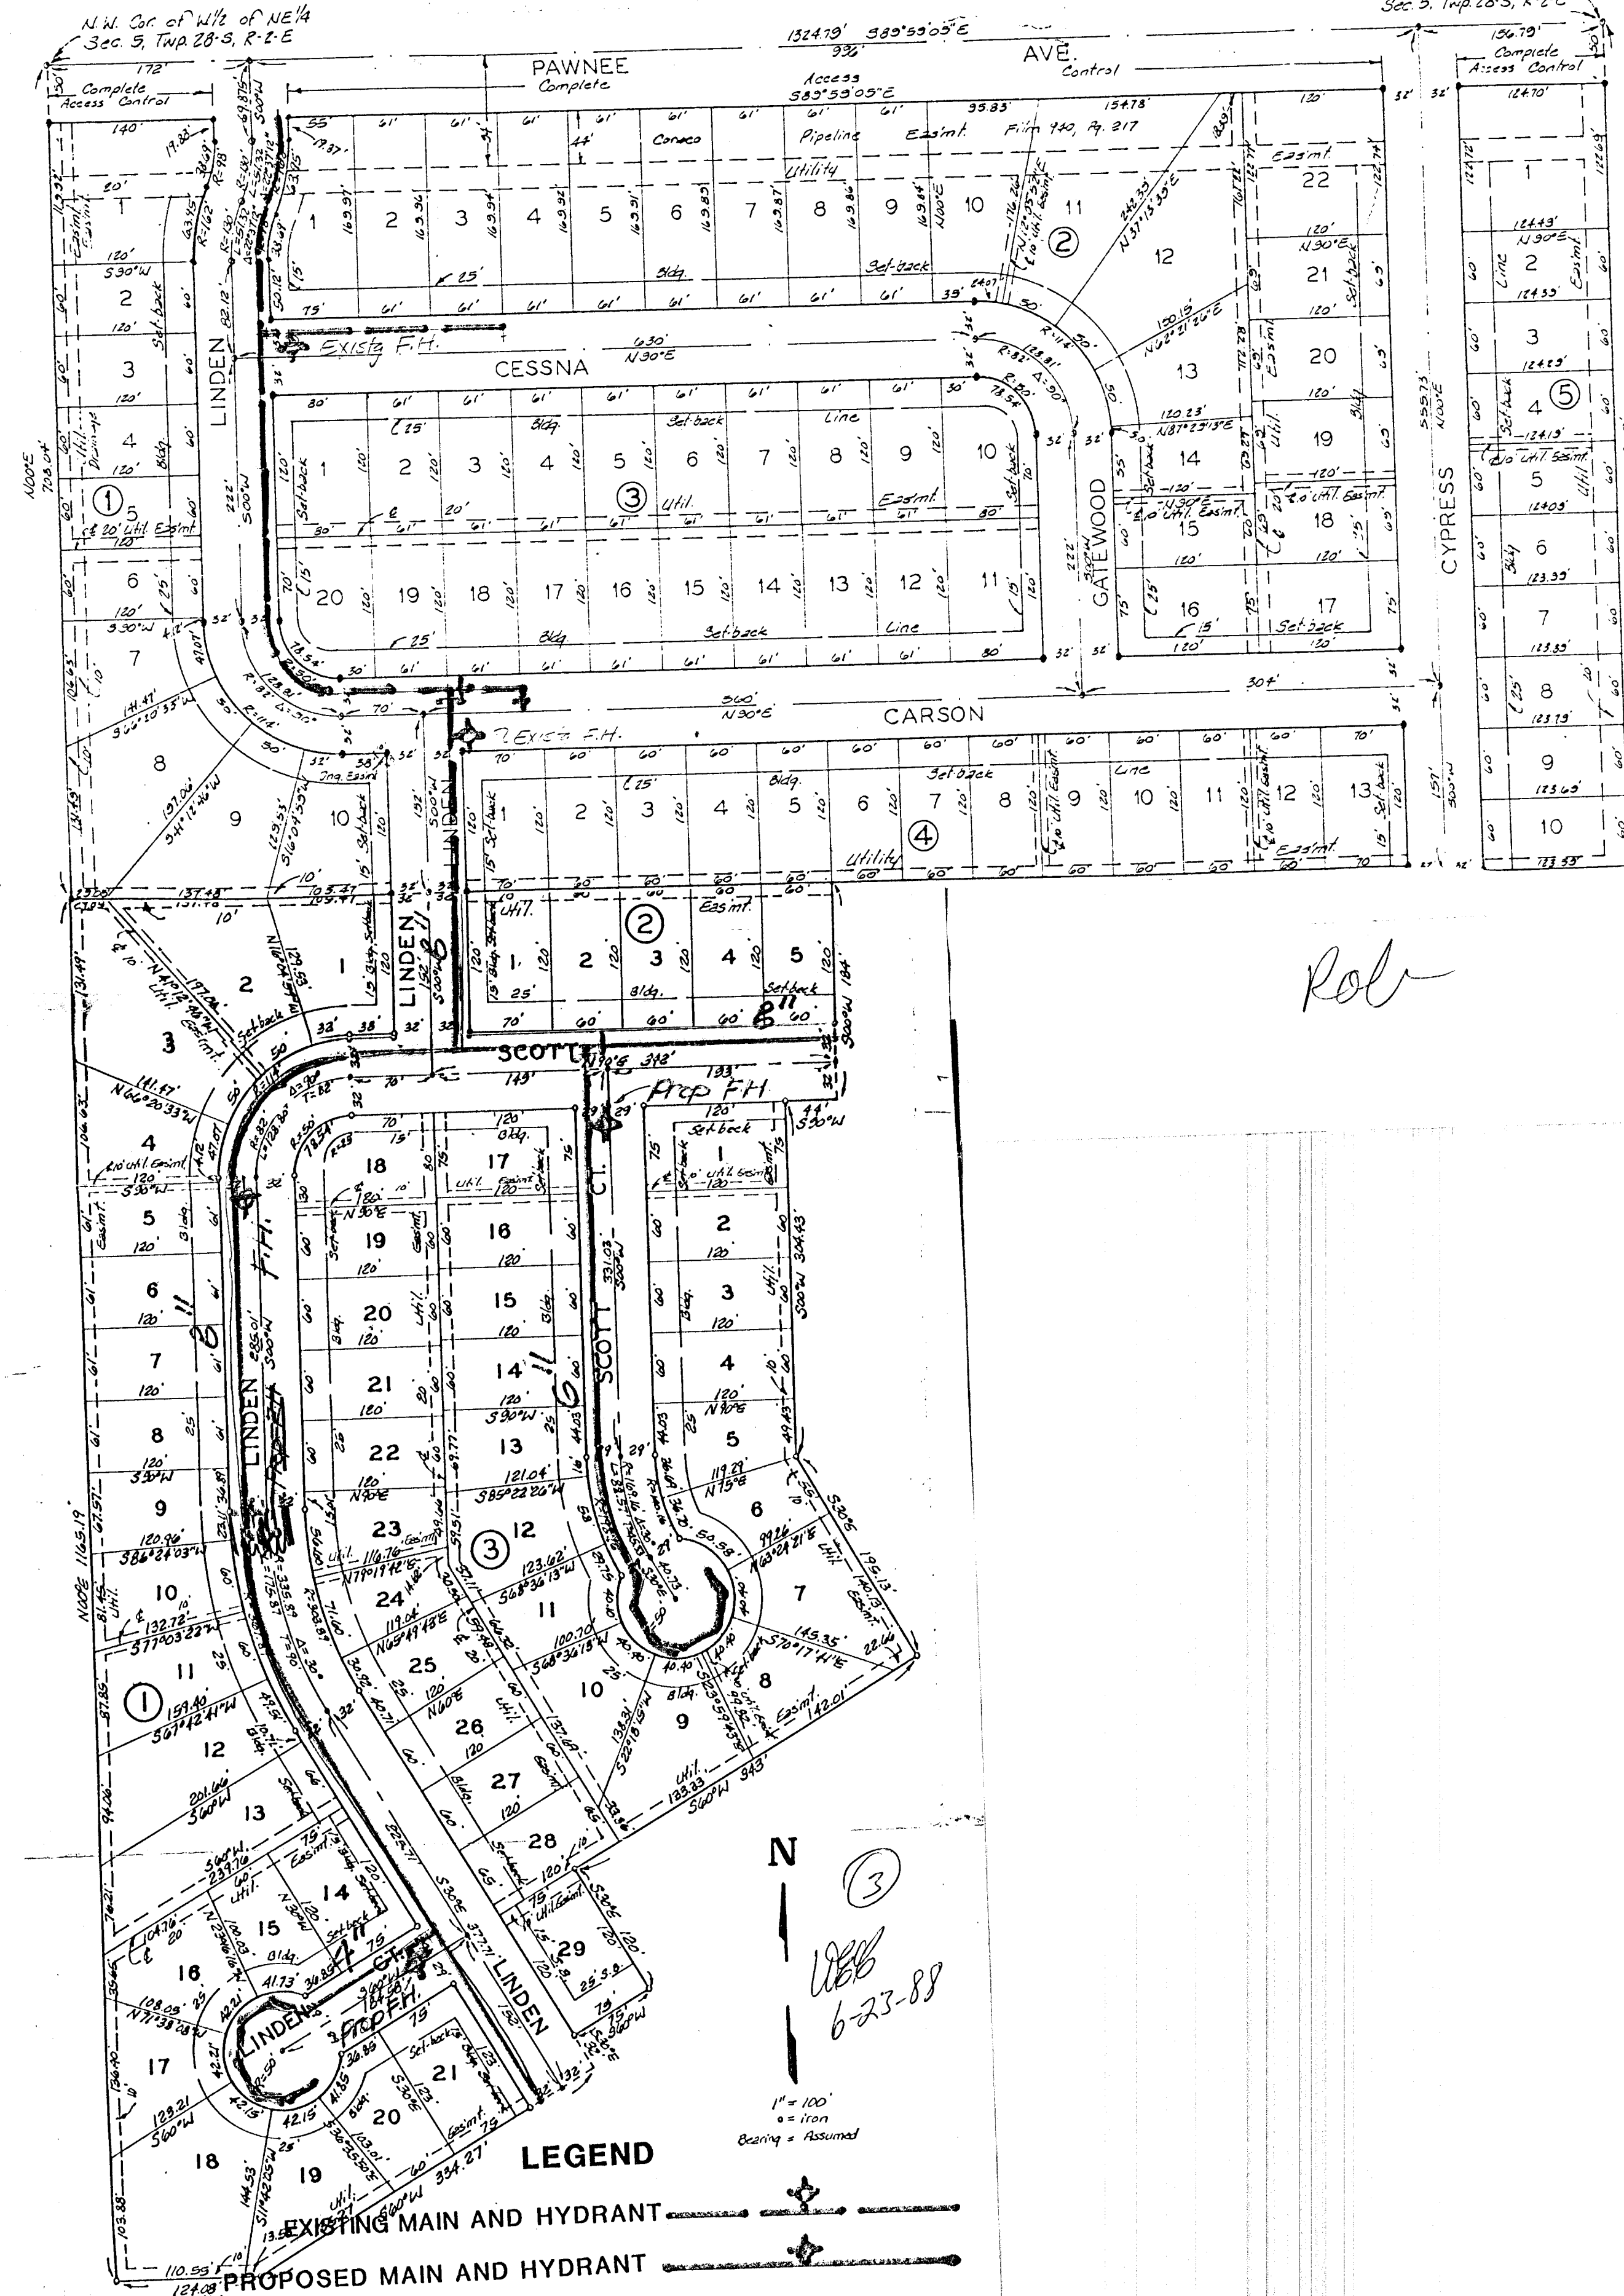

Rob

N.W. Cor. of 1/4 of NE 1/4
Sec. 5, Twp. 28-S, R-2-E

N.E. Cor. of 1/4 of NE 1/4
Sec. 5, Twp. 28-S, R-2-E

50003474