



FINAL SURVEY NOTE BOOK


ORIGINAL SURVEY NOTE BOOK

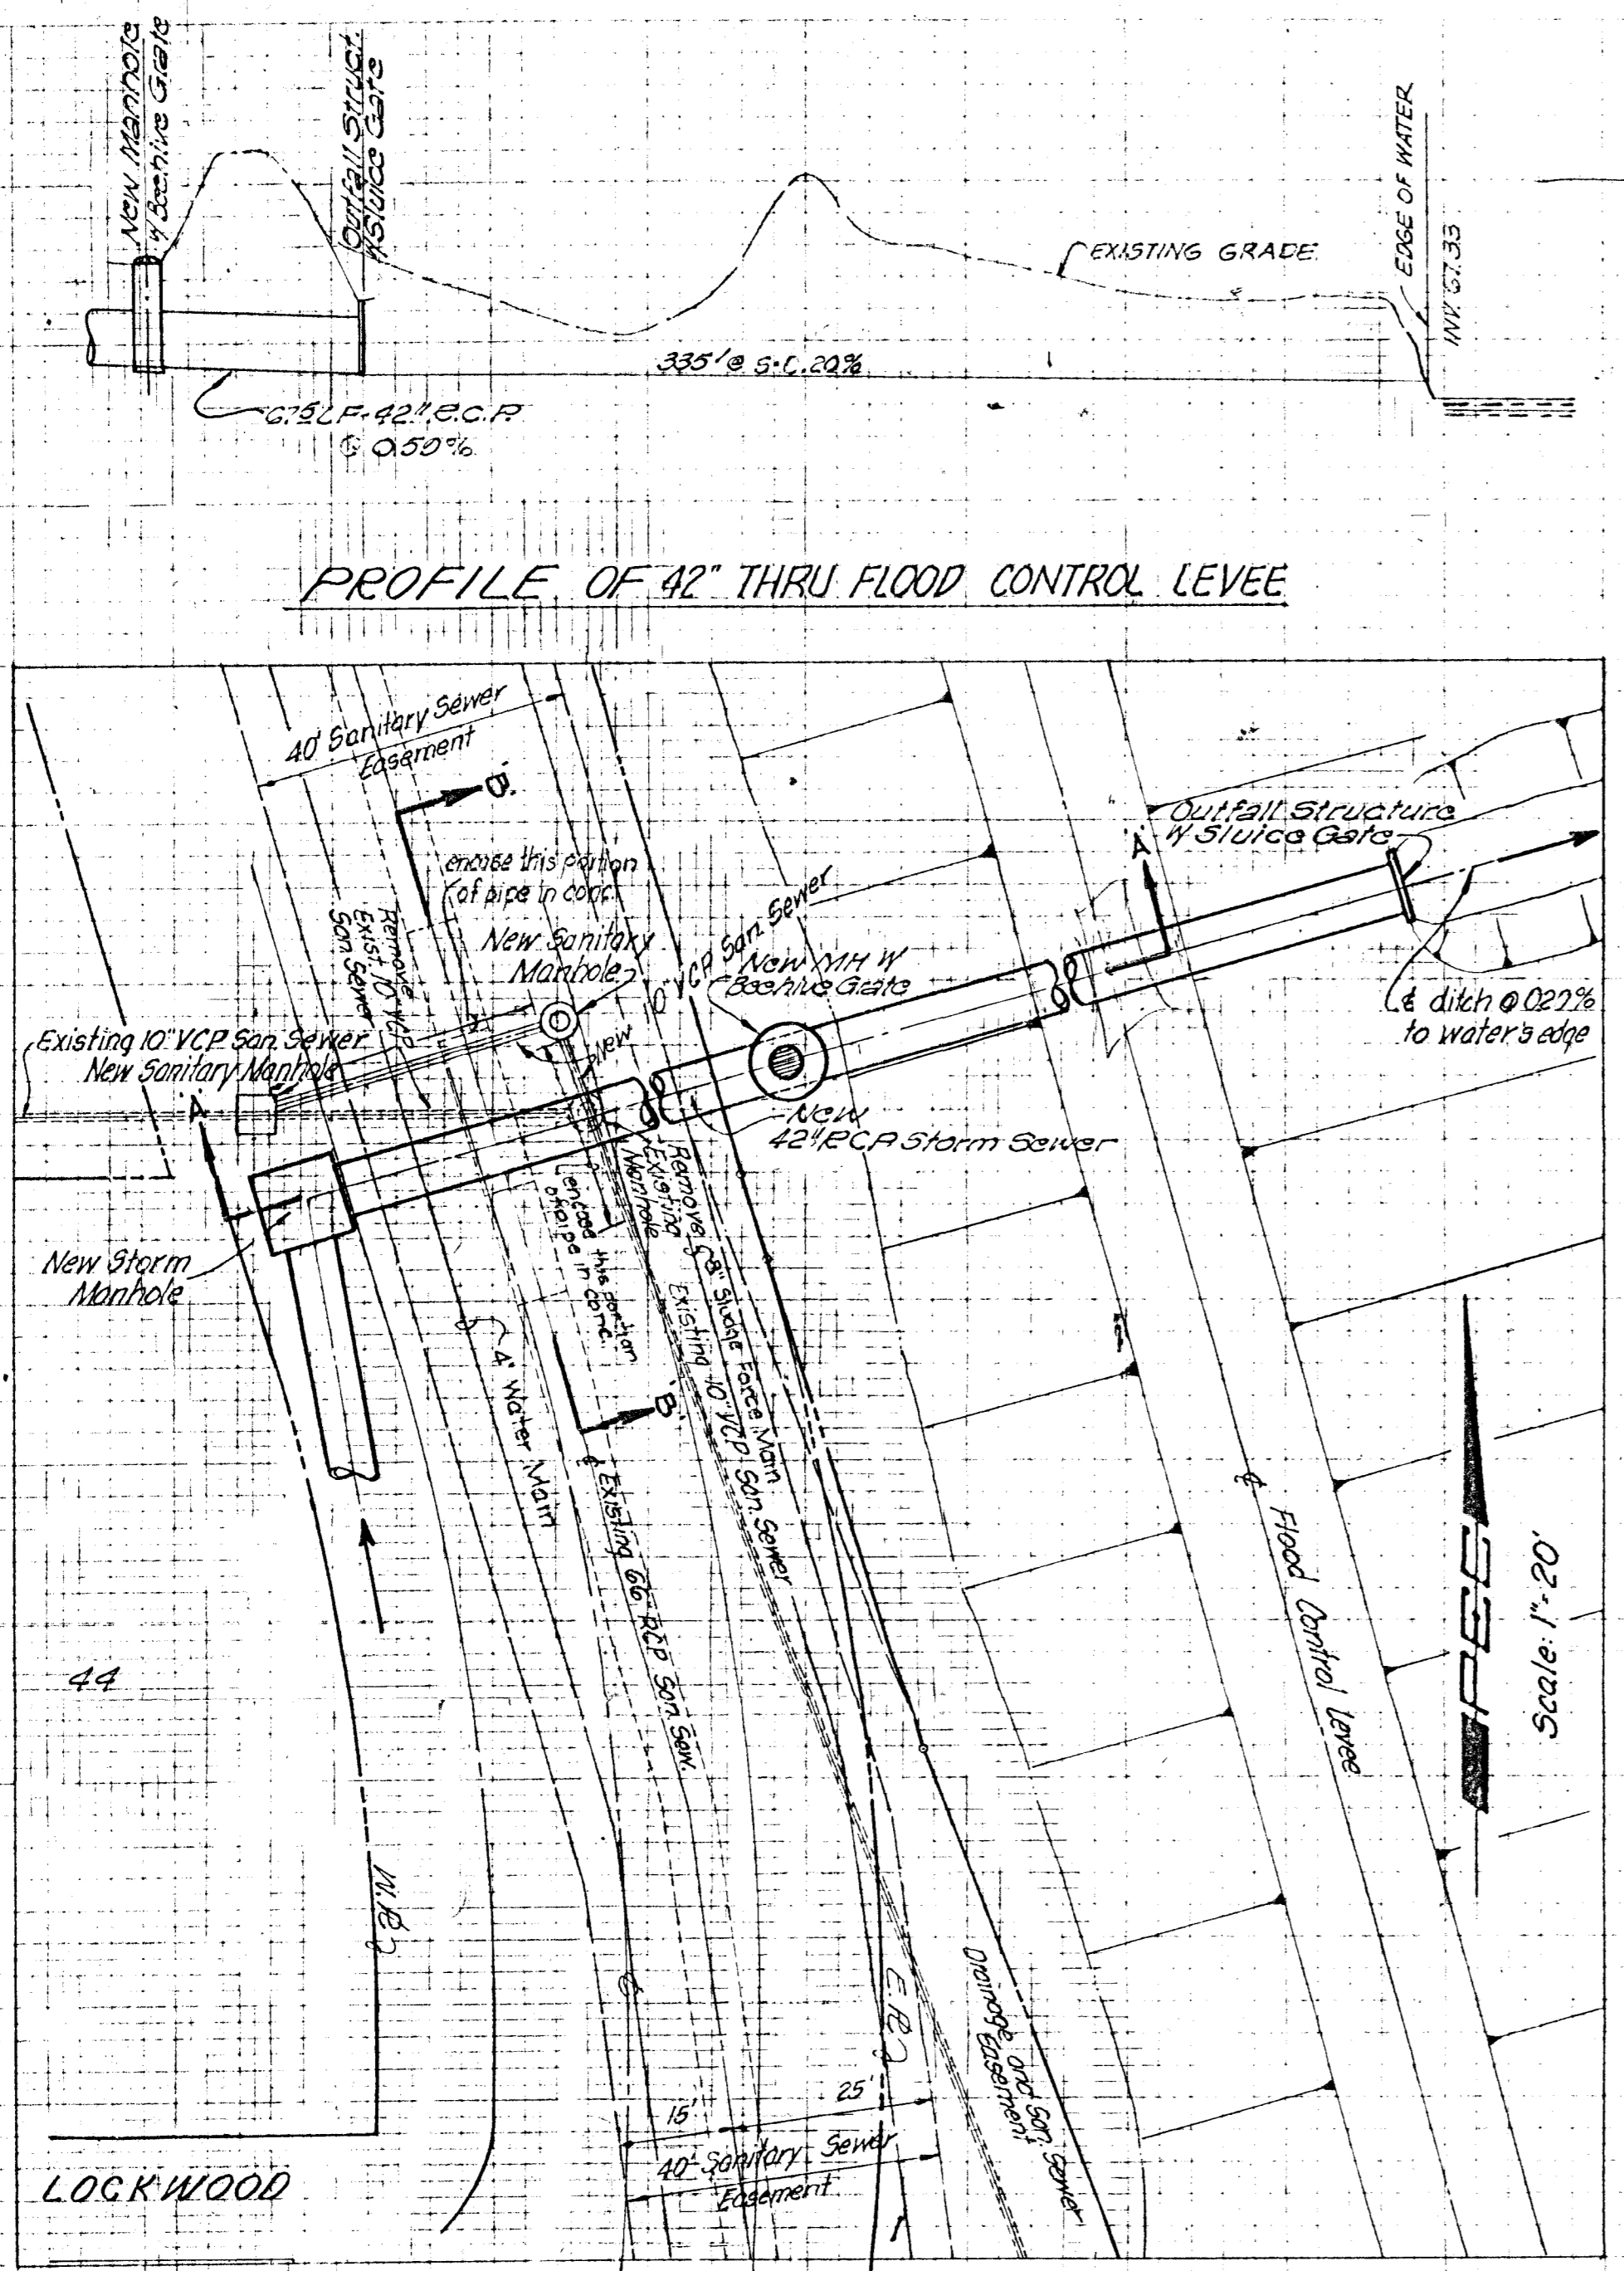

PROFILE OF 42" THRU FLOOD CONTROL LEVEE

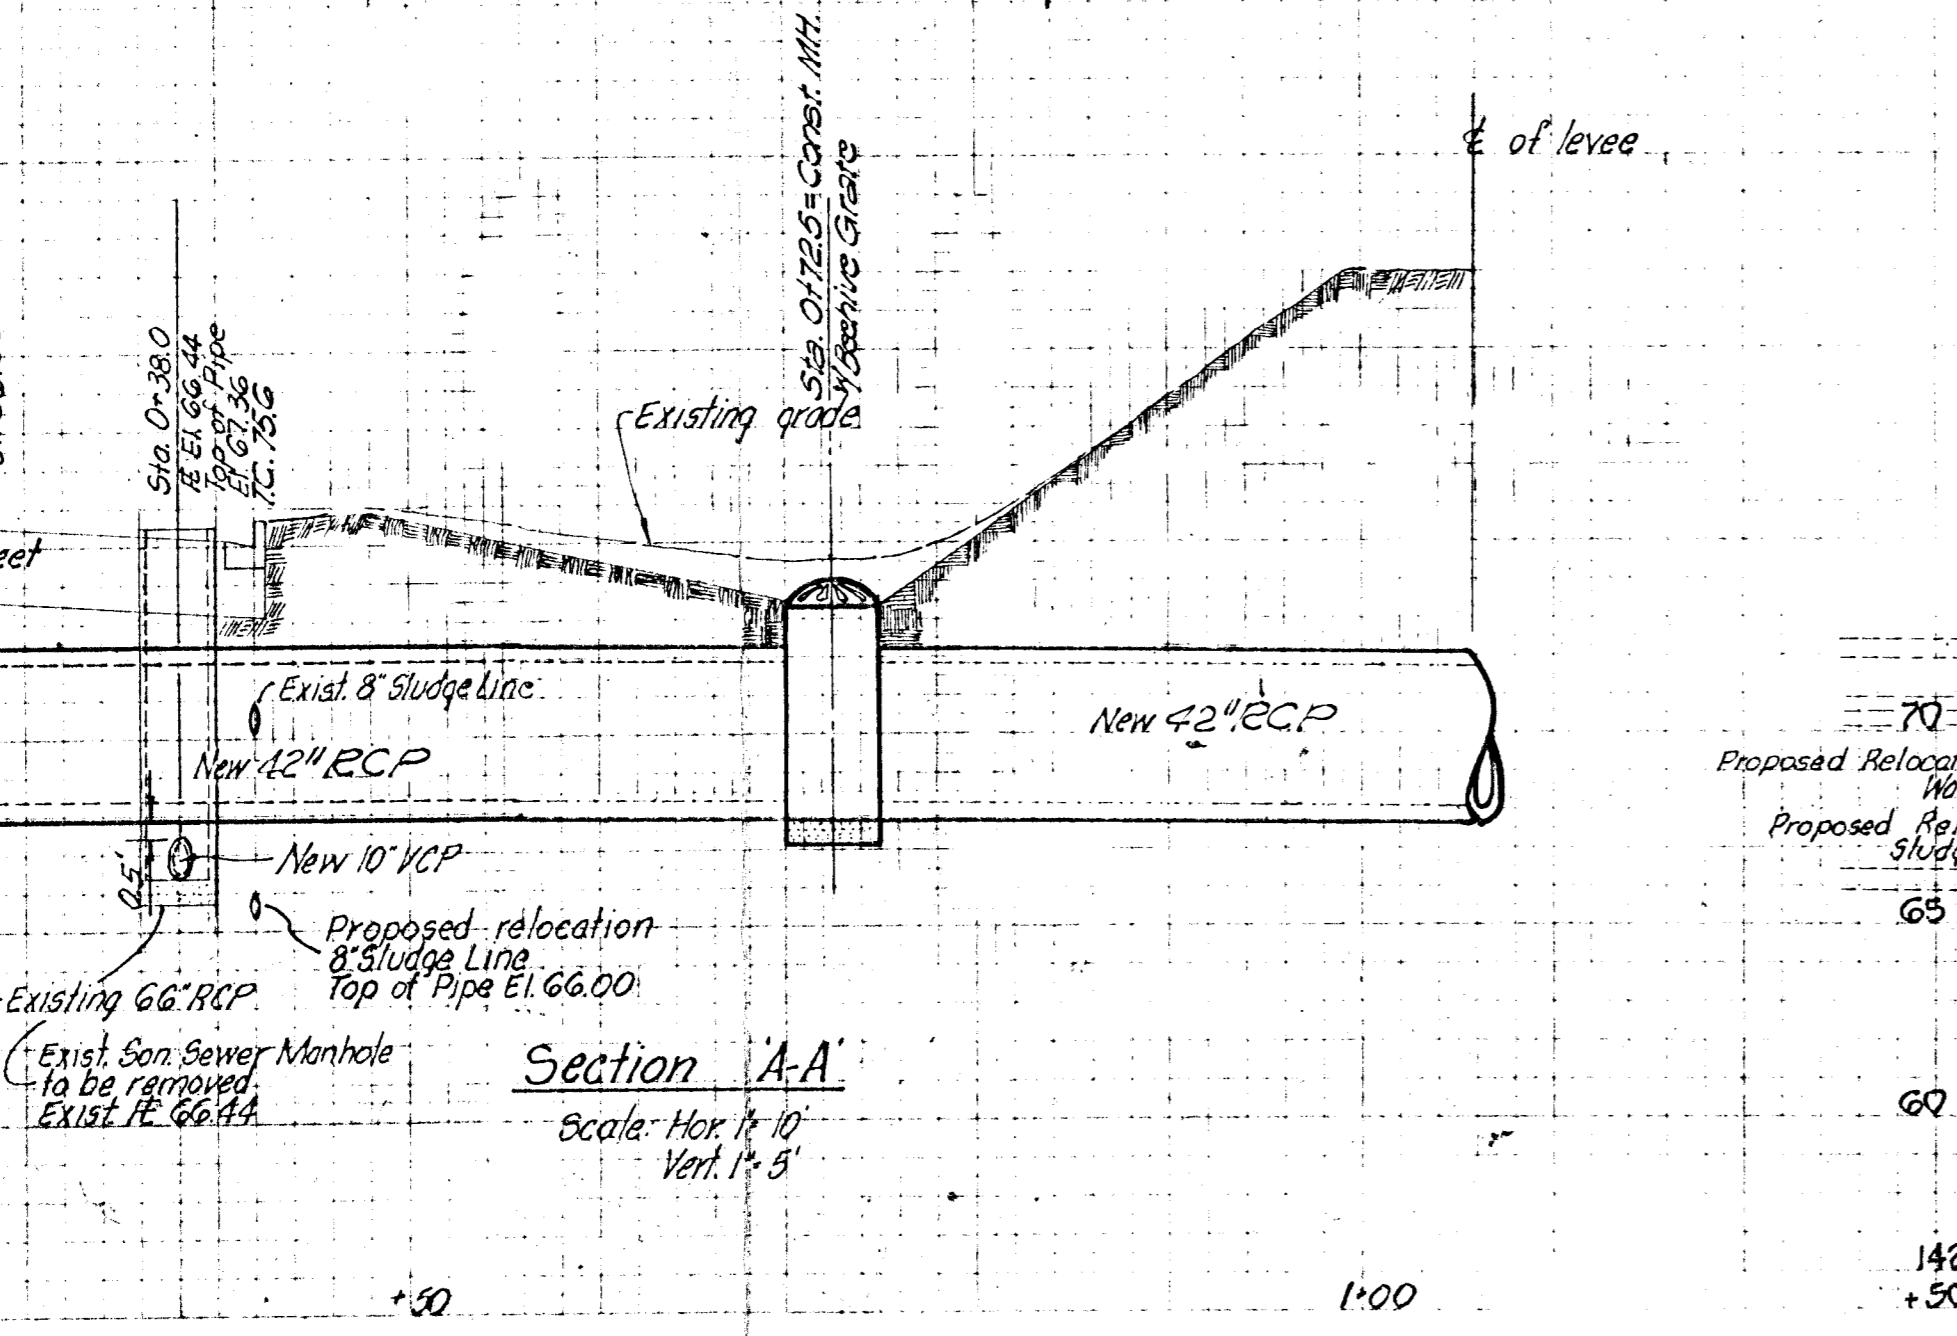


Section A-A
Scale: Hor 1/10
Vert 1/5

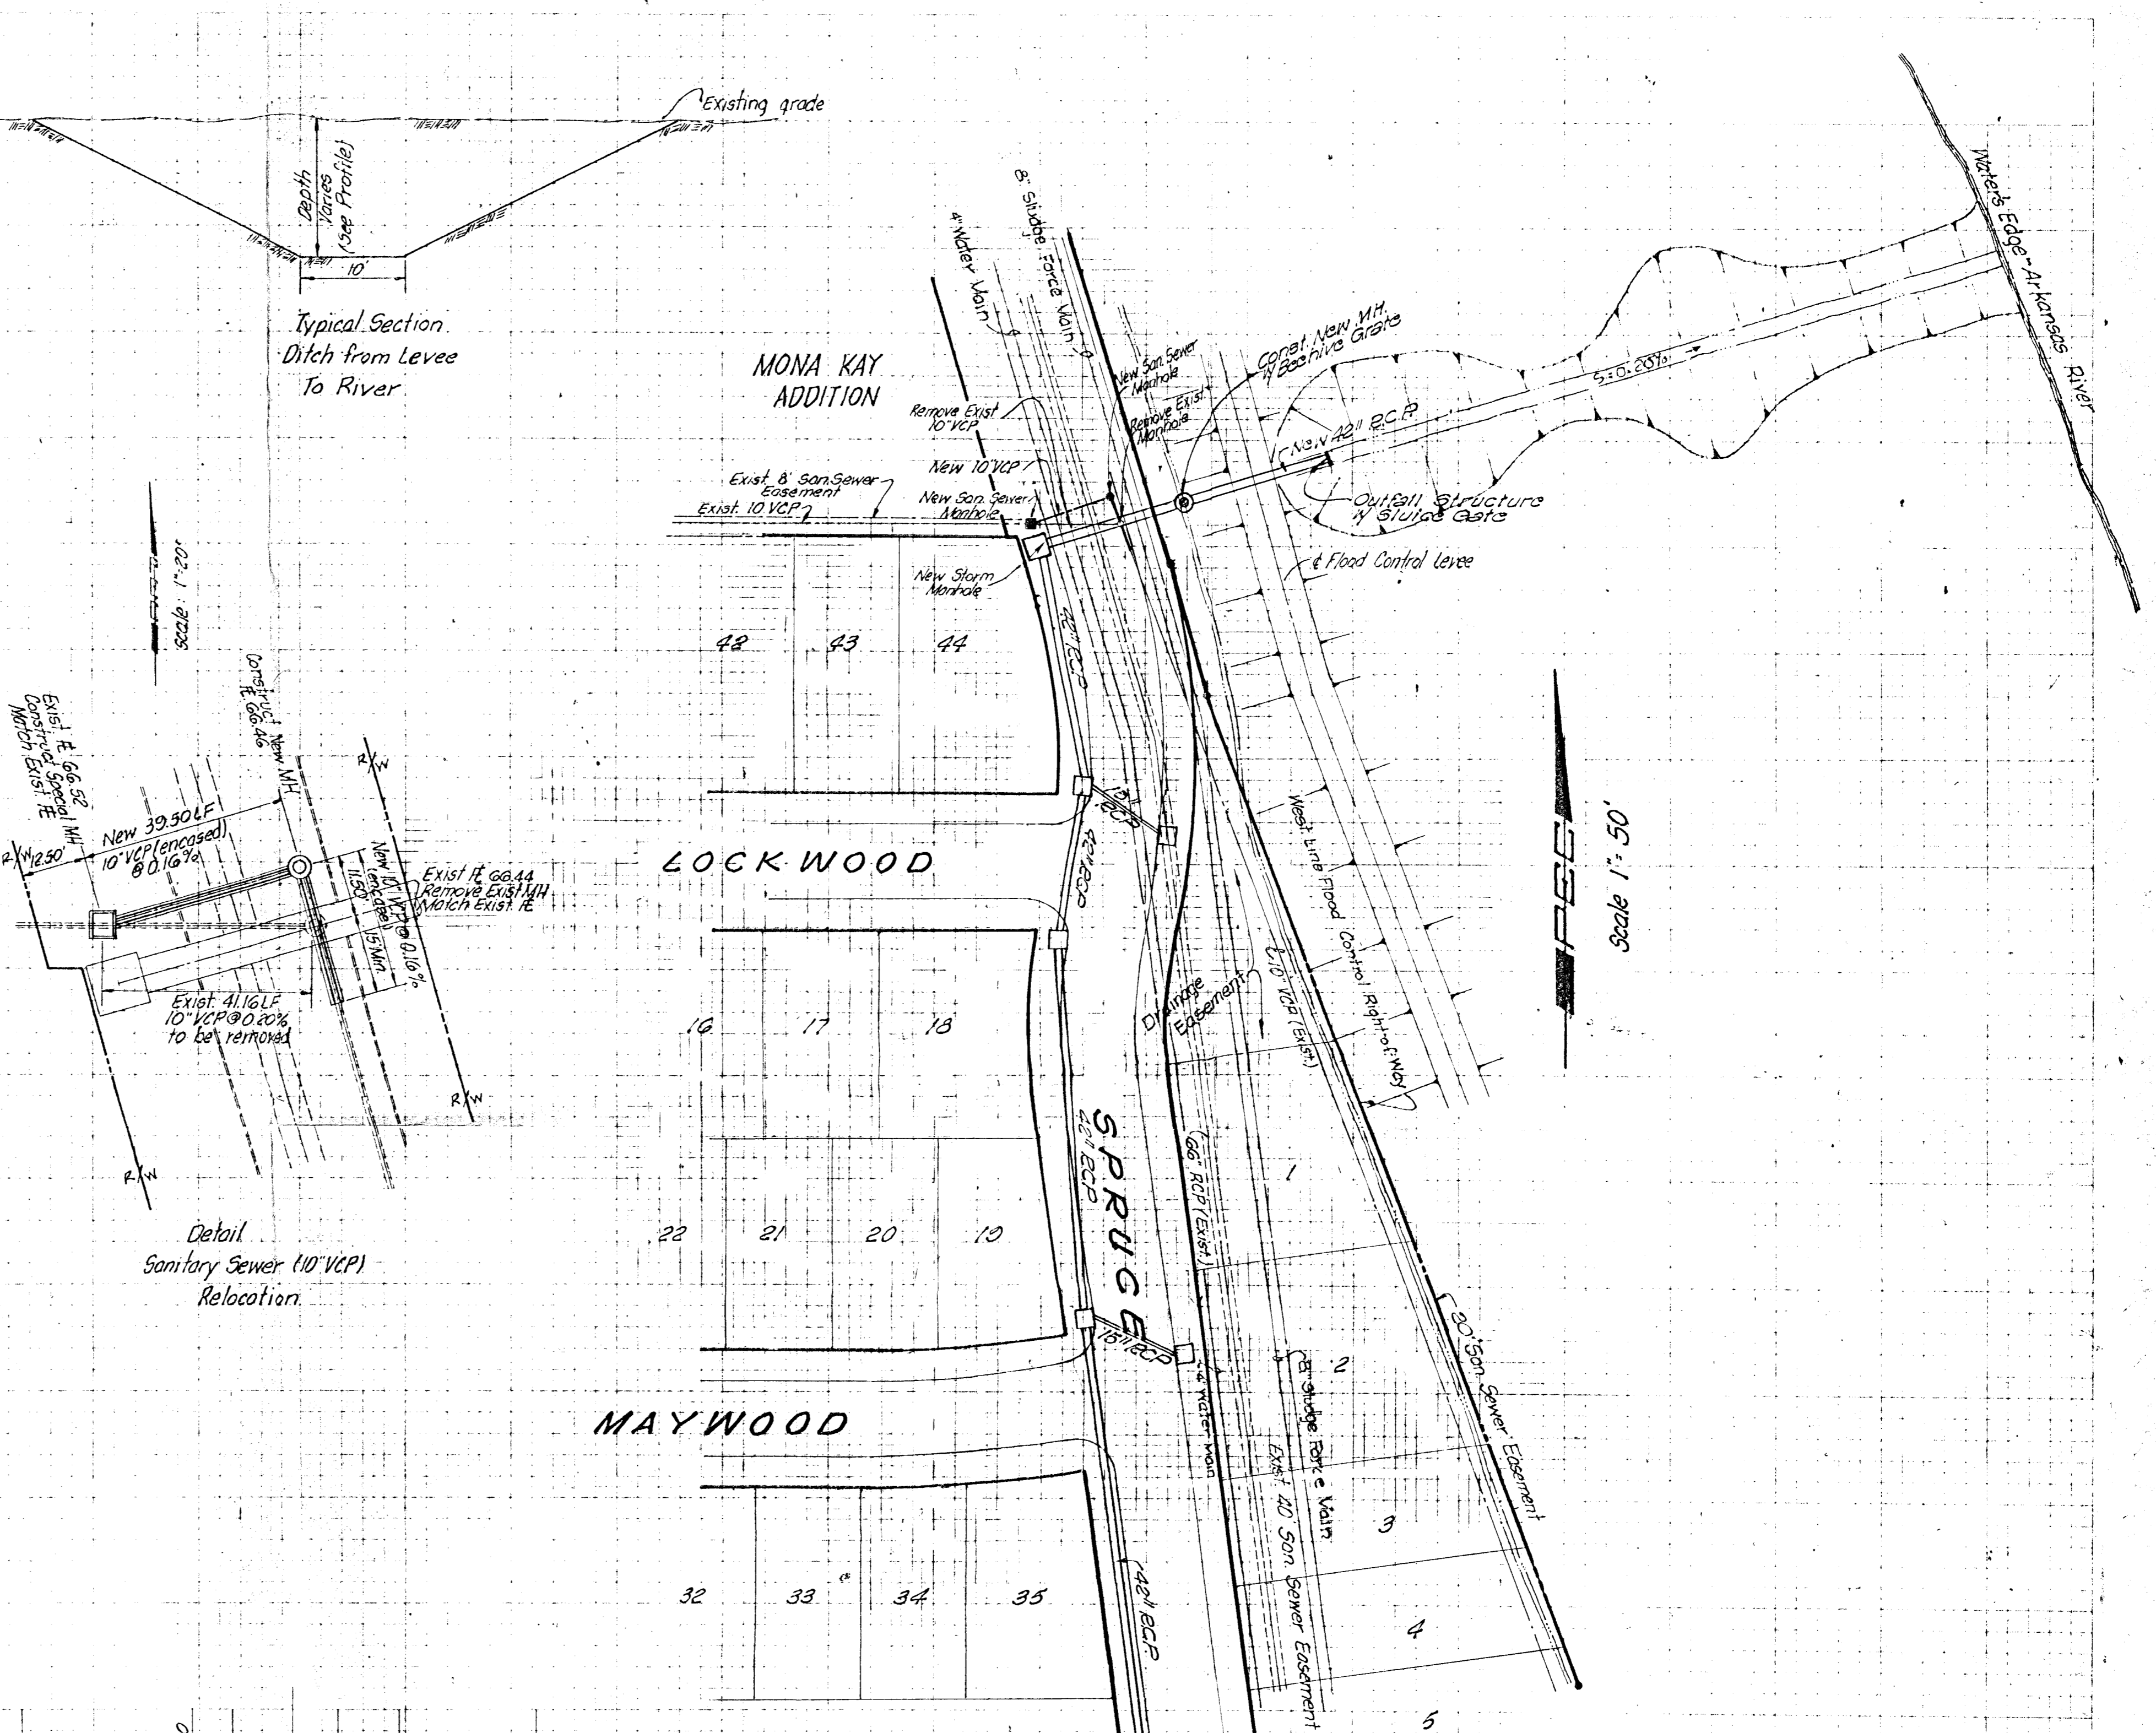

Typical Section
Ditch from Levee
To River

Detail
Sanitary Sewer (10\"/>

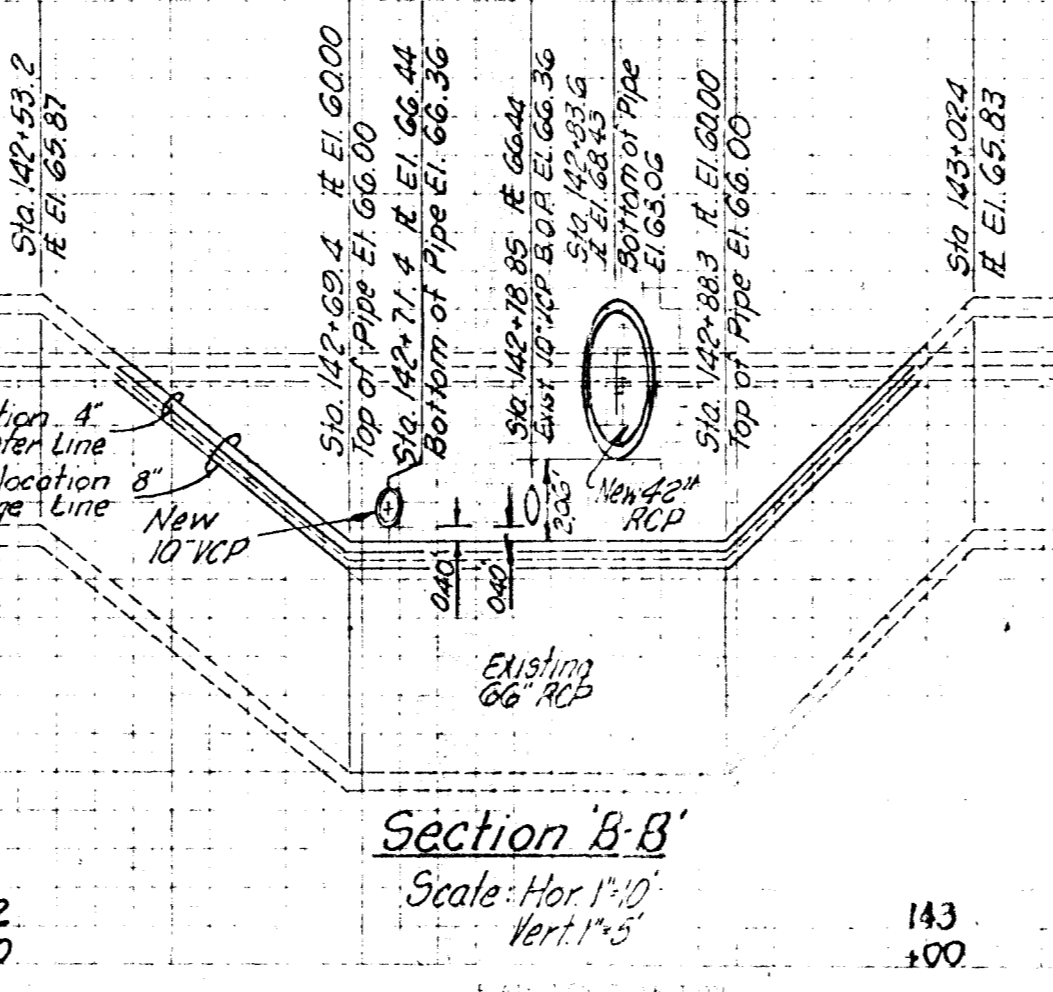

Section B-B
Scale: Hor 1/10
Vert 1/5

RIVER OAKS ADDITION

No.	Revision	By	Date
1	Corrected Addition Layout & located New MH	SCB	3/10/80
2	added detail of San Sewer relocation	Emc	1/2/80
3	added 4\"/>		

PLAN AND PROFILE SHOWING NEW
42" RCP CROSSING EXIST. 66" RCP
SIPHON

PROFESSIONAL ENGINEERING CONSULTANTS, P.A.
ENGINEERS
WICHITA, KANSAS

Designed by Brennstuhl
Drawn by SCO.17

Job No. 30-75412
Date OCT. 30, 1979

Sht. 2 of 2

